


NO 4

KIDNEY - VEIN

NO 4

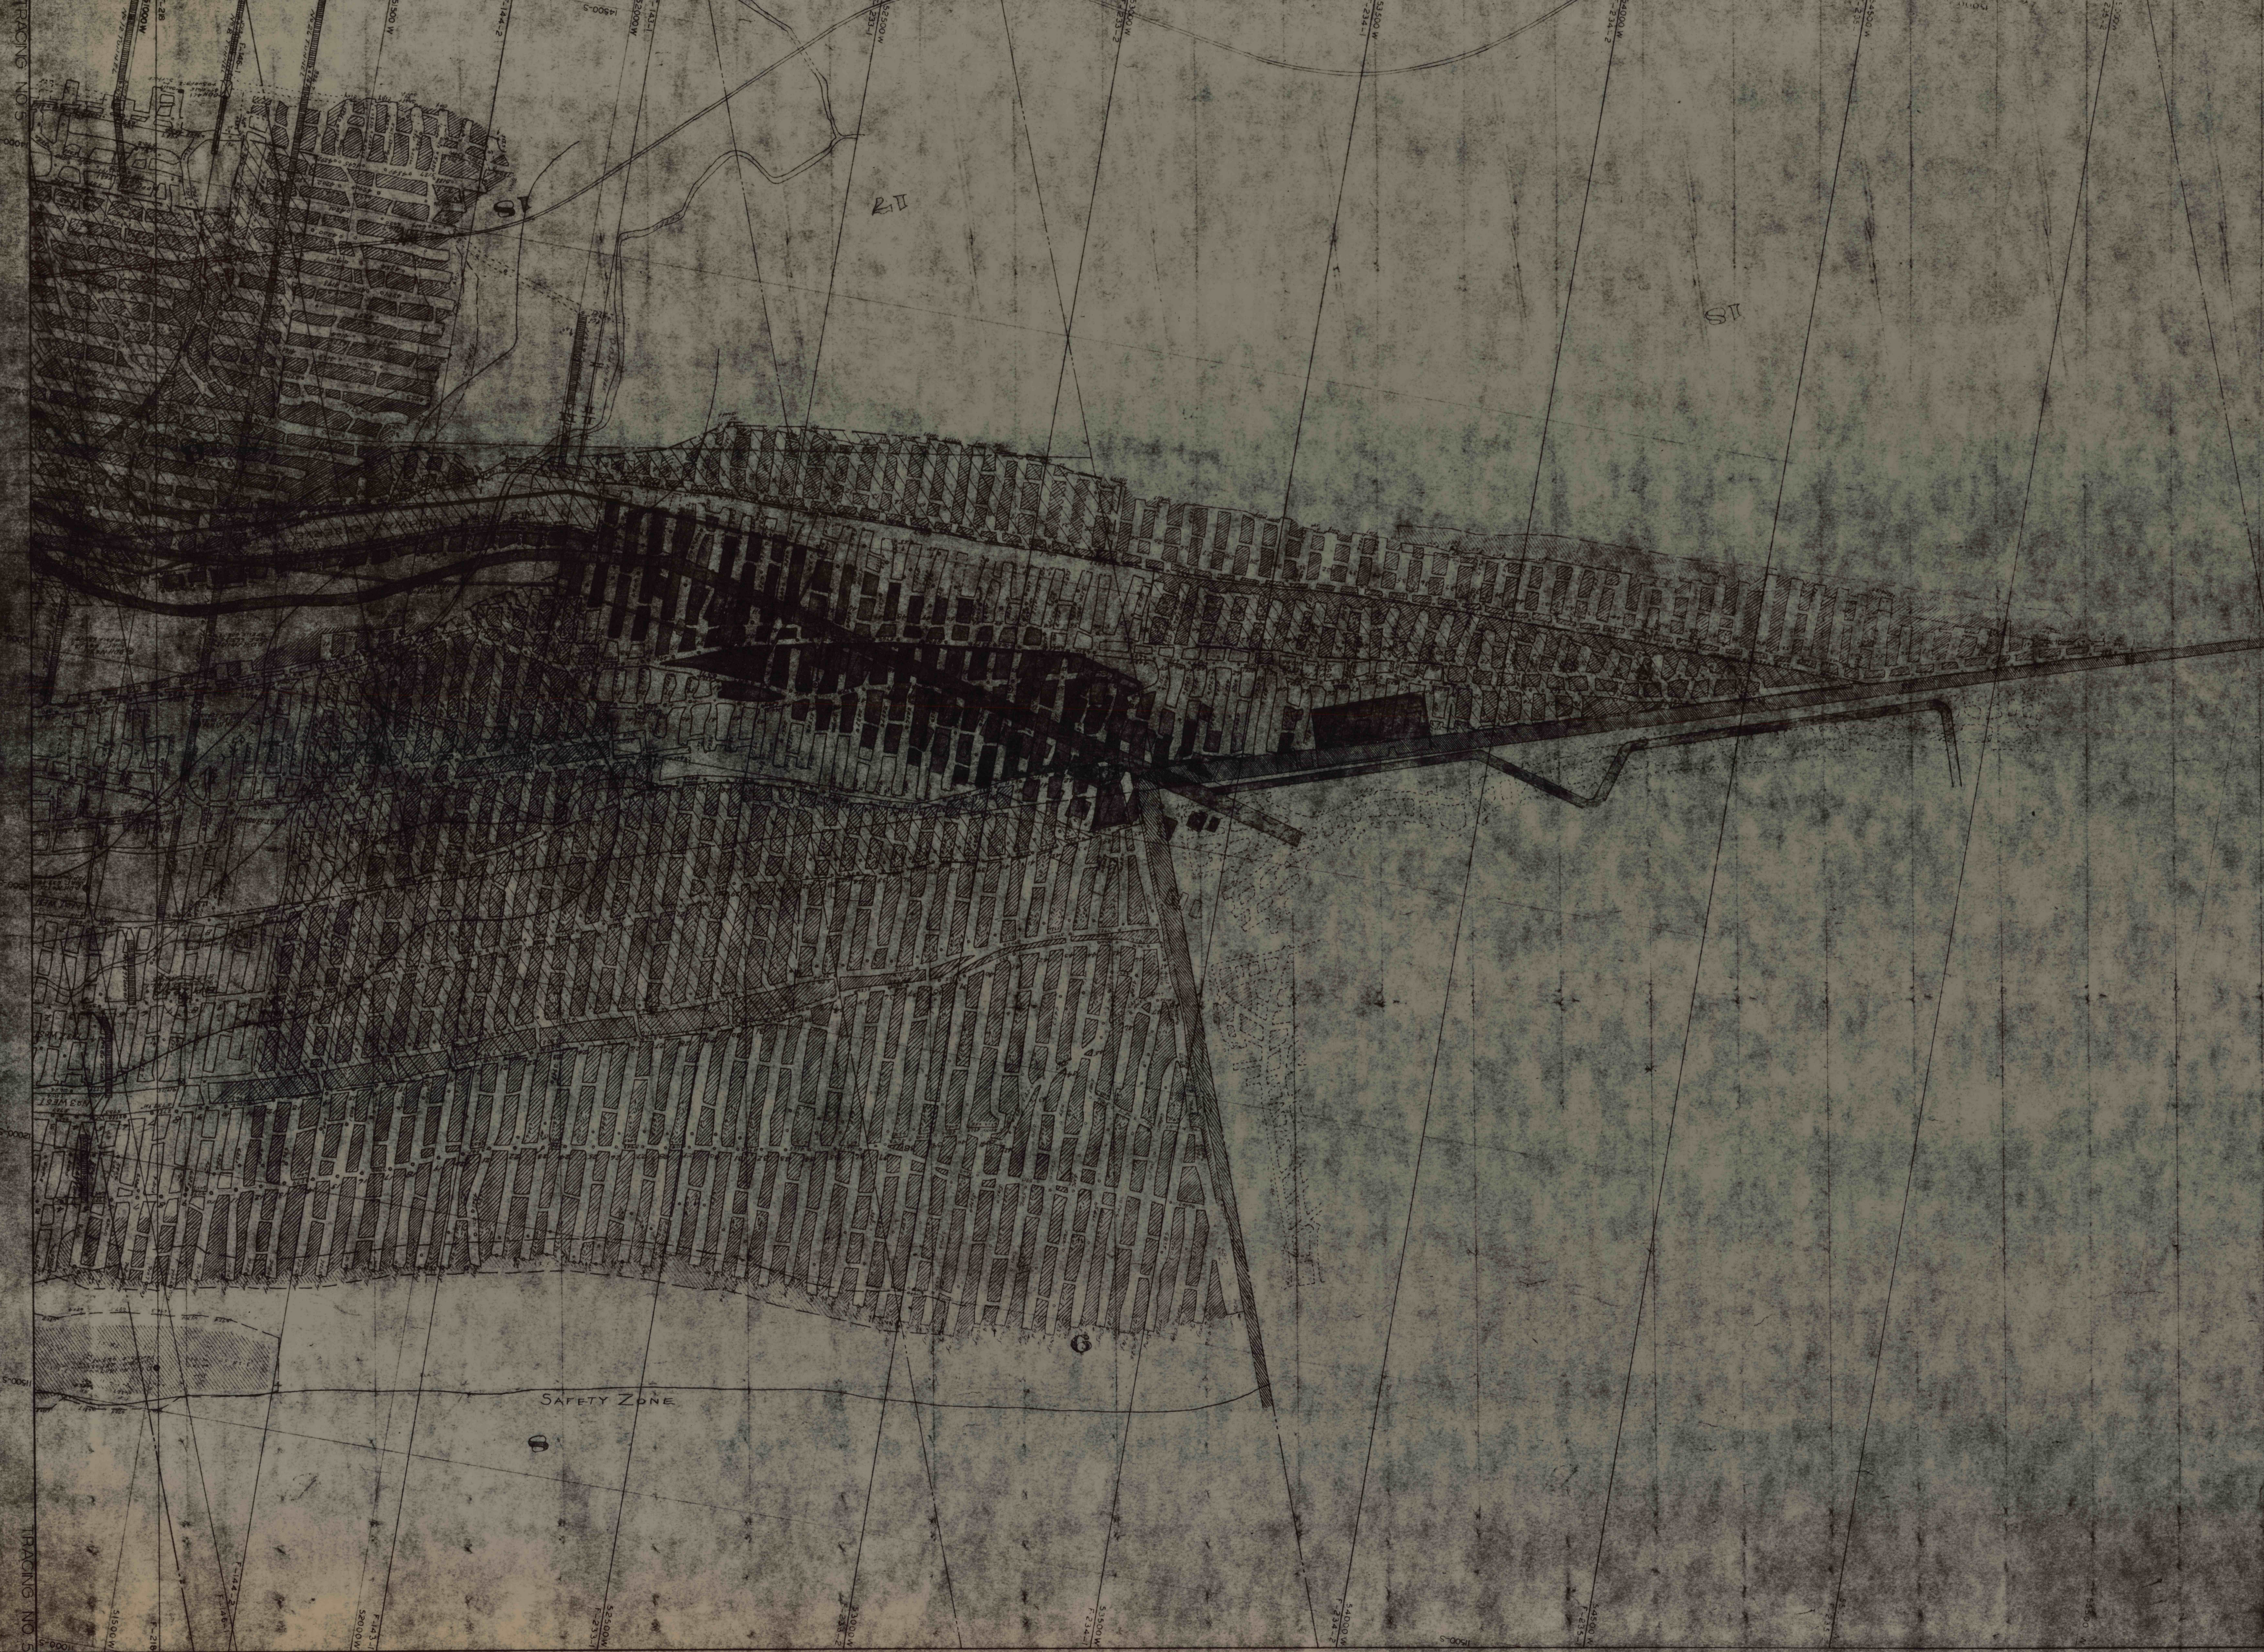

TRACING NO 5

TRACING NO 5

RT

ST

SAFETY ZONE