


FIG. 5

MIDDLE HILLMAN VEIN

FIG. 5

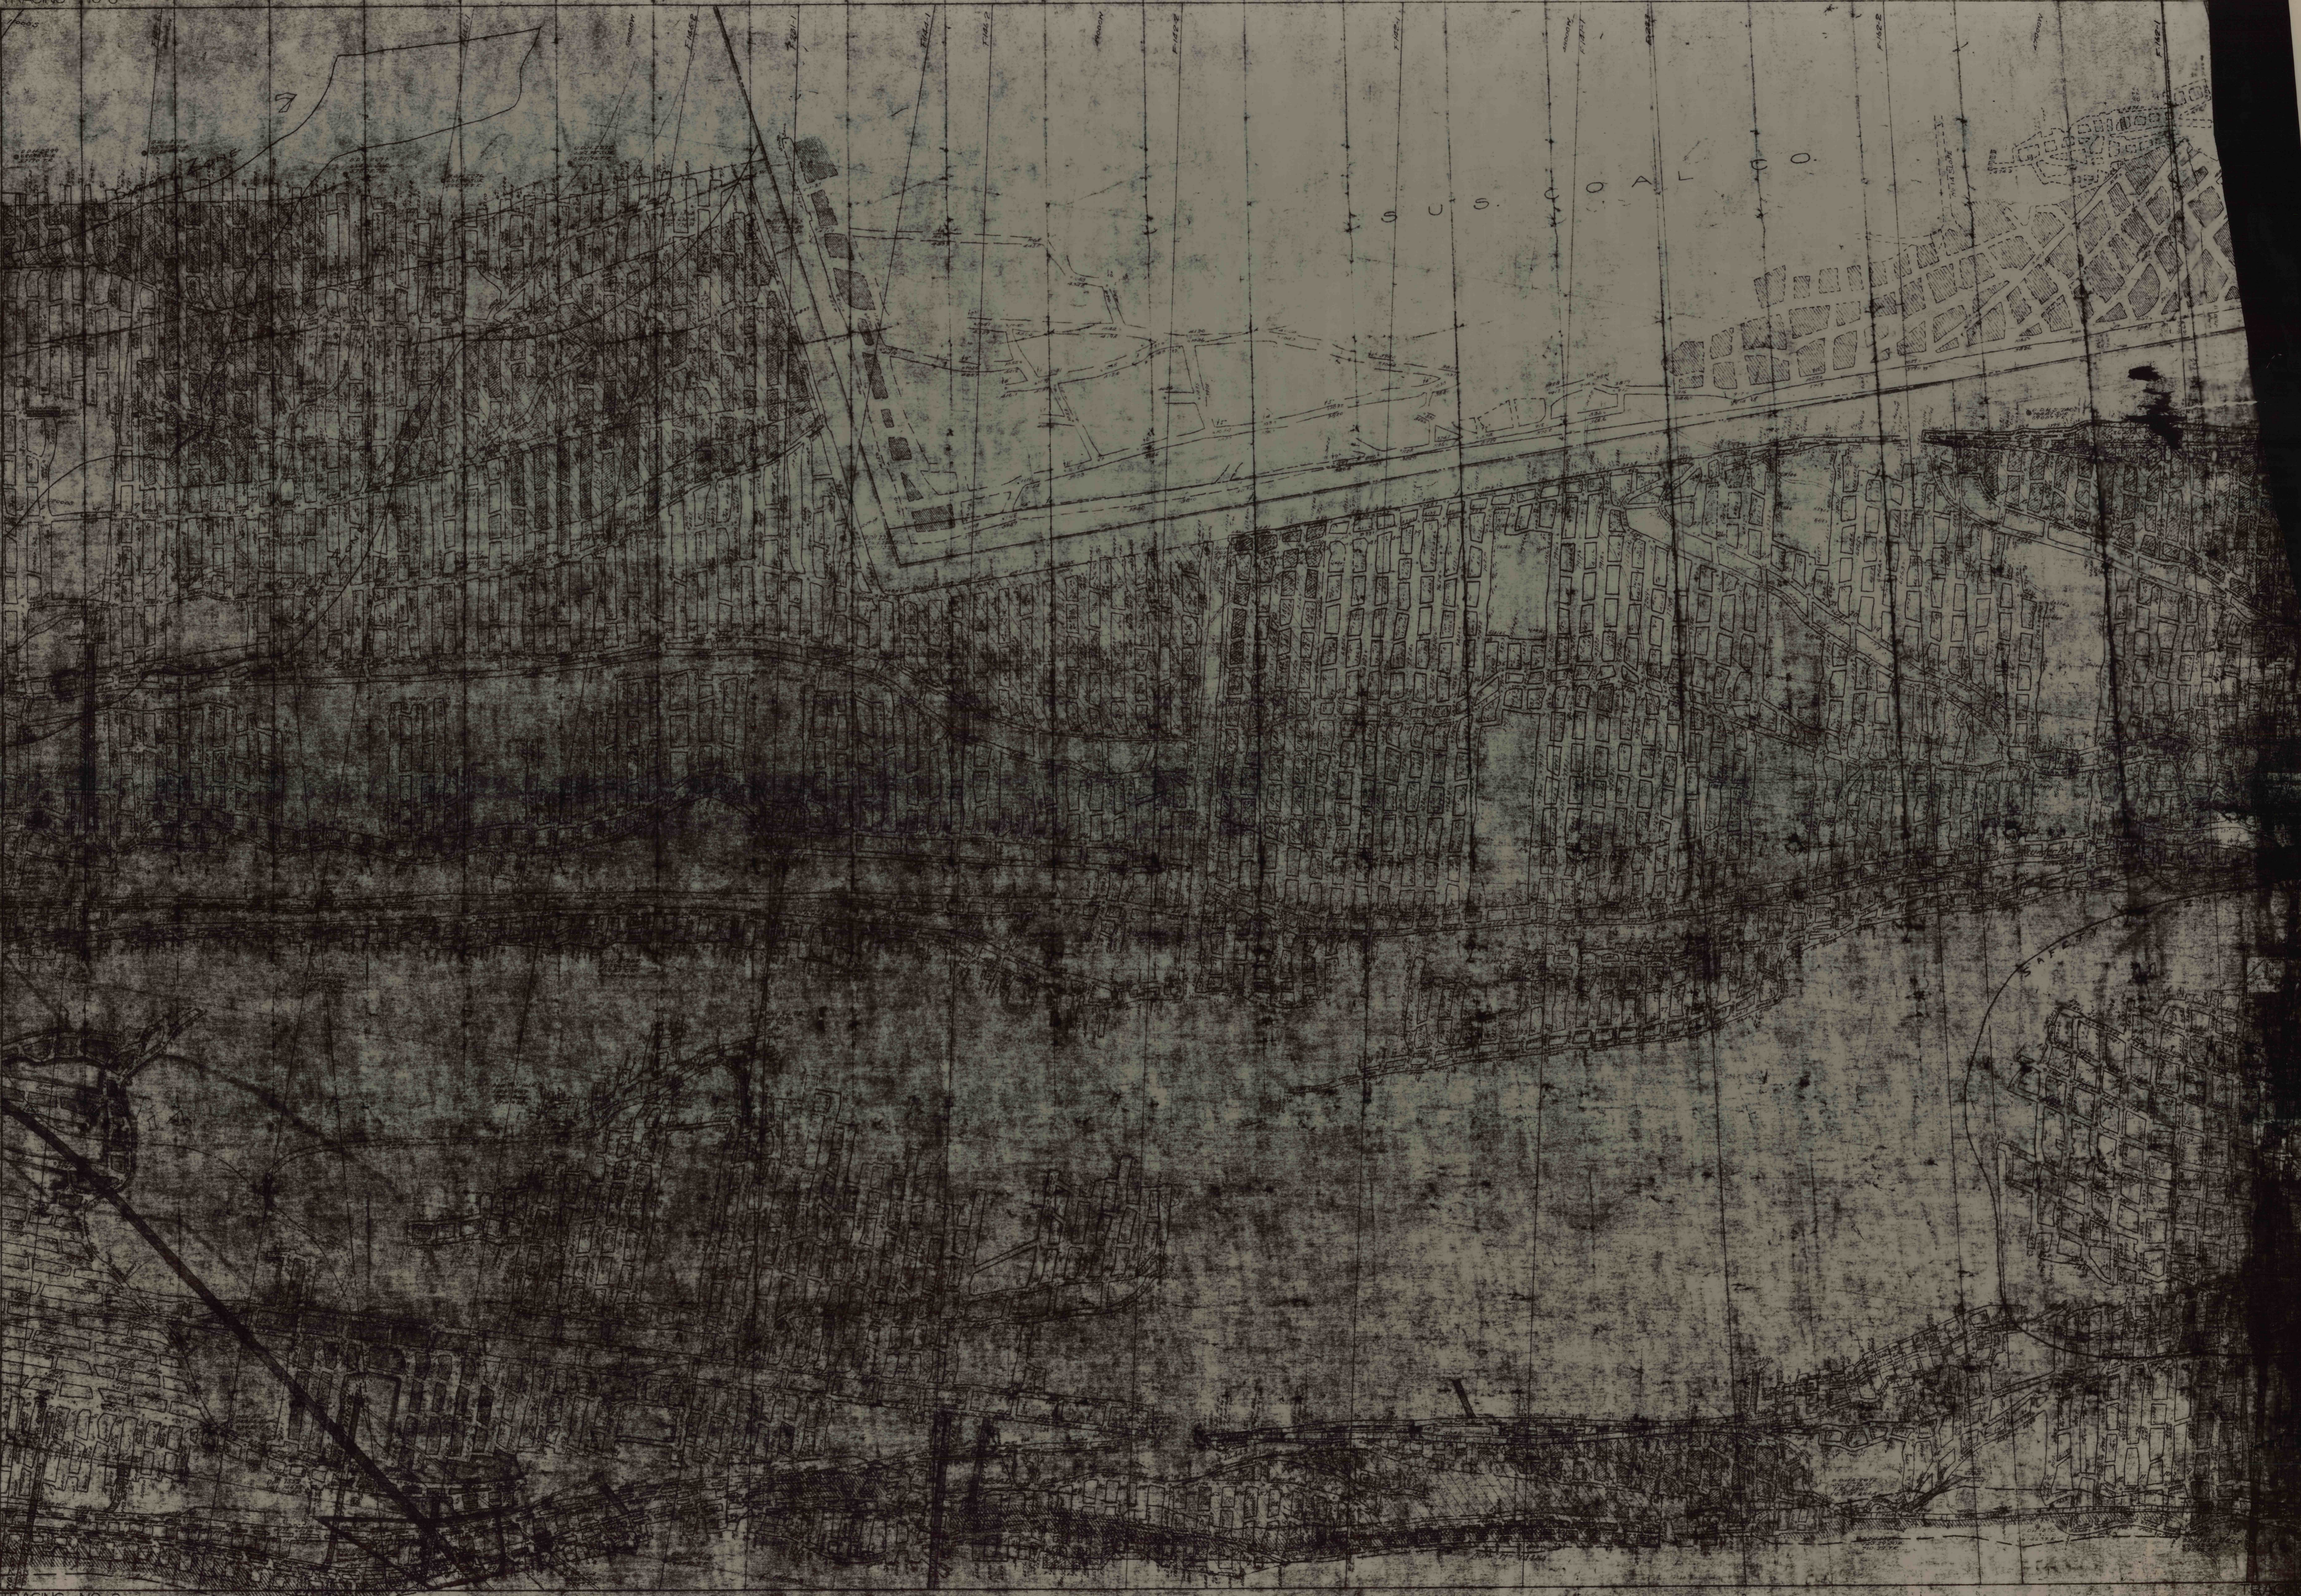

COAL

TRACING NO. 2