

01 RED 22 H2A 039 90 N° 8

N° 8

TRACING NO 17

TOP RED ASH VEIN

N° 8


TRACING NO 7

TRACING NO 11

TRACING NO 5

TRACING NO 11

TRACING NO 5

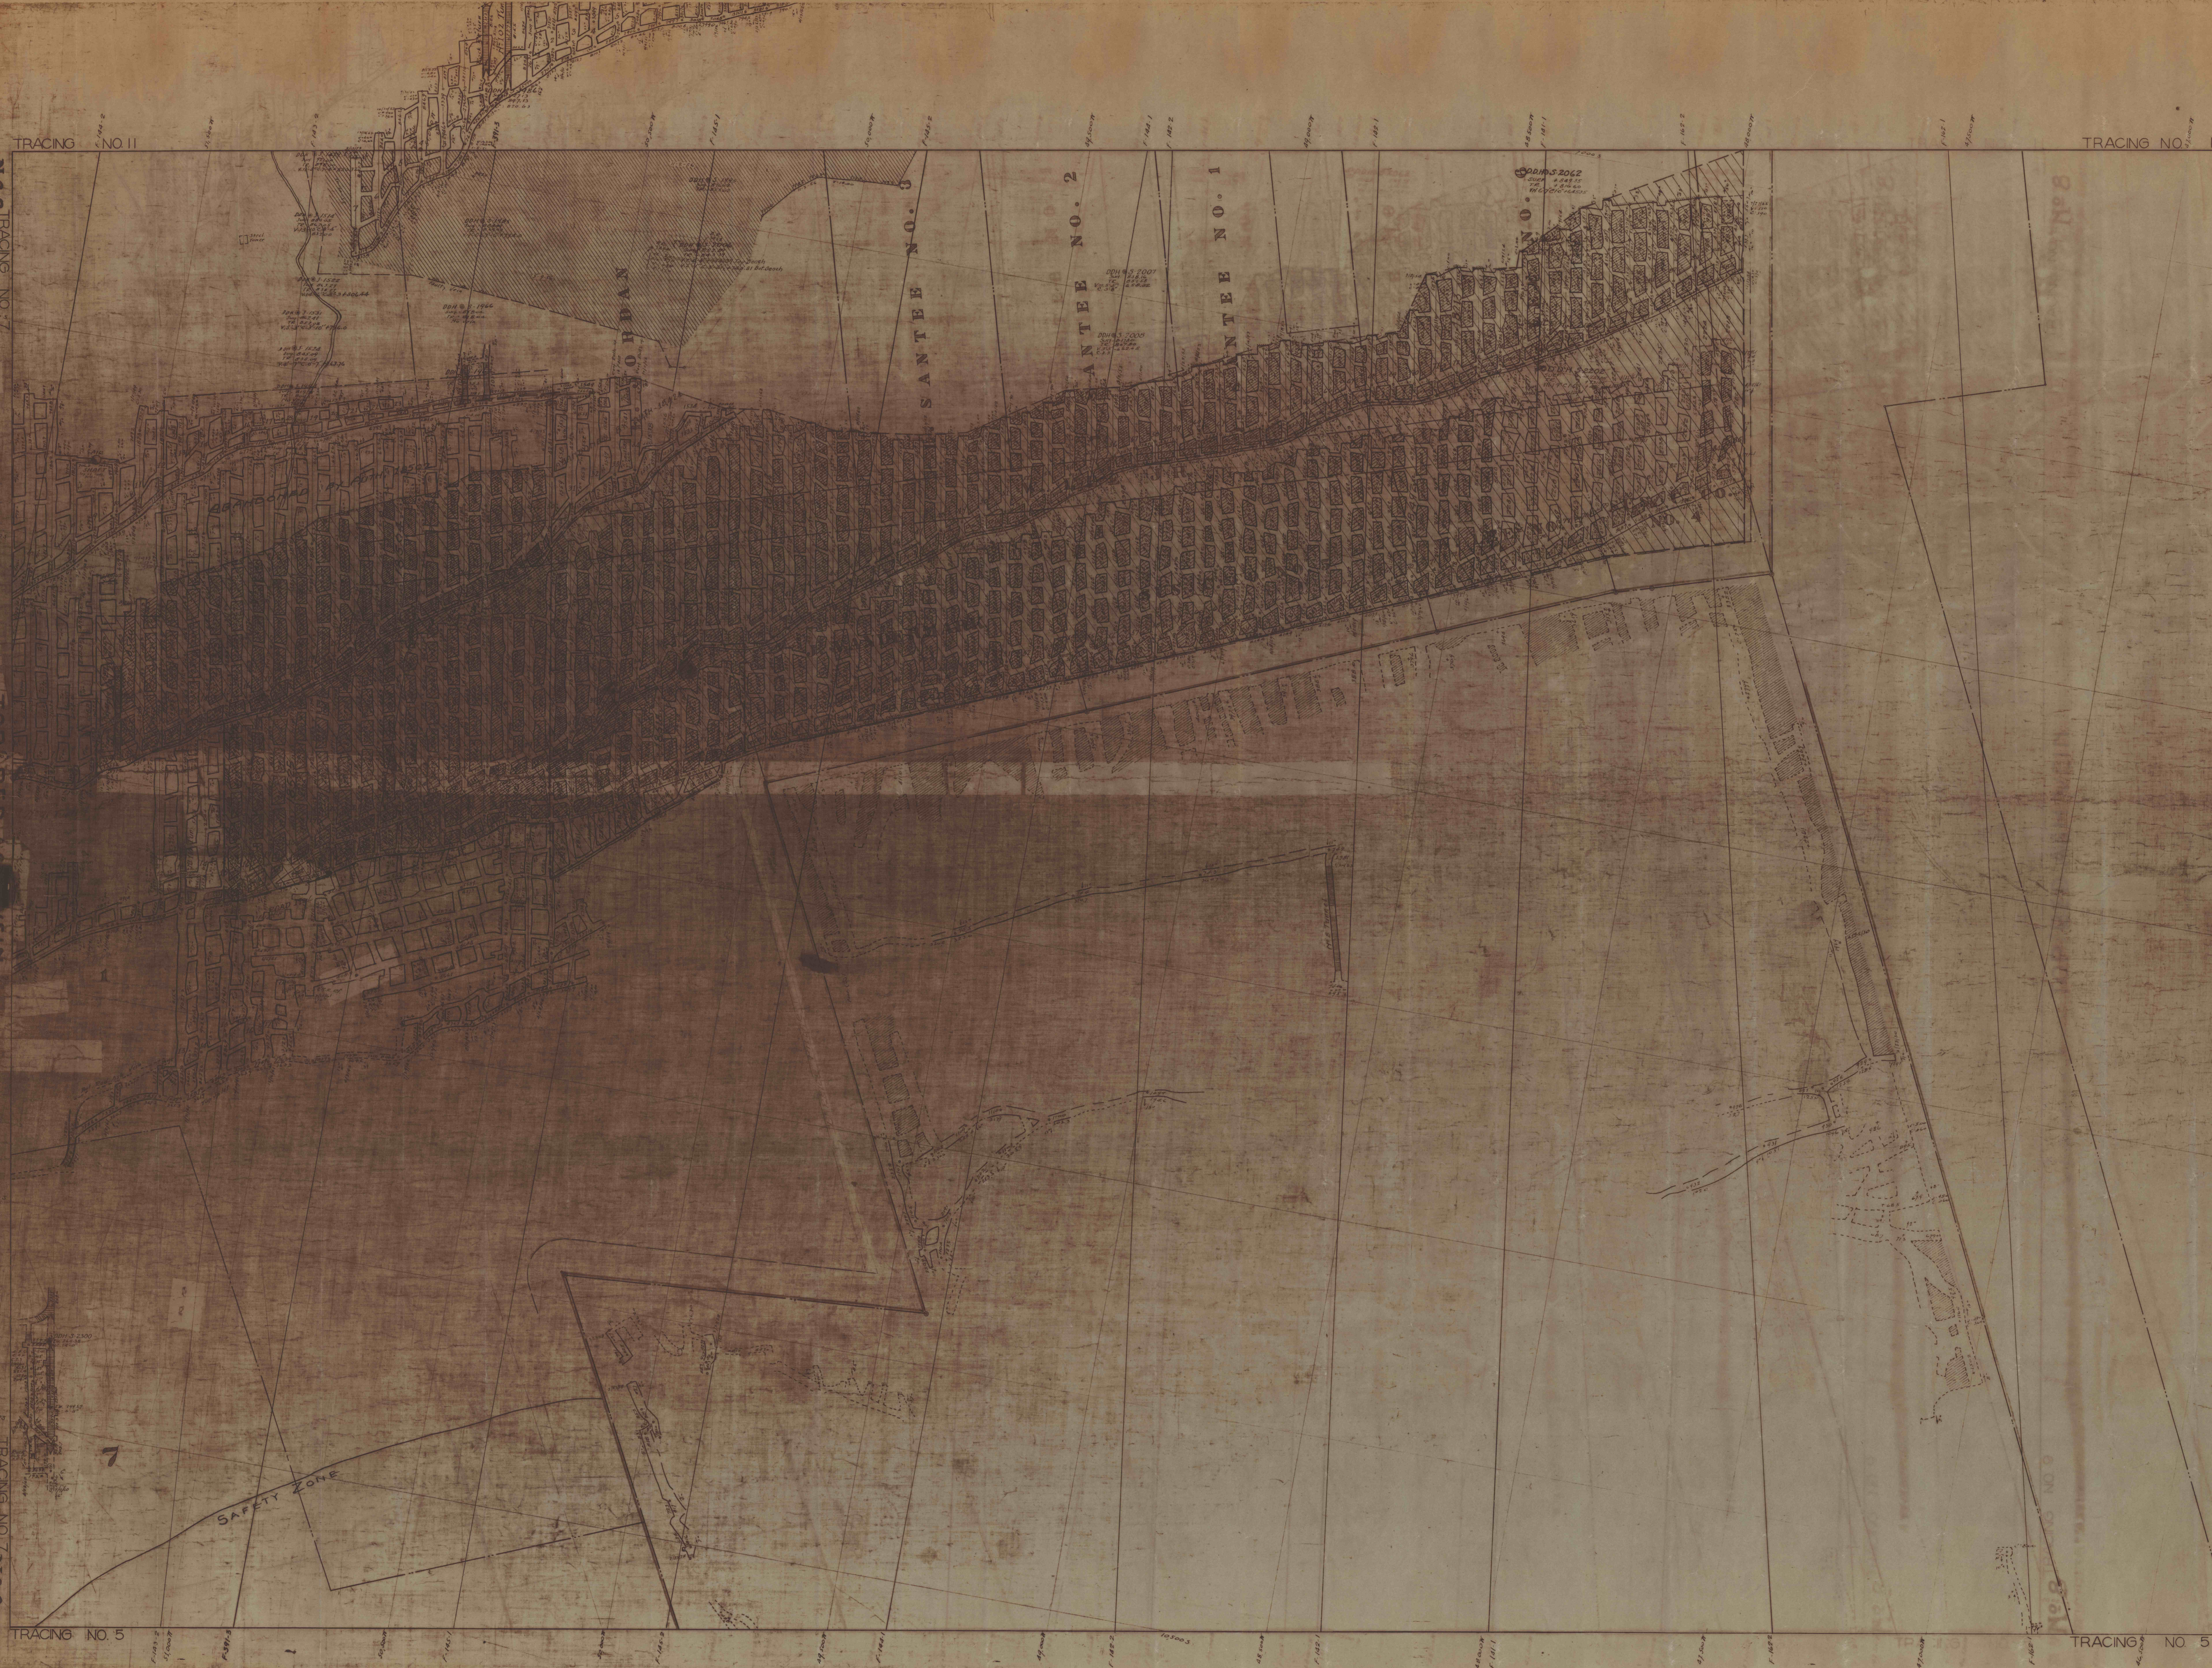

TRACING NO 9 N° 8

TOP RED ASH VEIN

TRACING NO 9

N° 8