


BOTTOM RED ASH VEIN

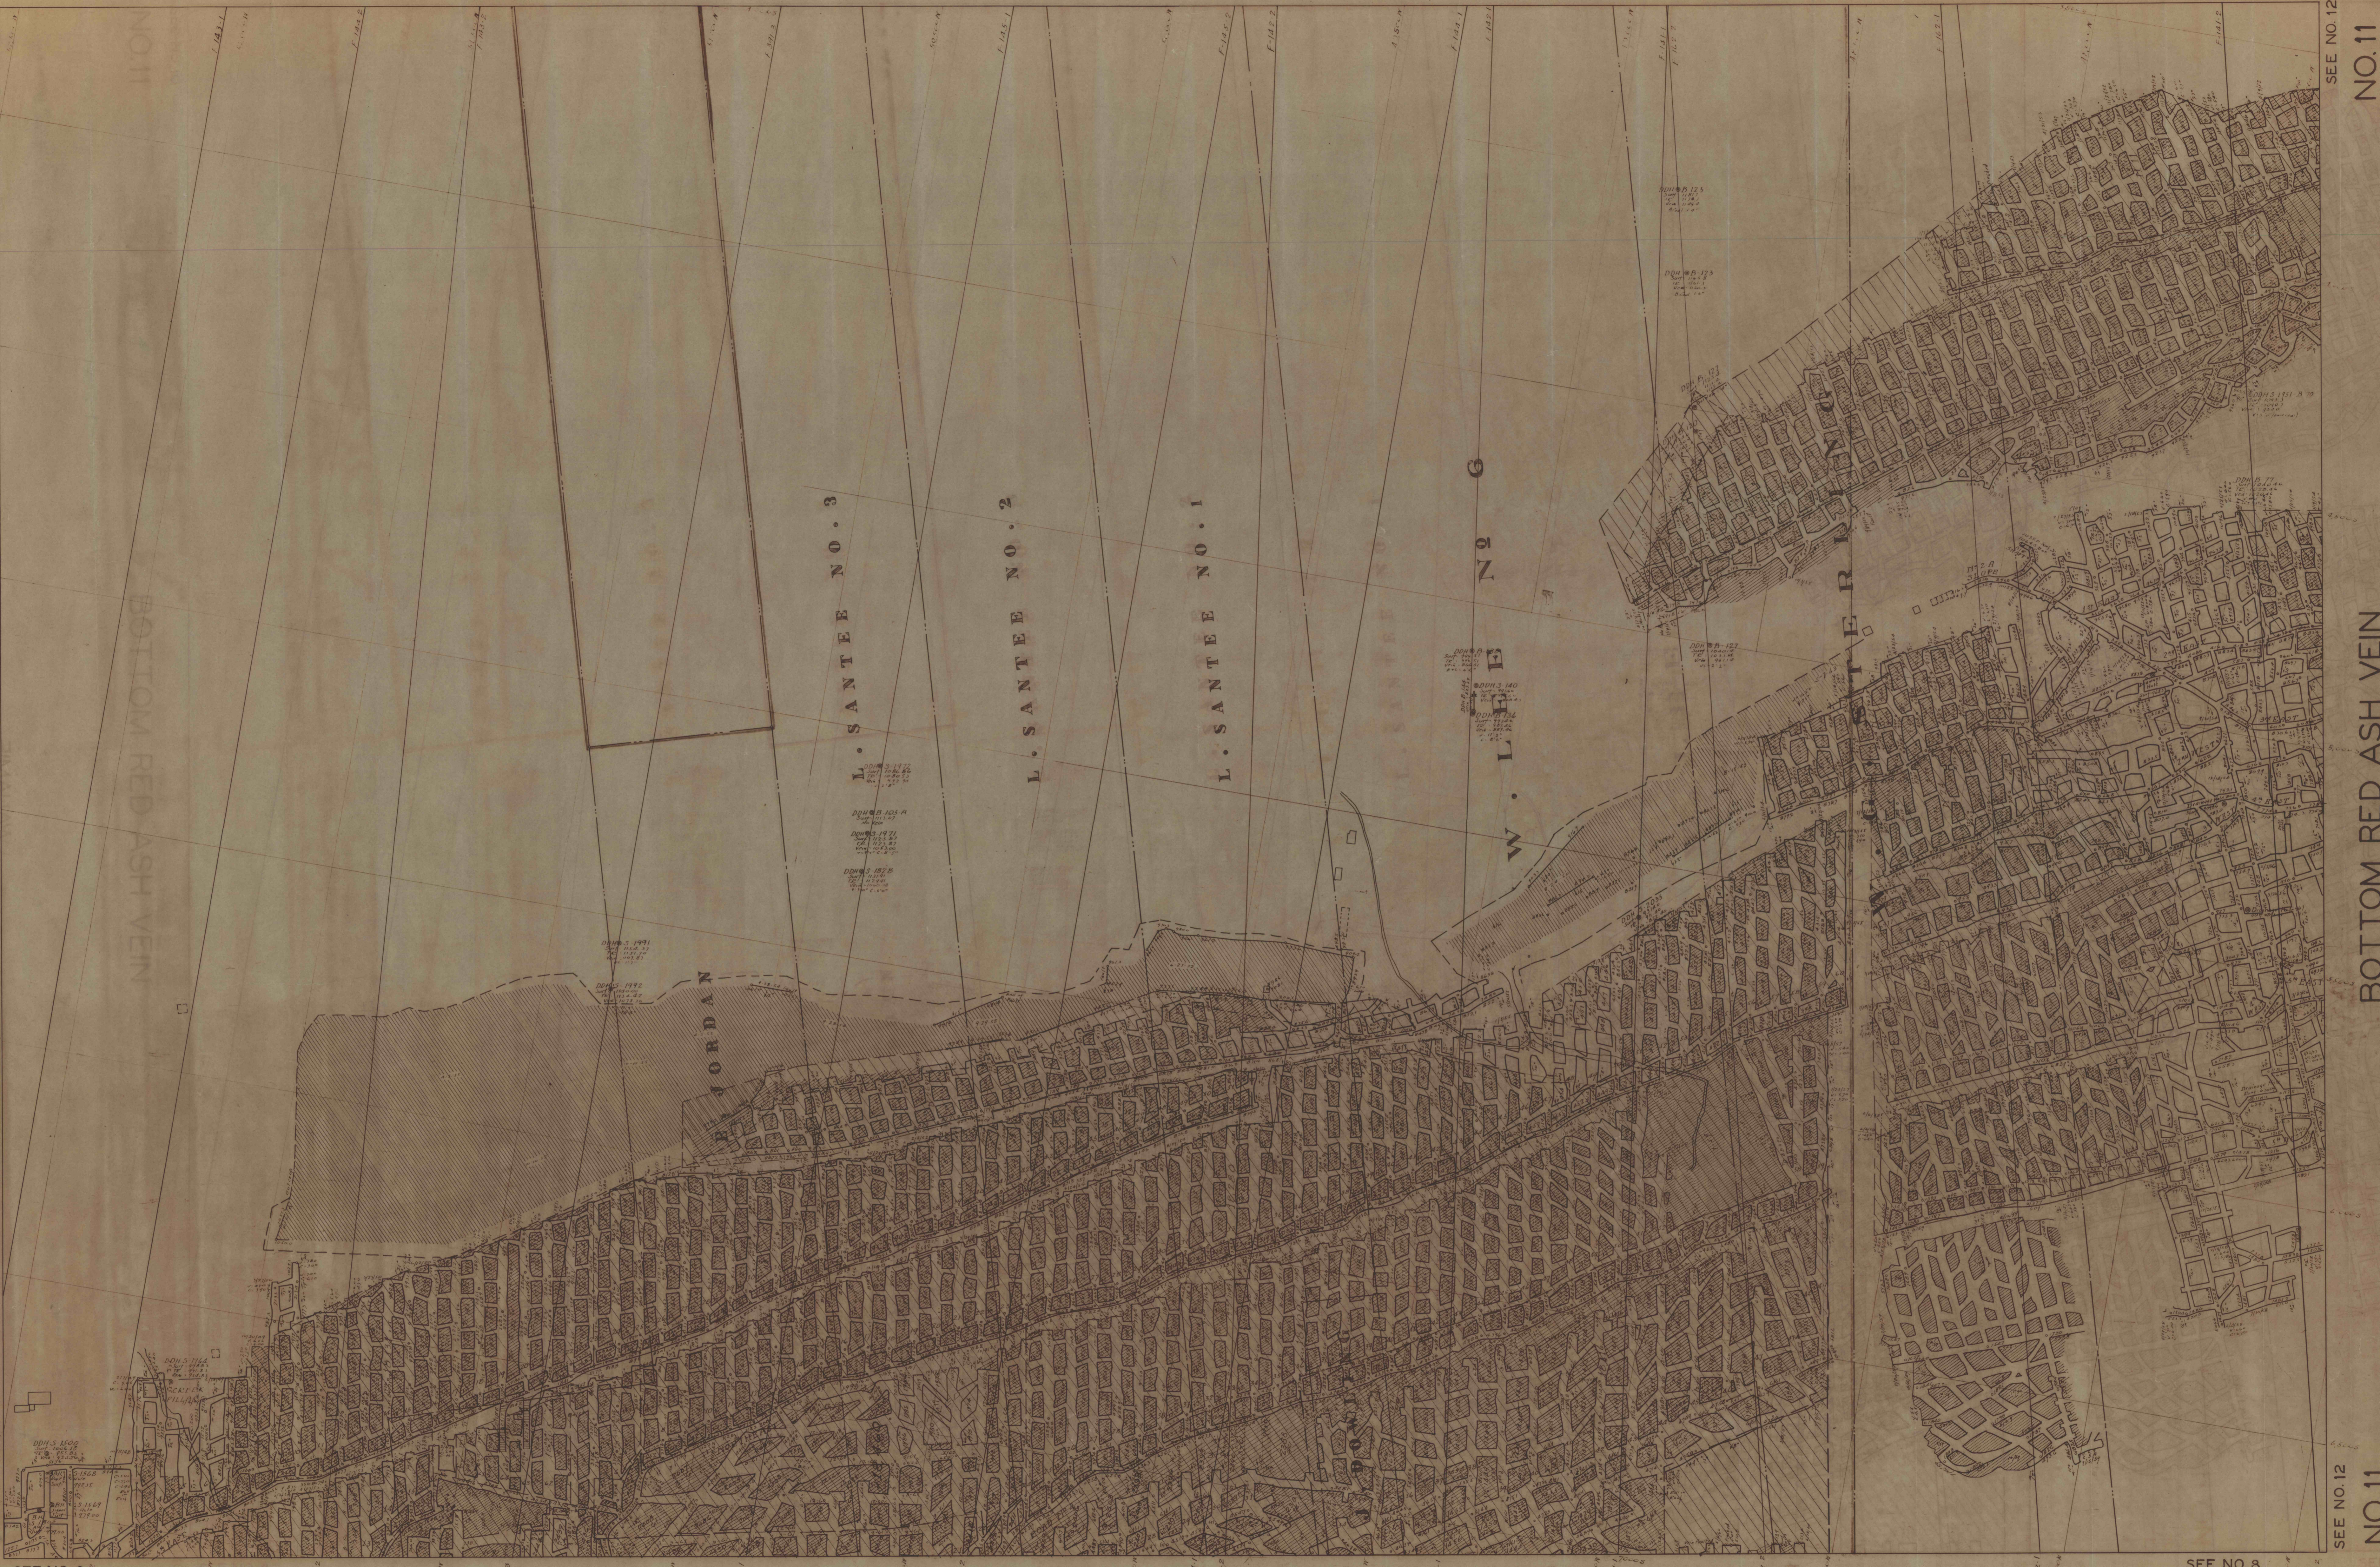

JORDAN

W. L. P. No. 6

L. SANTEE NO. 3

L. SANTEE NO. 2

L. SANTEE NO. 1

SEE NO. 8

SEE NO. 12

NO. 11

BOTTOM RED ASH VEIN

SEE NO. 12

NO. 11