



Q-5-B-5

Q-5-B-2

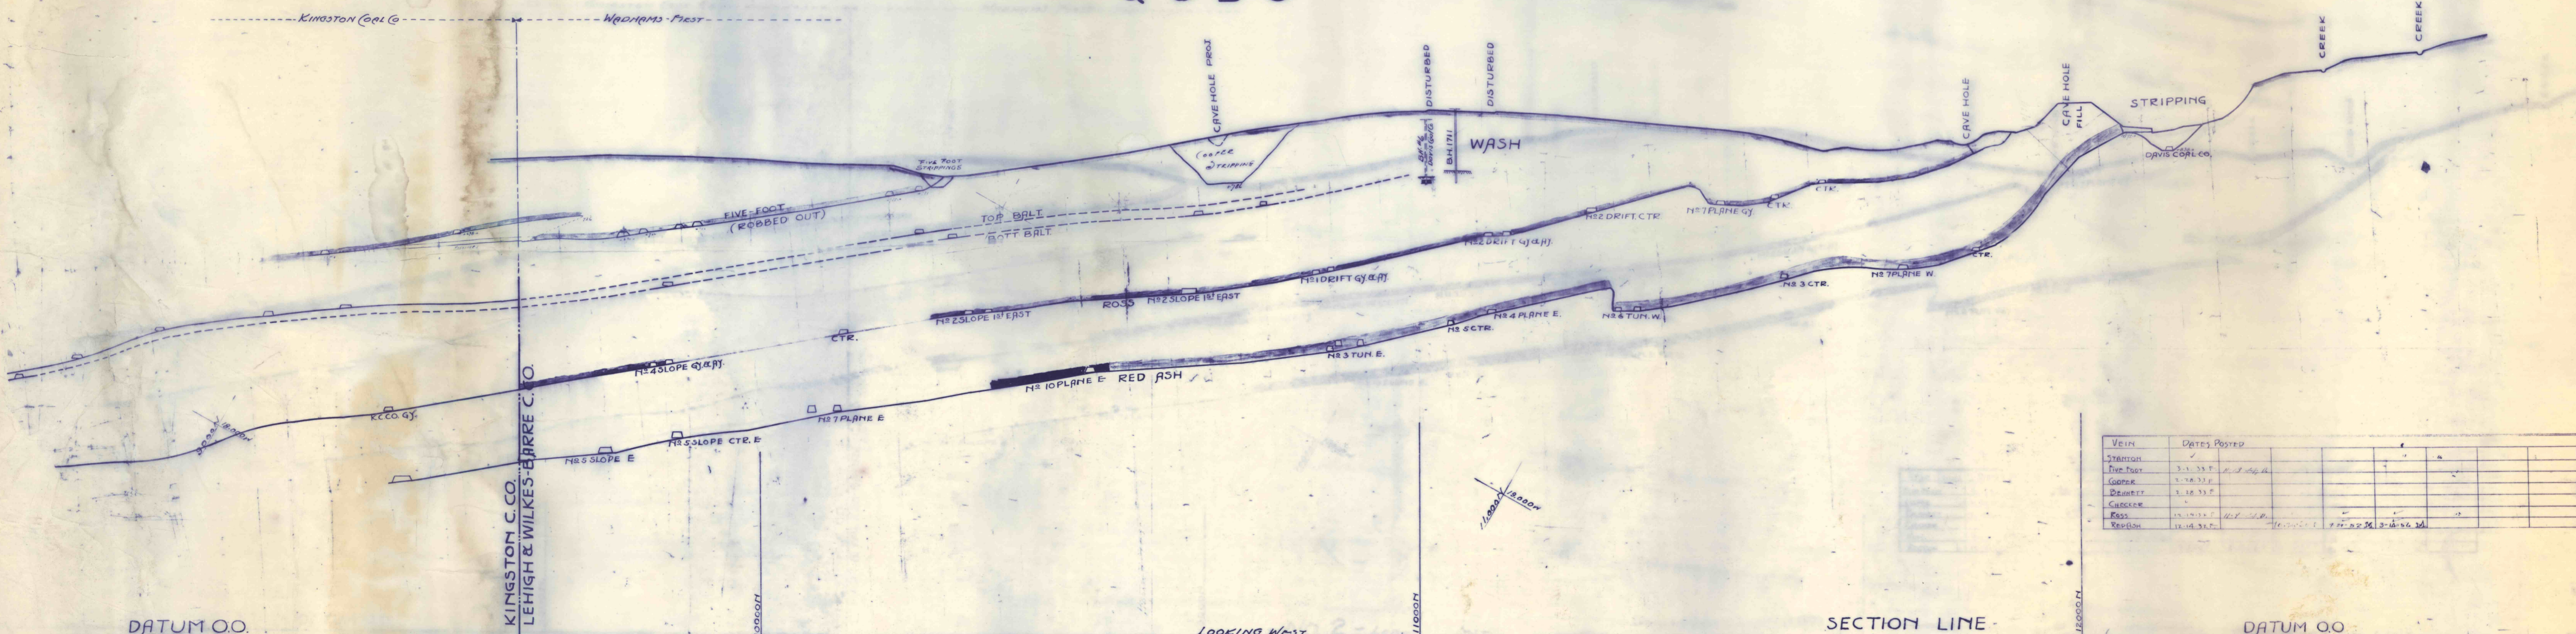

CROSS SECTION F-335 Nº1

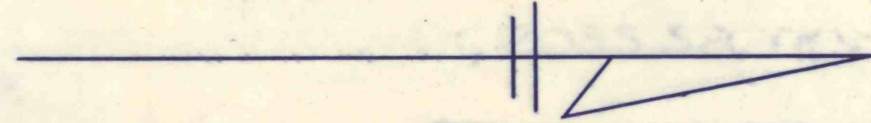

VEIN	DATES POSTED
STATION	
FIVE FOOT	3-1-33 F. 11-1-34 A.
COOPER	2-18-33 F.
BEAURET	3-18-33 F.
CARROLL	
ROSS	12-14-34 F. 11-1-34 A. 1-1-35 B. 3-1-35 C.
REDBOX	