



# Q-5-B-5

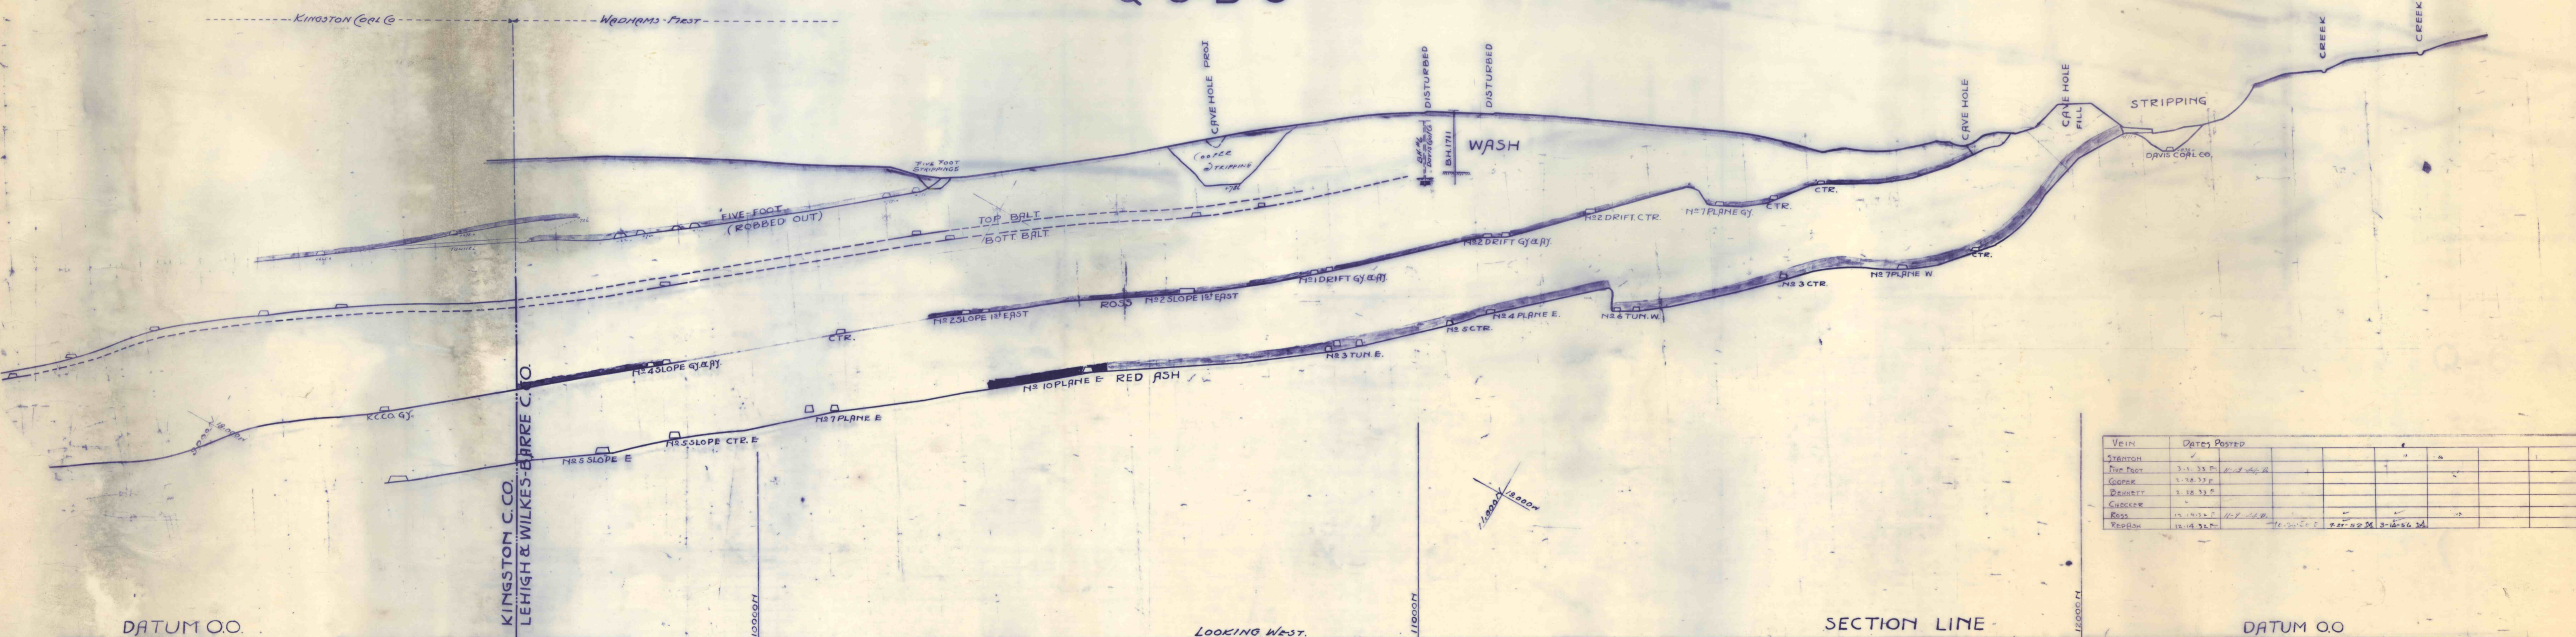

VEIN	DATE POSTED
STANTON	
FIVE FOOT	3-1-33
GOOPER	3-14-33
BRUNETT	3-14-33
CHADLER	
ROSS	12-1-33
REDDISH	12-14-33

CROSS SECTION F-335 N#1

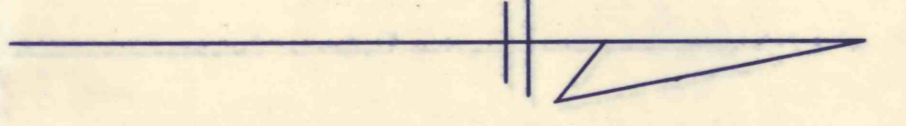

LOOKING WEST.

SECTION LINE

DATUM 00.

DATUM 00

KINGSTON C. CO.  
LEHIGH & WILKES-BARRE C. CO.

KINGSTON COAL CO.

WADSWORTH FIRST

1:2000 1:8000

1:2000 1:8000

1:2000 1:8000