

E-332-S Q-2-B-S

E-332-S Q-2-B-S

E-332-S Q-2-B-S

E-332-S Q-2-B-S

Q-5-B-5


Q-5-B-2

KINGSTON Coal Co. WADSWORTH FIRST

KINGSTON C. CO. LEHIGH & WILKES-BARRE C. CO.

- NO. 2 - LOOKING WEST

CROSS SECTION F-335 No 2

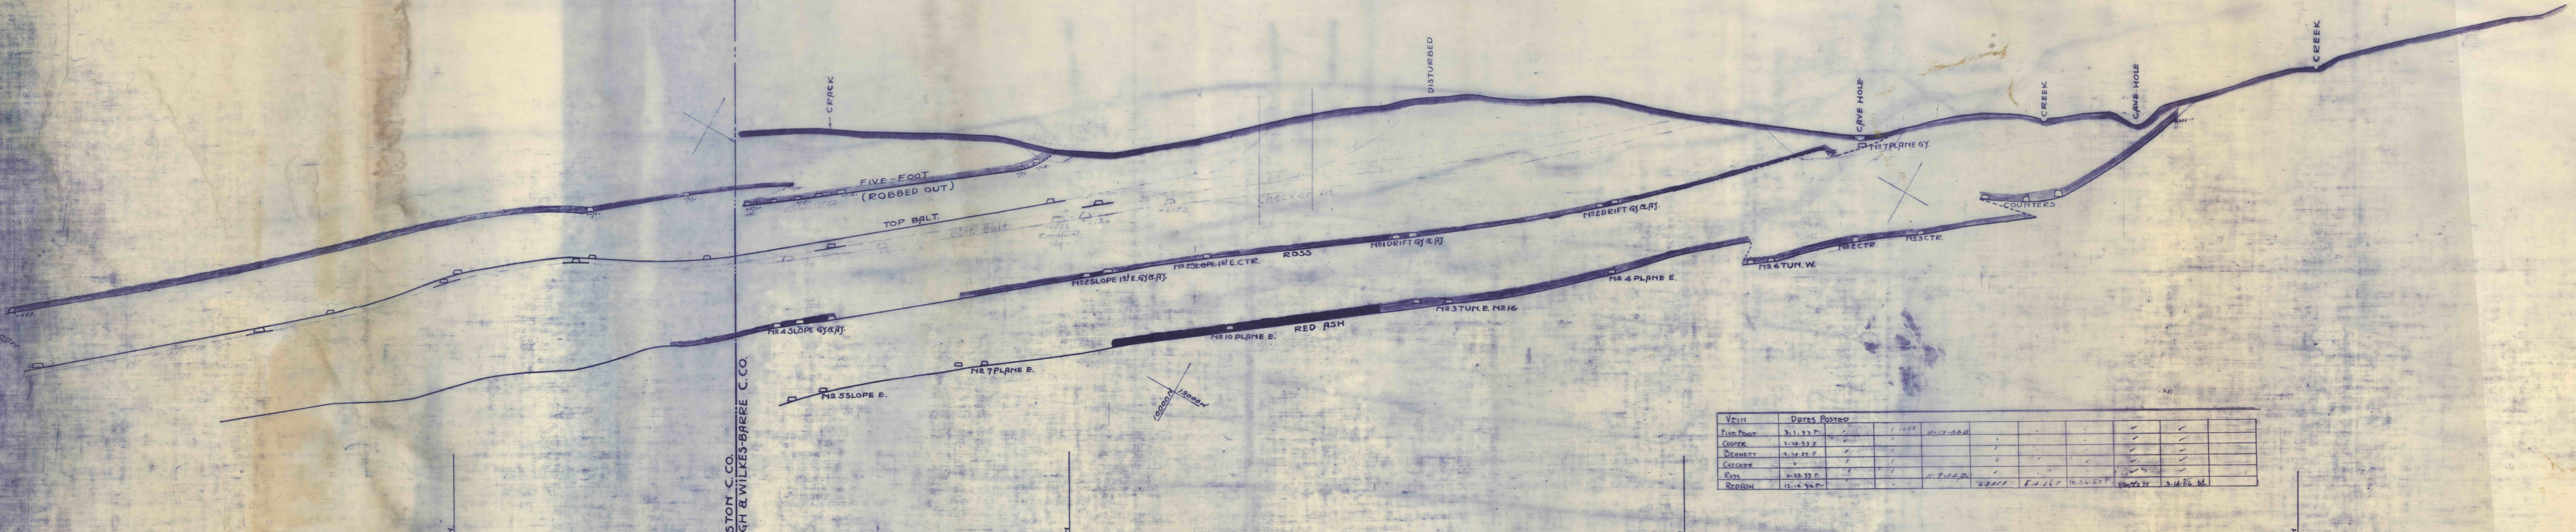

Vein	Dates Posted								
FIVE FOOT	3.1.33 P.								
COOPER	3.24.33 P.								
DIANEY	3.27.33 P.								
CLIFTON	4								
ROSS	3.28.33 P.								
RED ASH	12.14.32 P.								

Q-2-B-2