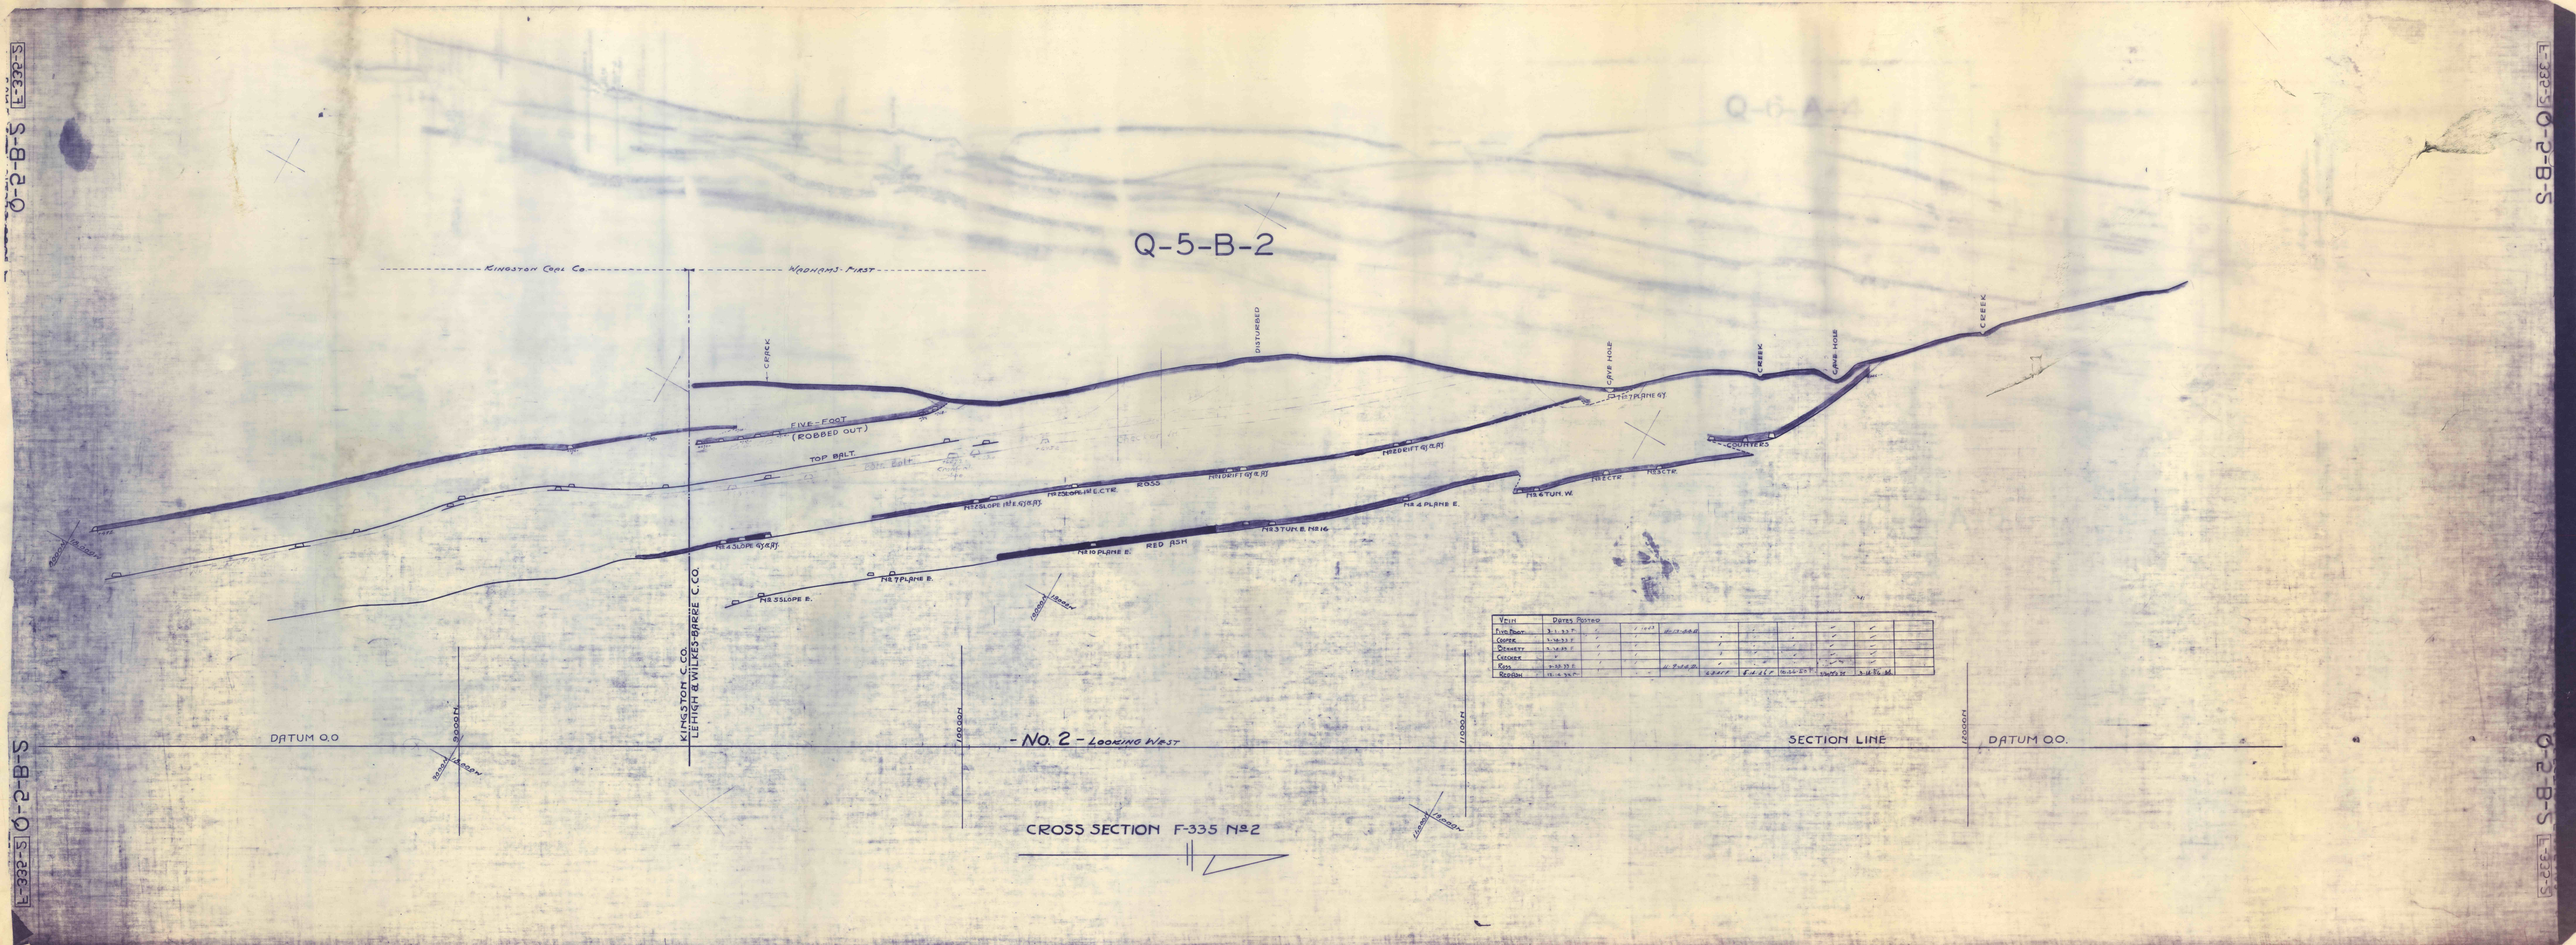
Q-5-B-2
Kingston Coal Co.
Wadhams First
Crack
Disturbed
Cave Hole
Creek
Cave Hole
Creek
Five-Foot
(Robbed Out)
Top Balt
Ross
Red Ash
Counters
Kingston C.Co.
Lehigh & Wilkes-Barre C.Co.
Datum 0.0
- No. 2 - Looking West
Section Line
Datum 0.0.
Cross Section F-335 No 2
Q-2-B-S
E-332-S