


MARY T CLARK 4-397

# WADHAMS FIRST 360

REYNOLDS No 16 TOP BALT

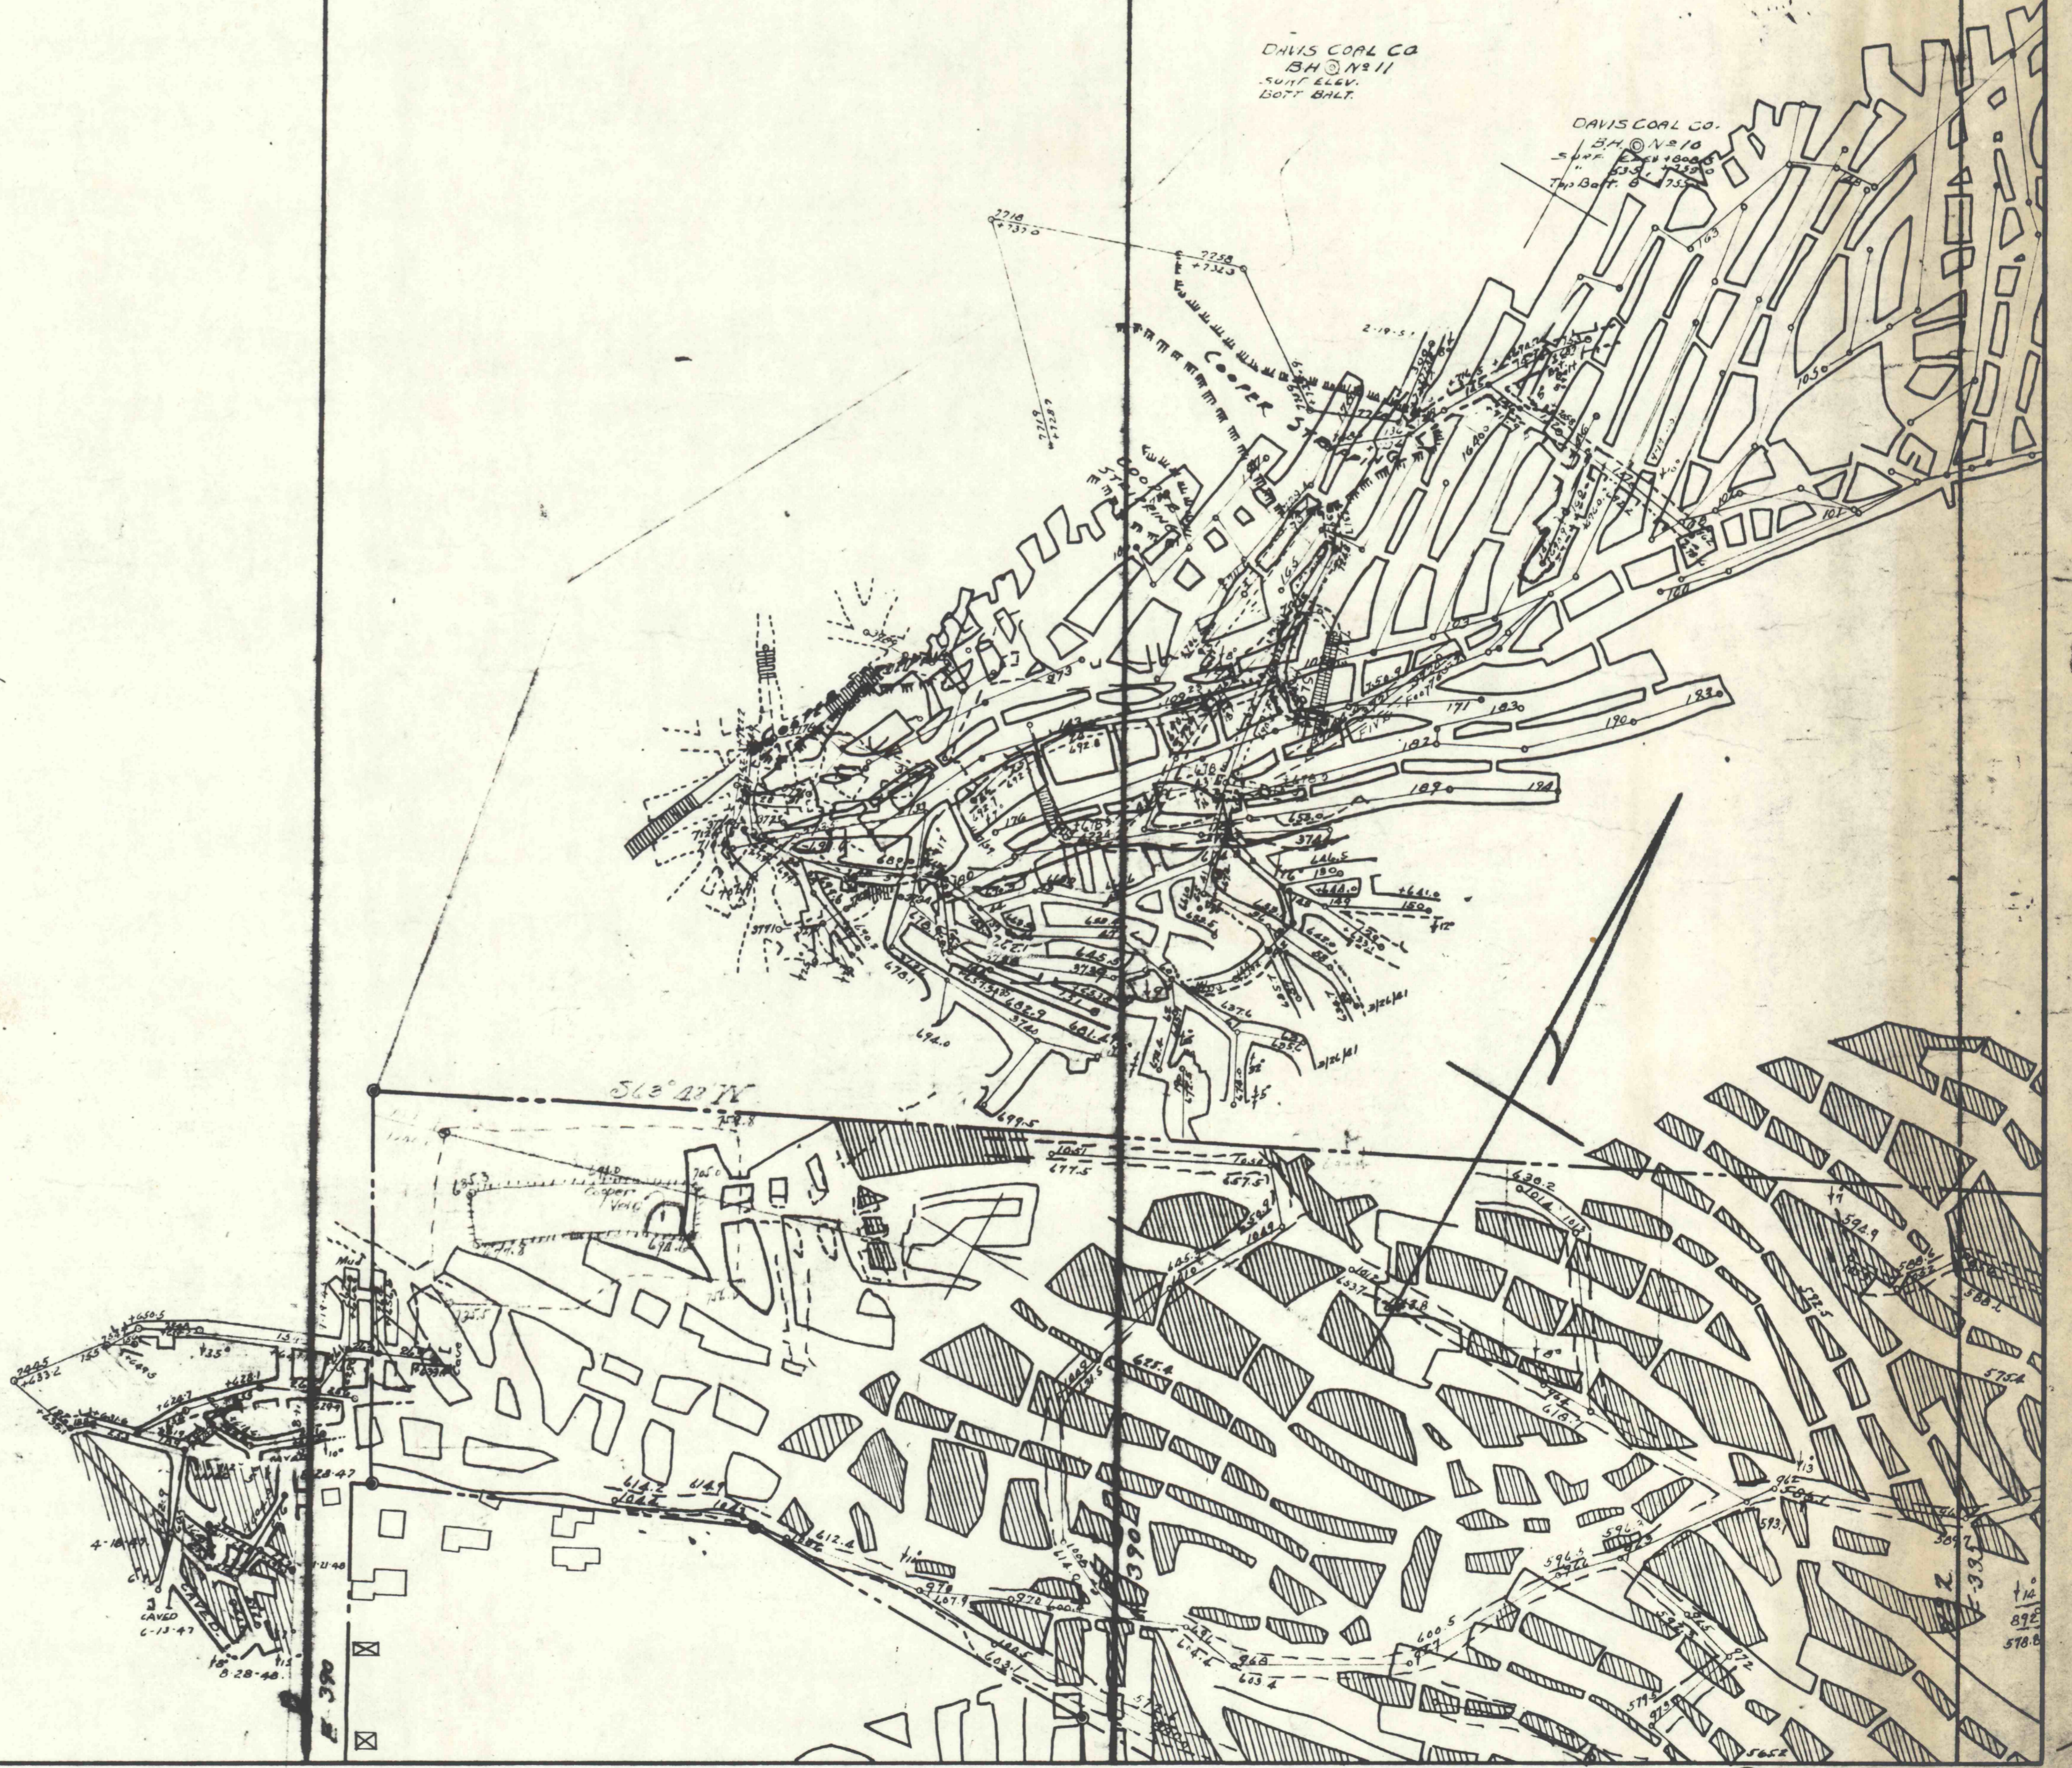

F-390  
177  
178  
179

Reynolds 16  
Top Baltimore #2

No. 2.

Reynolds 16  
Top Baltimore #2

Reynolds 16  
Top Baltimore #2