NOTTINGHAM RED ASH VEIN

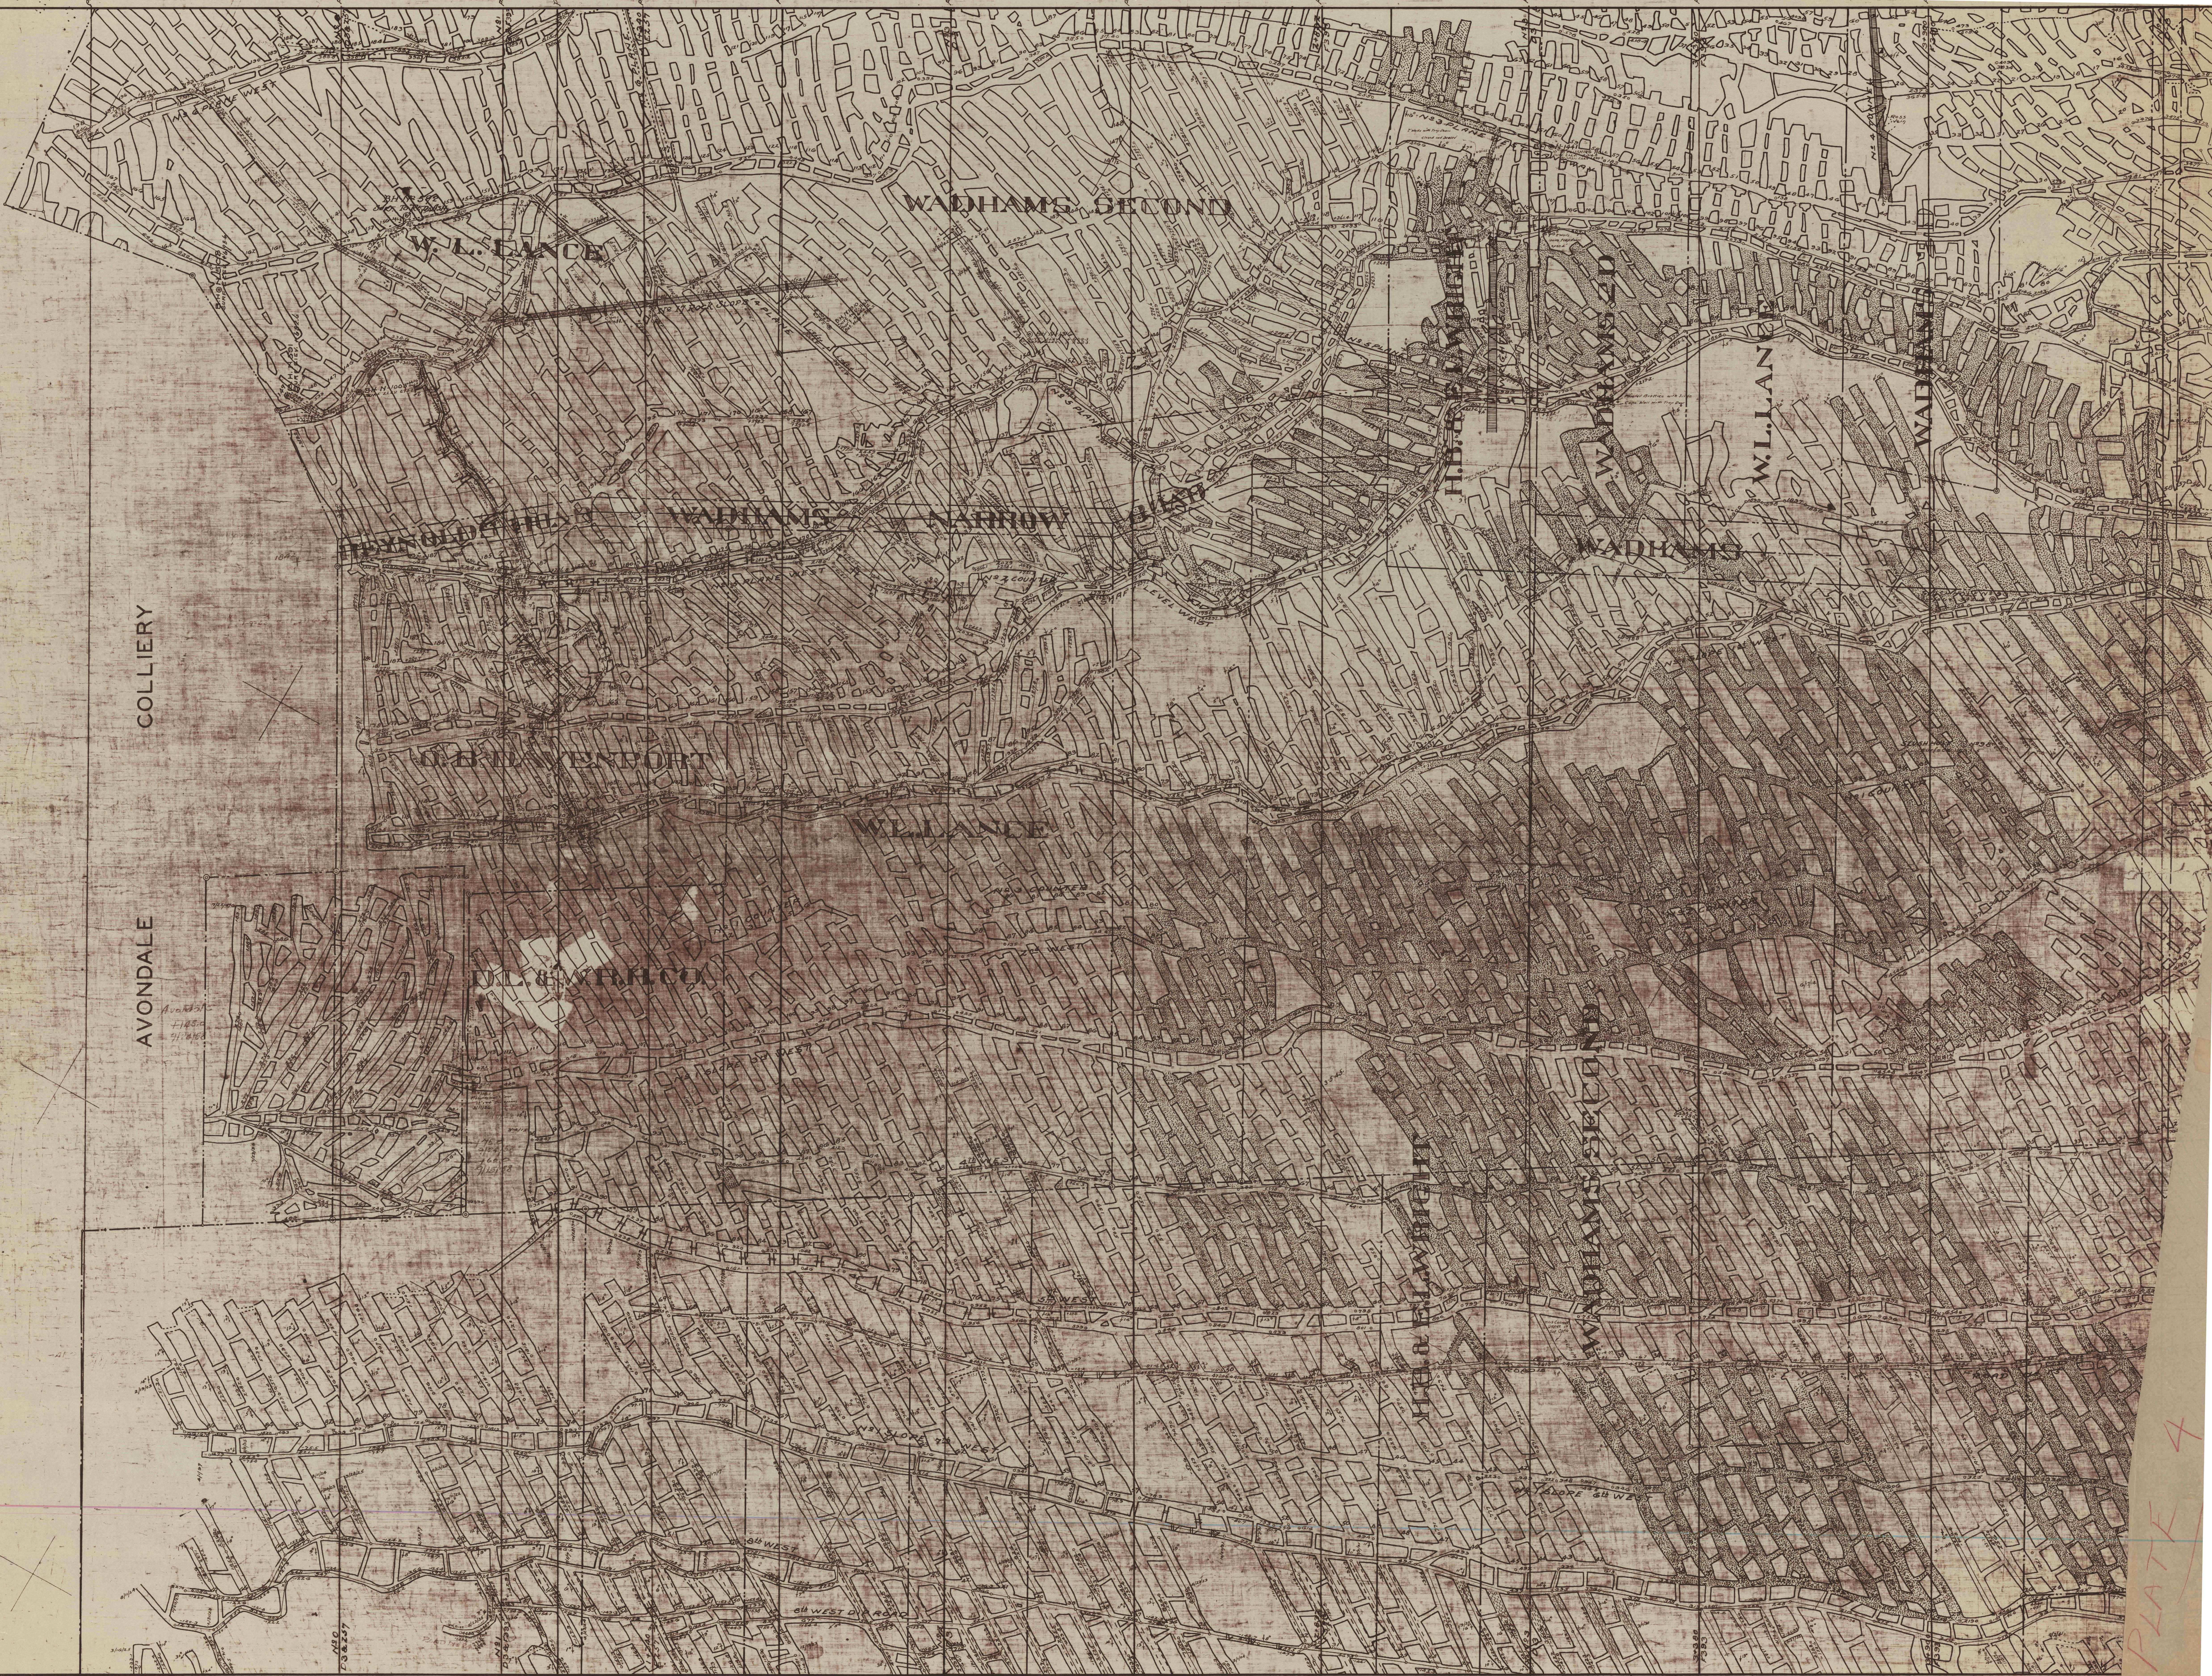

PLATE 4