


REYNOLDS No 16 RED ASH VEIN

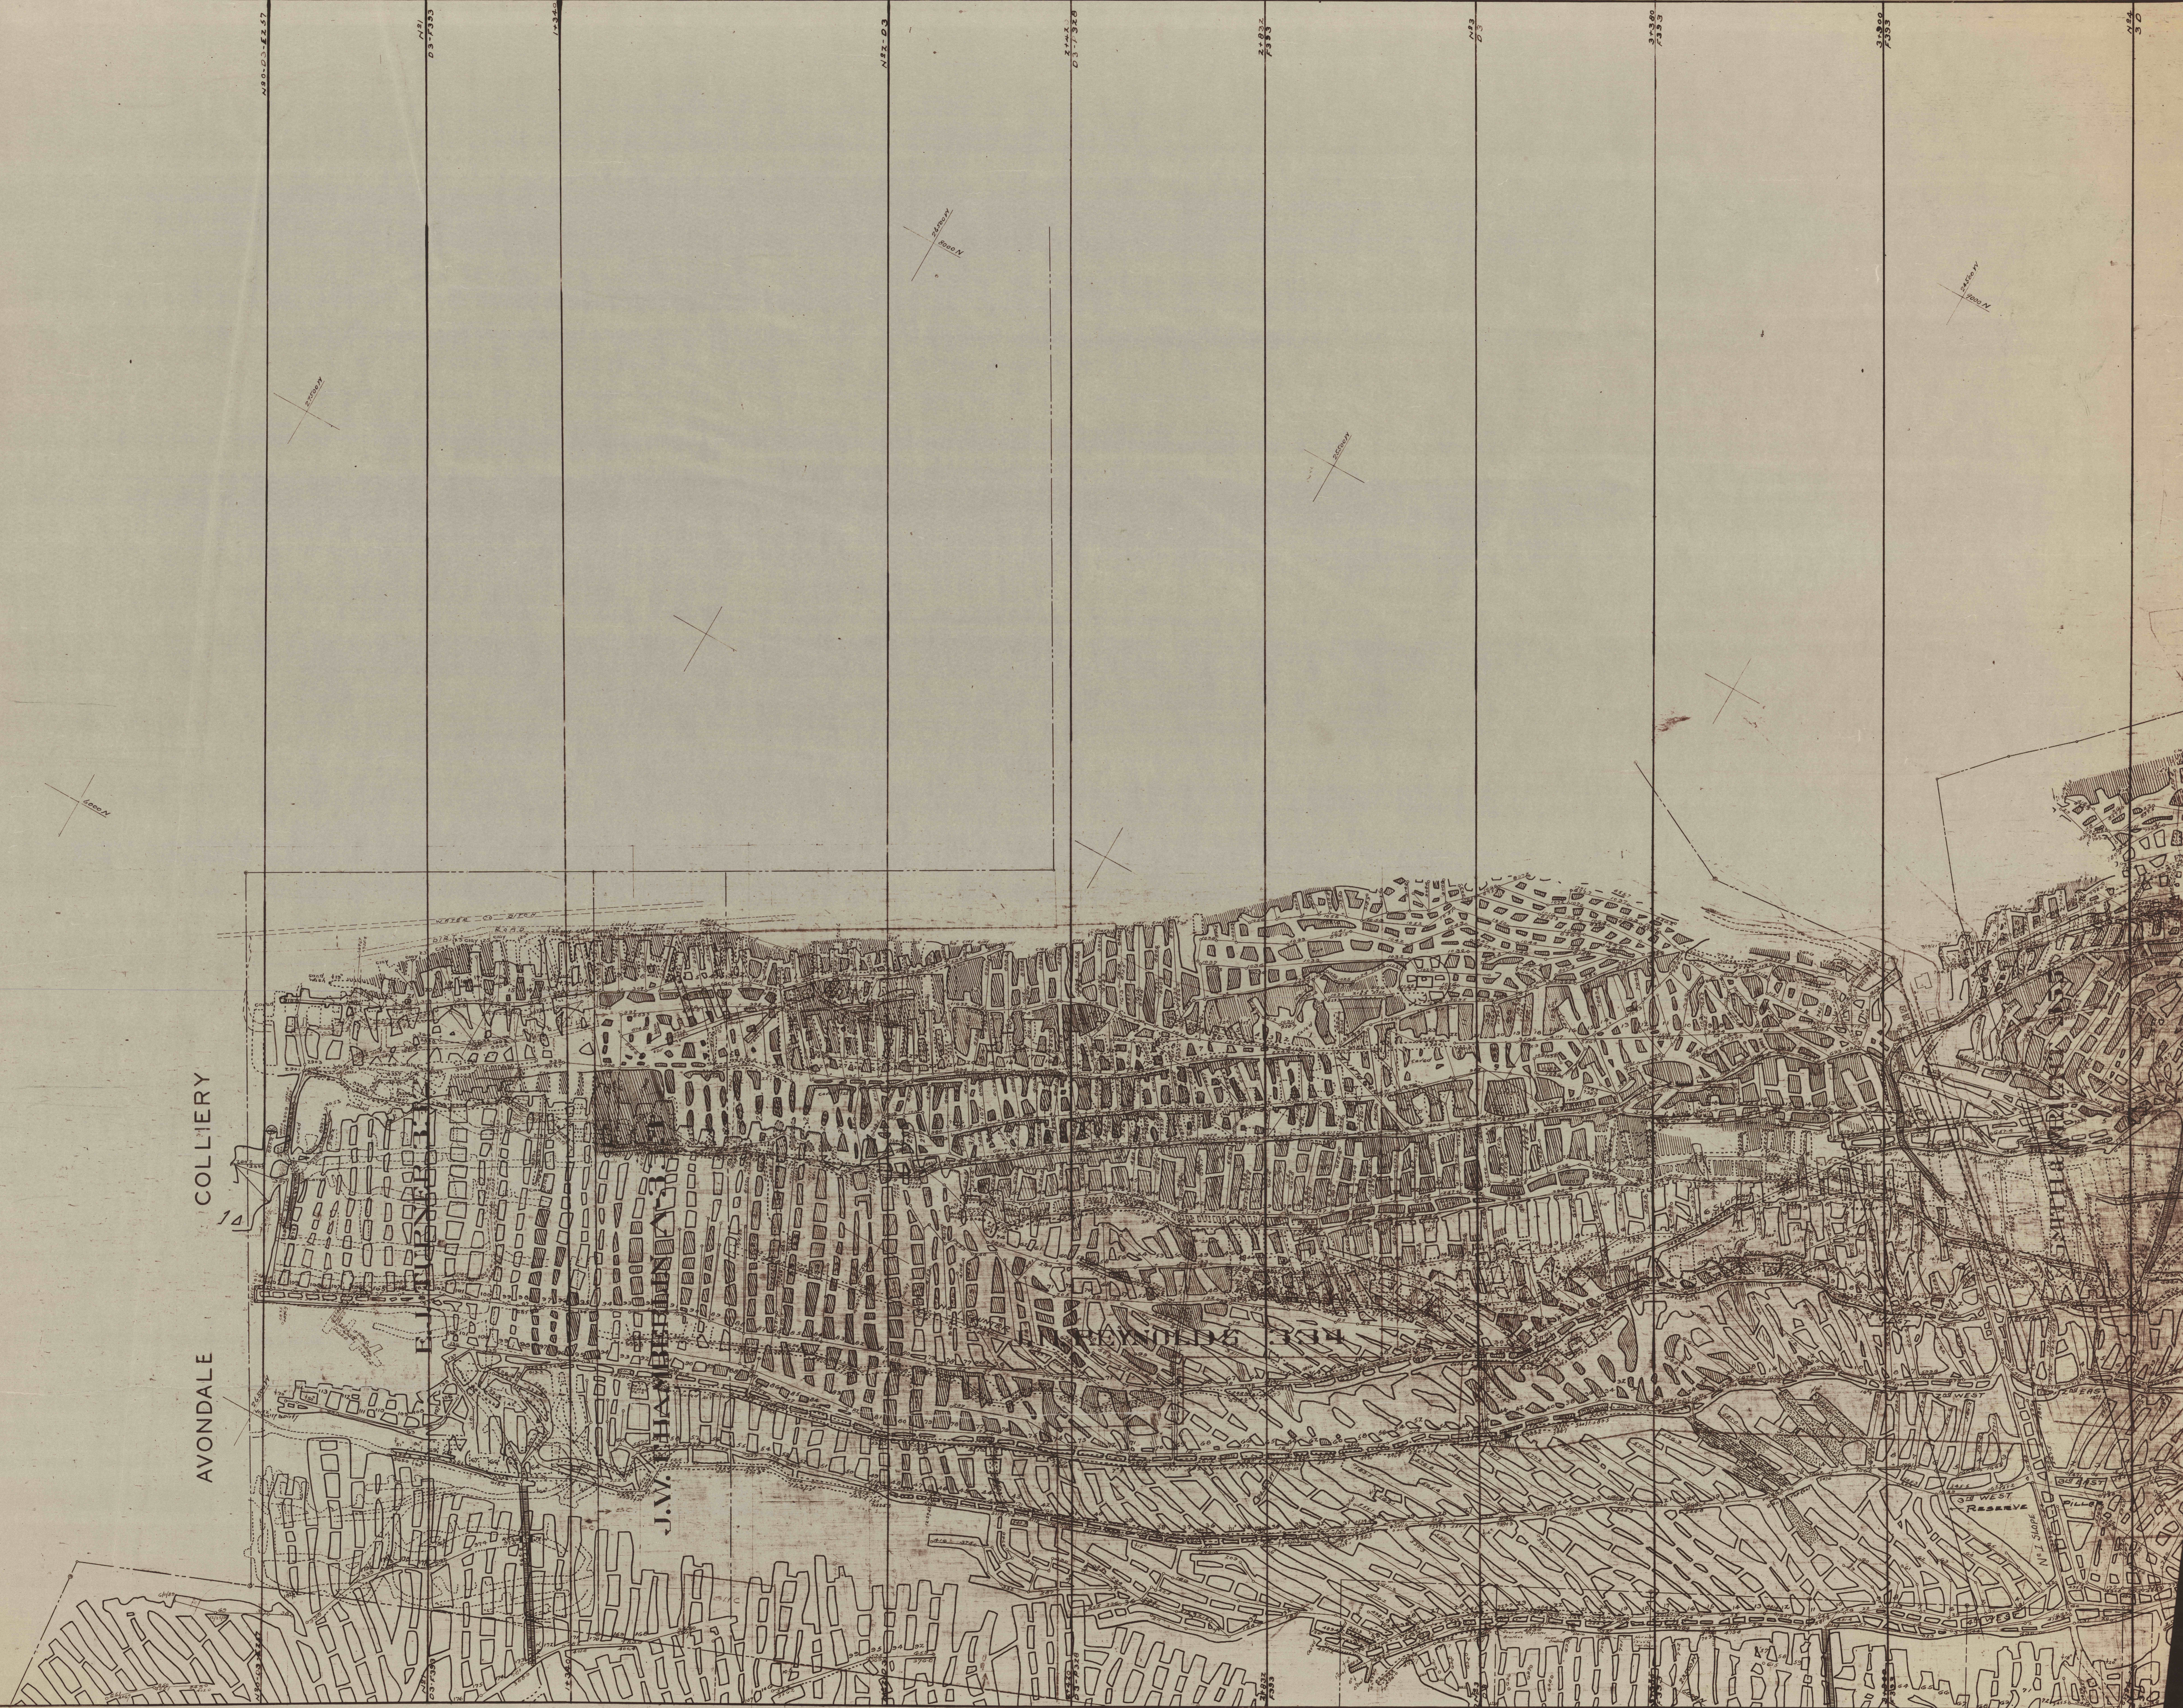

AVONDALE COLLIERY



Reserve


































2000 ft





