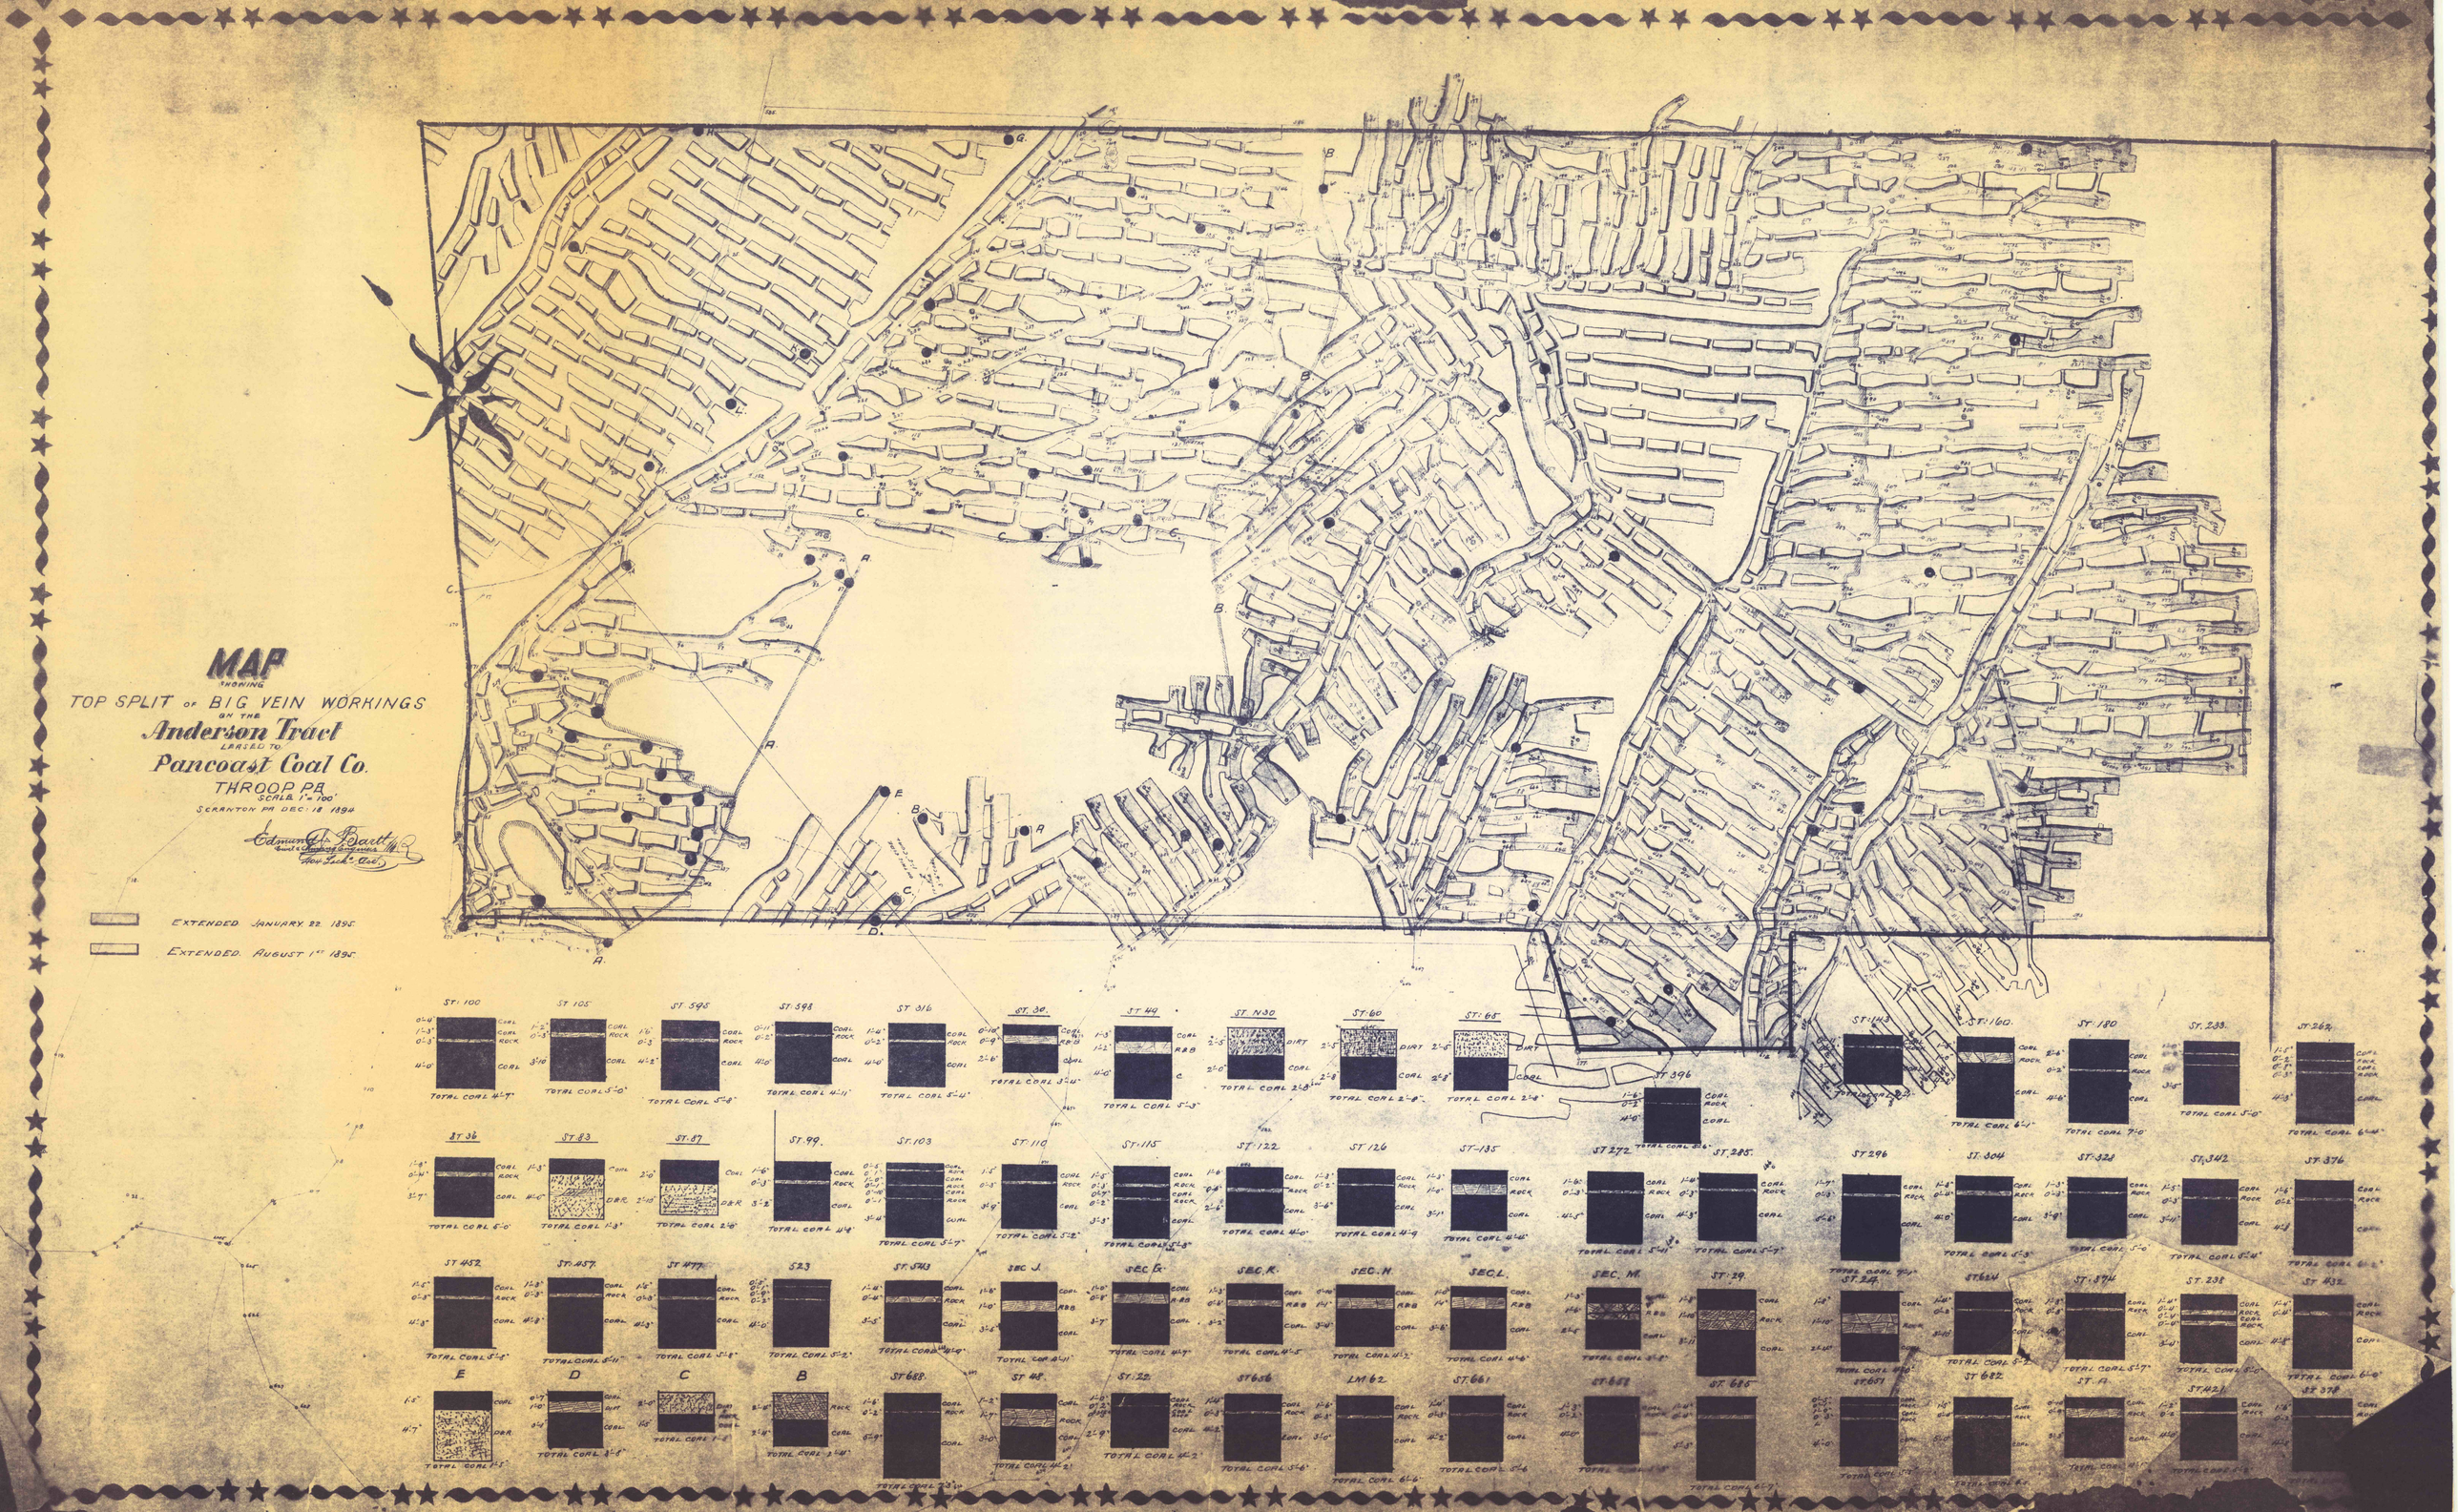
MAP
SHOWING
TOP SPLIT OF BIG VEIN WORKINGS
ON THE
Anderson Tract
LEASED TO
Pancoast Coal Co.
THROOP PA.
SCALE 1" = 100'
SCRANTON PA DEC. 18 1894
EXTENDED JANUARY 22 1895.
EXTENDED AUGUST 1st 1895.
ST. 100
ST. 105
ST. 595
ST. 598
ST. 316
ST. 30
ST. 49
ST. N30
ST. 60
ST. 65
ST. 143
ST. 160
ST. 180
ST. 233
ST. 262
ST. 396
ST. 36
ST. 83
ST. 87
ST. 99
ST. 103
ST. 110
ST. 115
ST. 122
ST. 126
ST. 135
ST. 272
ST. 285
ST. 296
ST. 304
ST. 324
ST. 342
ST. 376
ST. 452
ST. 457
ST. 477
ST. 523
ST. 543
SEC. J.
SEC. K.
SEC. H.
SEC. L.
SEC. M.
ST. 29
ST. 234
ST. 624
ST. 634
ST. 238
ST. 432
E
D
C
B
ST. 648
ST. 48
ST. 22
ST. 656
LM 62
ST. 661
ST. 657
ST. 685
ST. 651
ST. 682
ST. A
ST. 421
ST. 378
TOTAL COAL 4'-7"
TOTAL COAL 5'-0"
TOTAL COAL 5'-8"
TOTAL COAL 4'-11"
TOTAL COAL 5'-4"
TOTAL COAL 3'-4"
TOTAL COAL 4'-3"
TOTAL COAL 2'-8"
TOTAL COAL 2'-8"
TOTAL COAL 2'-4"
TOTAL COAL 2'-8"
TOTAL COAL 6'-4"
TOTAL COAL 7'-0"
TOTAL COAL 5'-0"
TOTAL COAL 6'-4"
TOTAL COAL 5'-0"
TOTAL COAL 1'-3"
TOTAL COAL 2'-8"
TOTAL COAL 4'-8"
TOTAL COAL 5'-7"
TOTAL COAL 5'-2"
TOTAL COAL 4'-8"
TOTAL COAL 4'-9"
TOTAL COAL 4'-6"
TOTAL COAL 5'-1"
TOTAL COAL 5'-7"
TOTAL COAL 5'-3"
TOTAL COAL 5'-0"
TOTAL COAL 5'-4"
TOTAL COAL 5'-8"
TOTAL COAL 5'-11"
TOTAL COAL 5'-8"
TOTAL COAL 5'-2"
TOTAL COAL 4'-4"
TOTAL COAL 4'-1"
TOTAL COAL 4'-7"
TOTAL COAL 4'-2"
TOTAL COAL 4'-5"
TOTAL COAL 4'-2"
TOTAL COAL 4'-6"
TOTAL COAL 5'-8"
TOTAL COAL 5'-7"
TOTAL COAL 5'-0"
TOTAL COAL 5'-7"
TOTAL COAL 5'-0"
TOTAL COAL 6'-0"
TOTAL COAL 6'-0"
TOTAL COAL 1'-5"
TOTAL COAL 3'-8"
TOTAL COAL 1'-8"
TOTAL COAL 2'-4"
TOTAL COAL 23'-0"
TOTAL COAL 4'-2"
TOTAL COAL 4'-2"
TOTAL COAL 5'-6"
TOTAL COAL 6'-6"
TOTAL COAL 5'-6"
TOTAL COAL 6'-7"