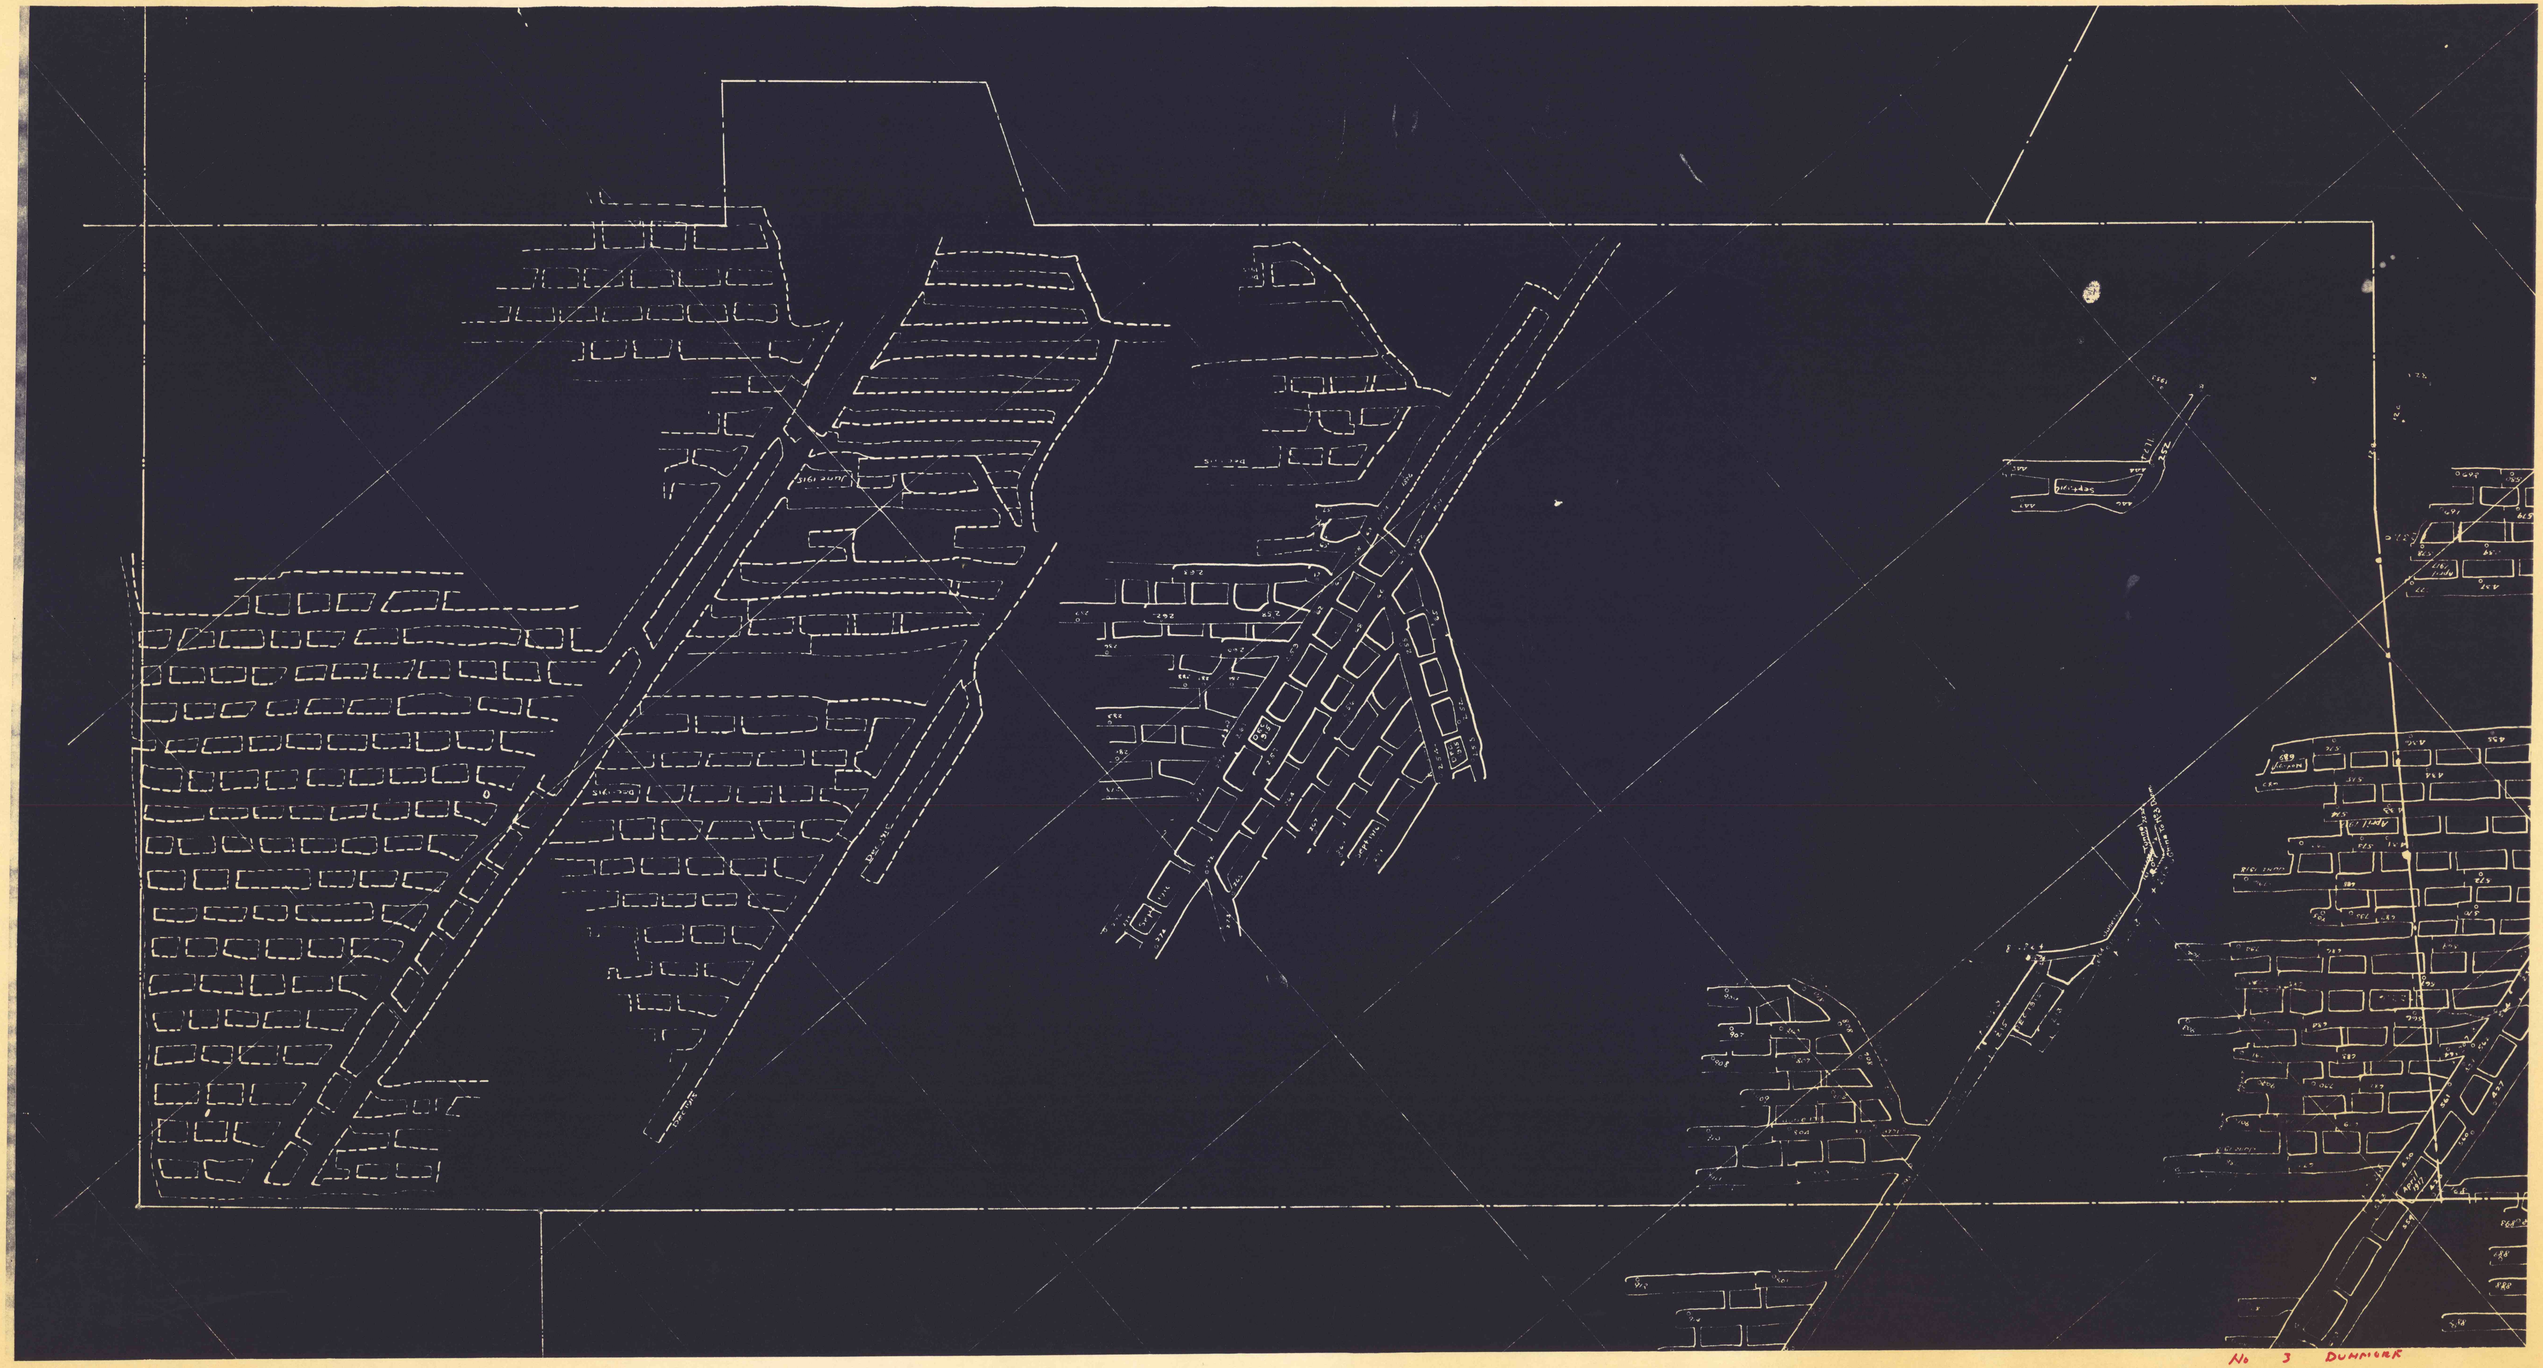

No 3 DUNMORE