


M.R.

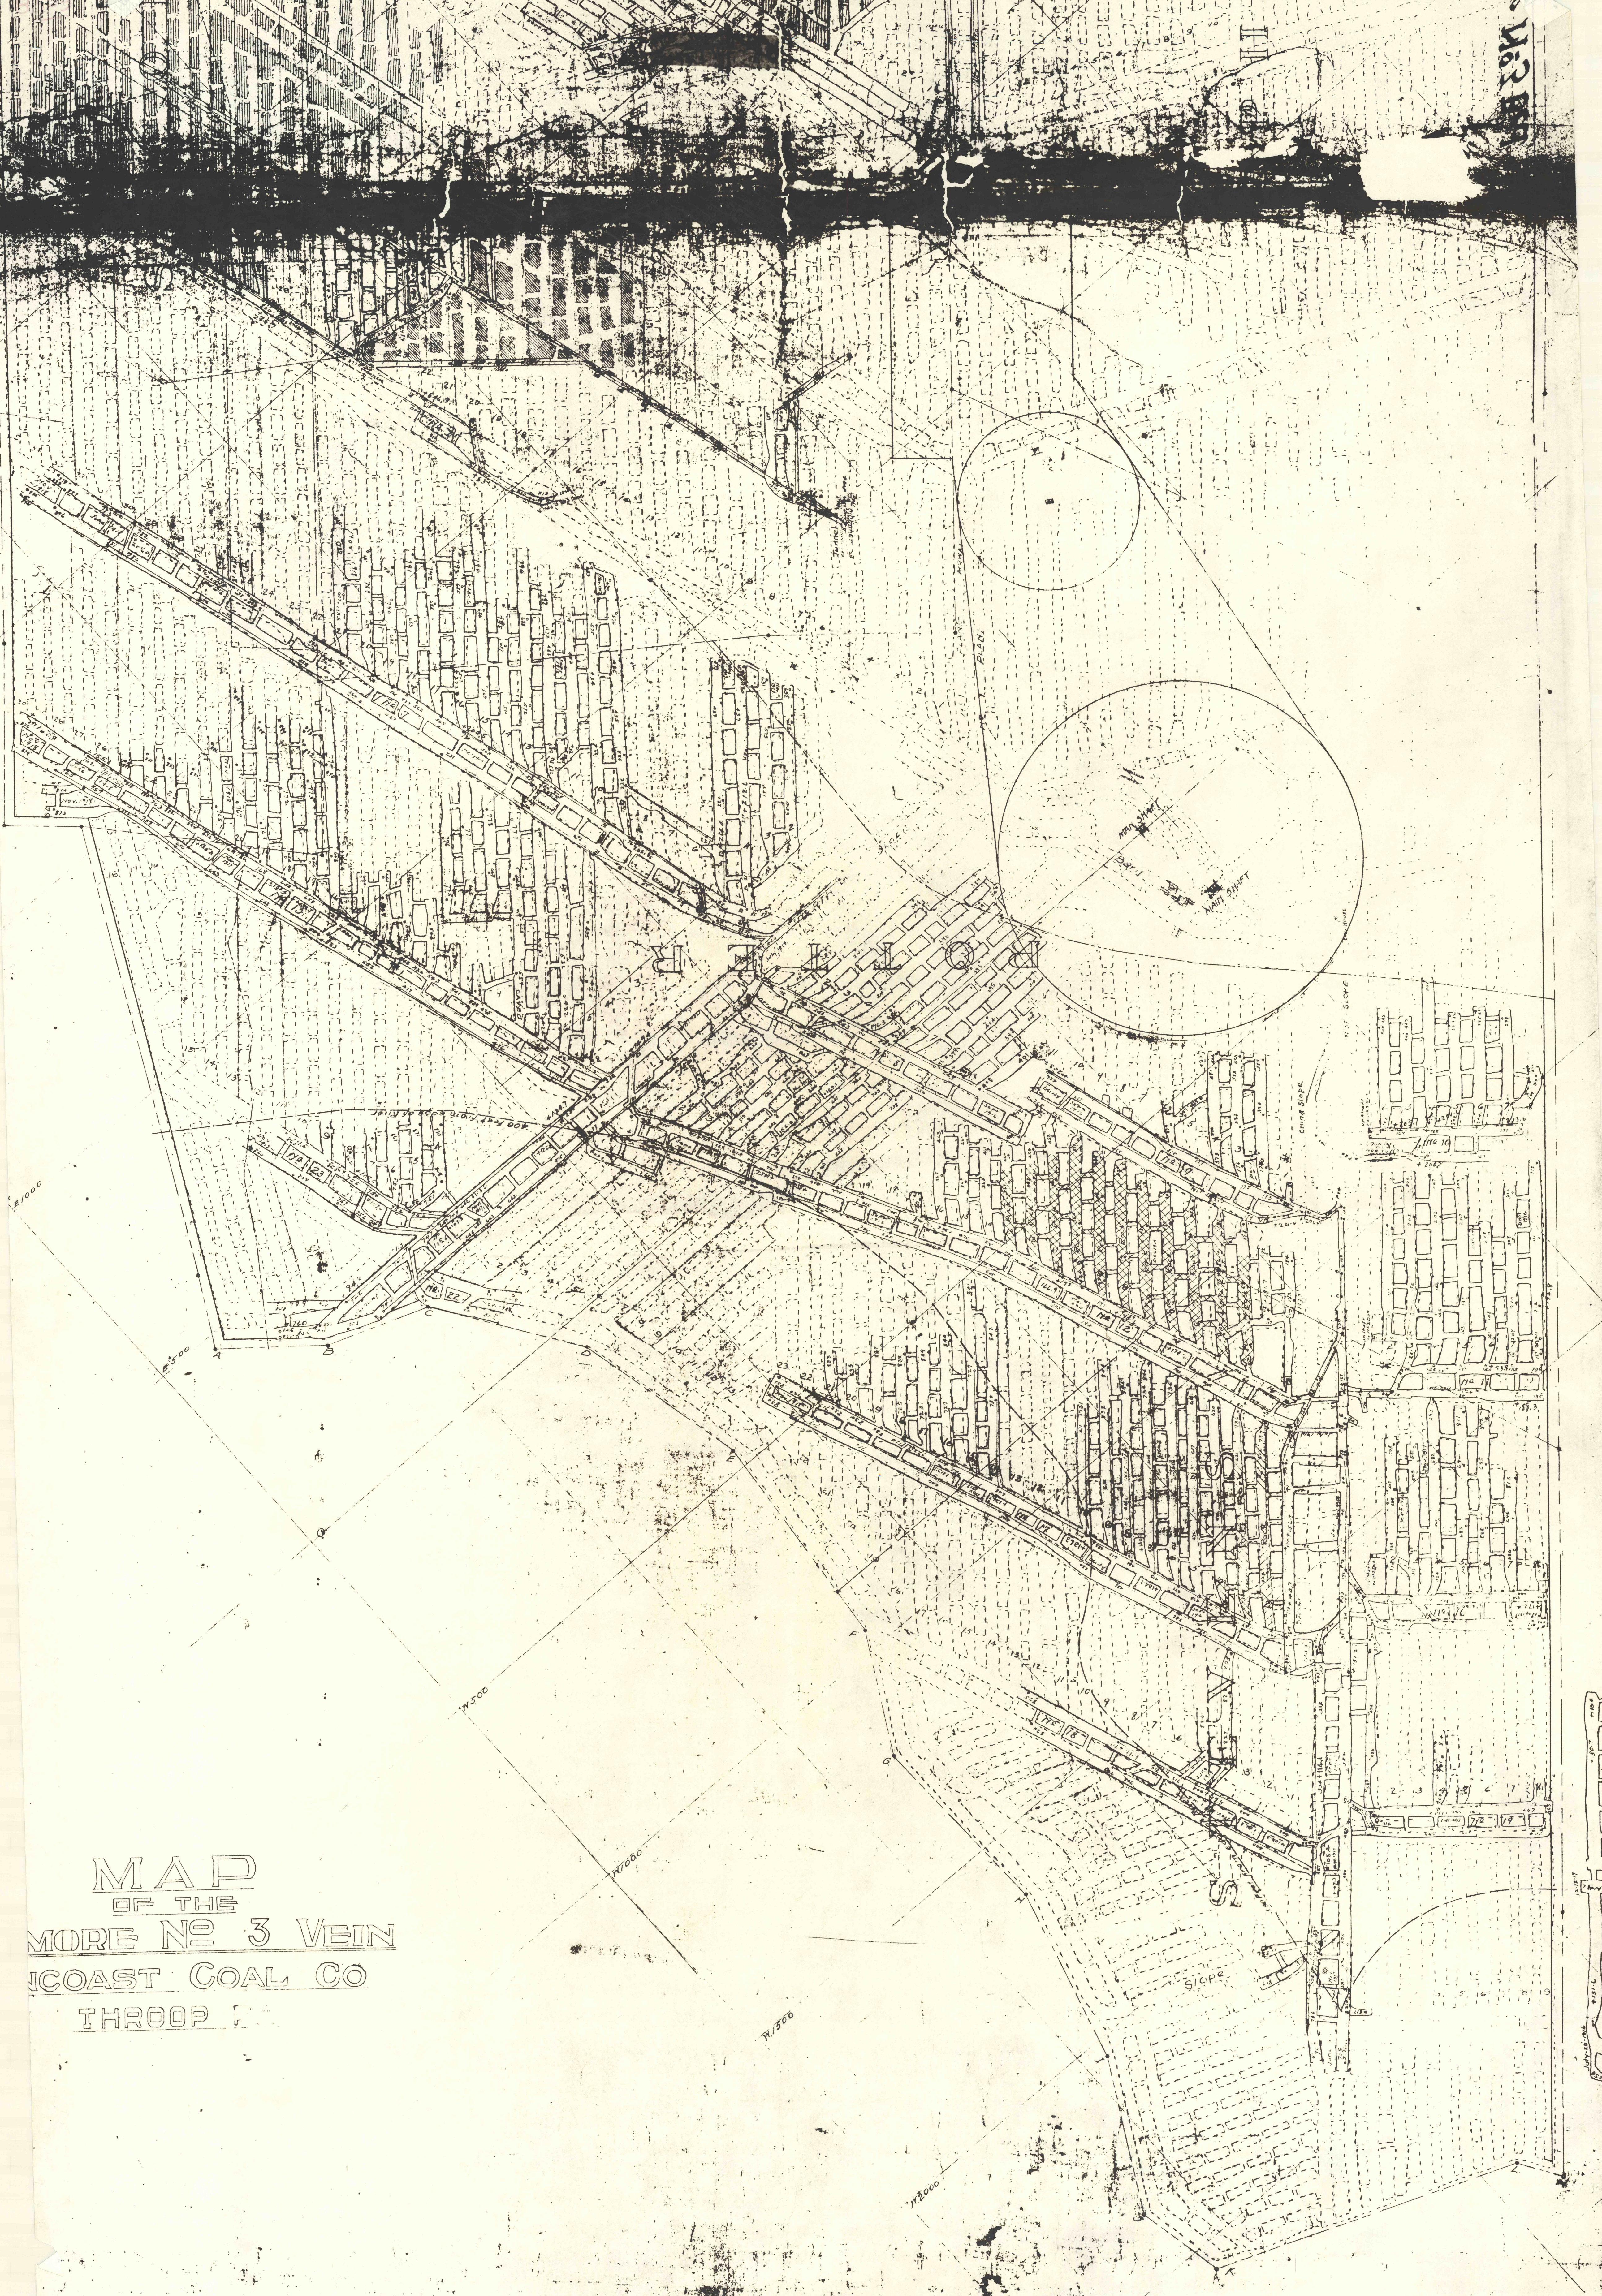

MAP
 OF THE
 MORE NO 3 VEIN
 COAST COAL CO
 THROOP