
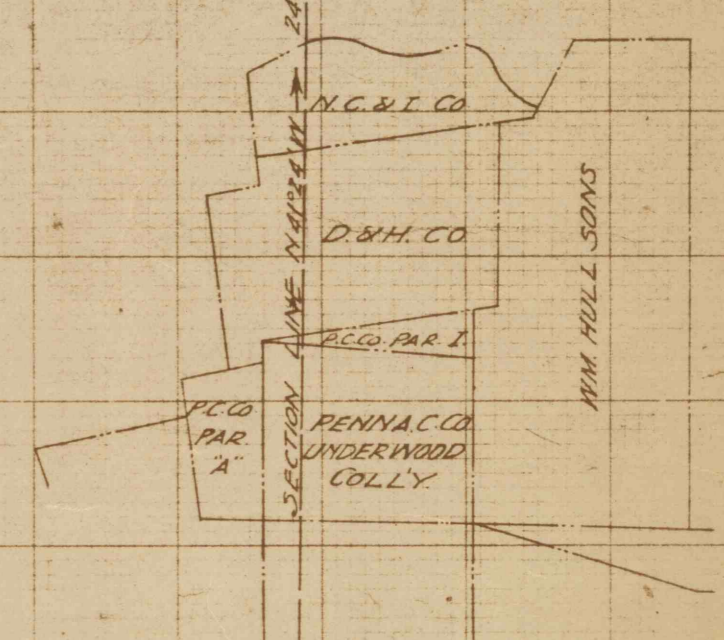


OLYPHANT DIVISION  
CROSS SECTION

23-24

LOOKING S.W. THRU PROPERTY  
IN VICINITY OF STEINECKE ST.  
SCALE 1"=100'  
SEPT. 1931

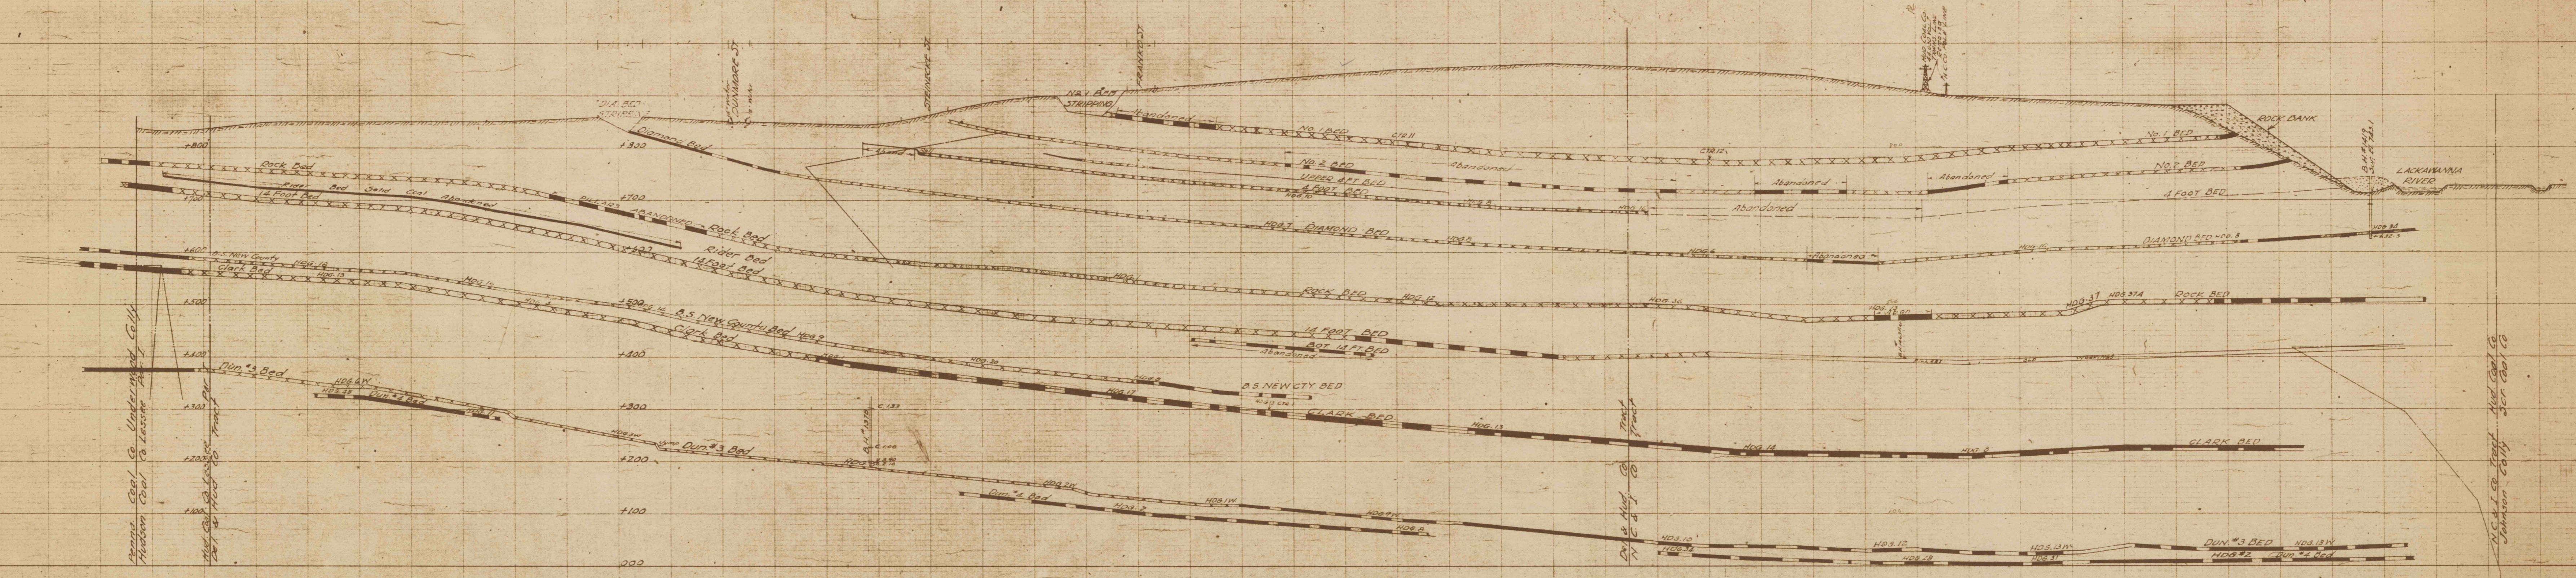

POSTED BY	POSTED BY
11-21-32	K.M.
6-3-34	K.M.
1-3-35	K.M.
7-26-35	K.M.
7-27-36	K.M.
10-28-37	K.M.
5-22-41	K.M.
3-27-45	L.S.
2-18-48	L.S.