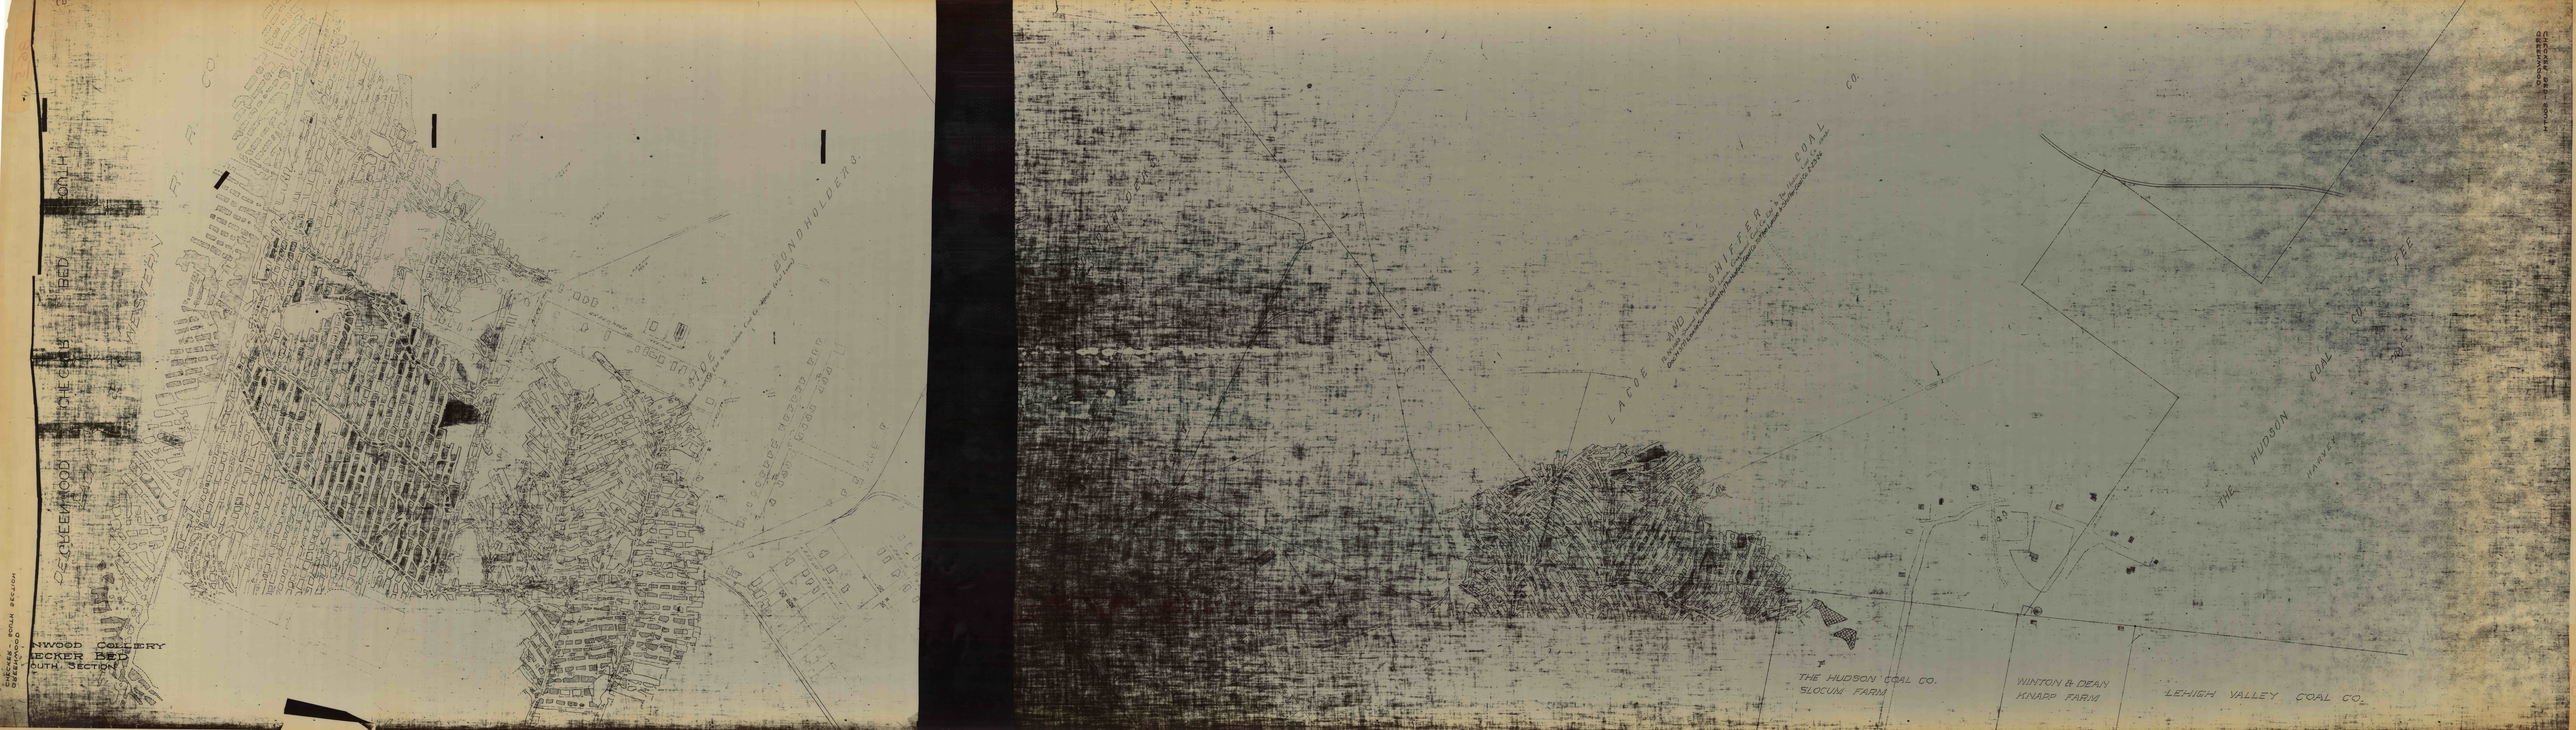
CHECKER BED
SOUTH SECTION
WESTERN R. R. CO.
BONDHOLDERS.
LACOE AND SHIFFER COAL CO.
THE HUDSON COAL CO.
SLOCUM FARM
WINTON & DEAN
KNAPP FARM
LEHIGH VALLEY COAL CO.
THE HUDSON COAL CO.
HARVEY
FEE