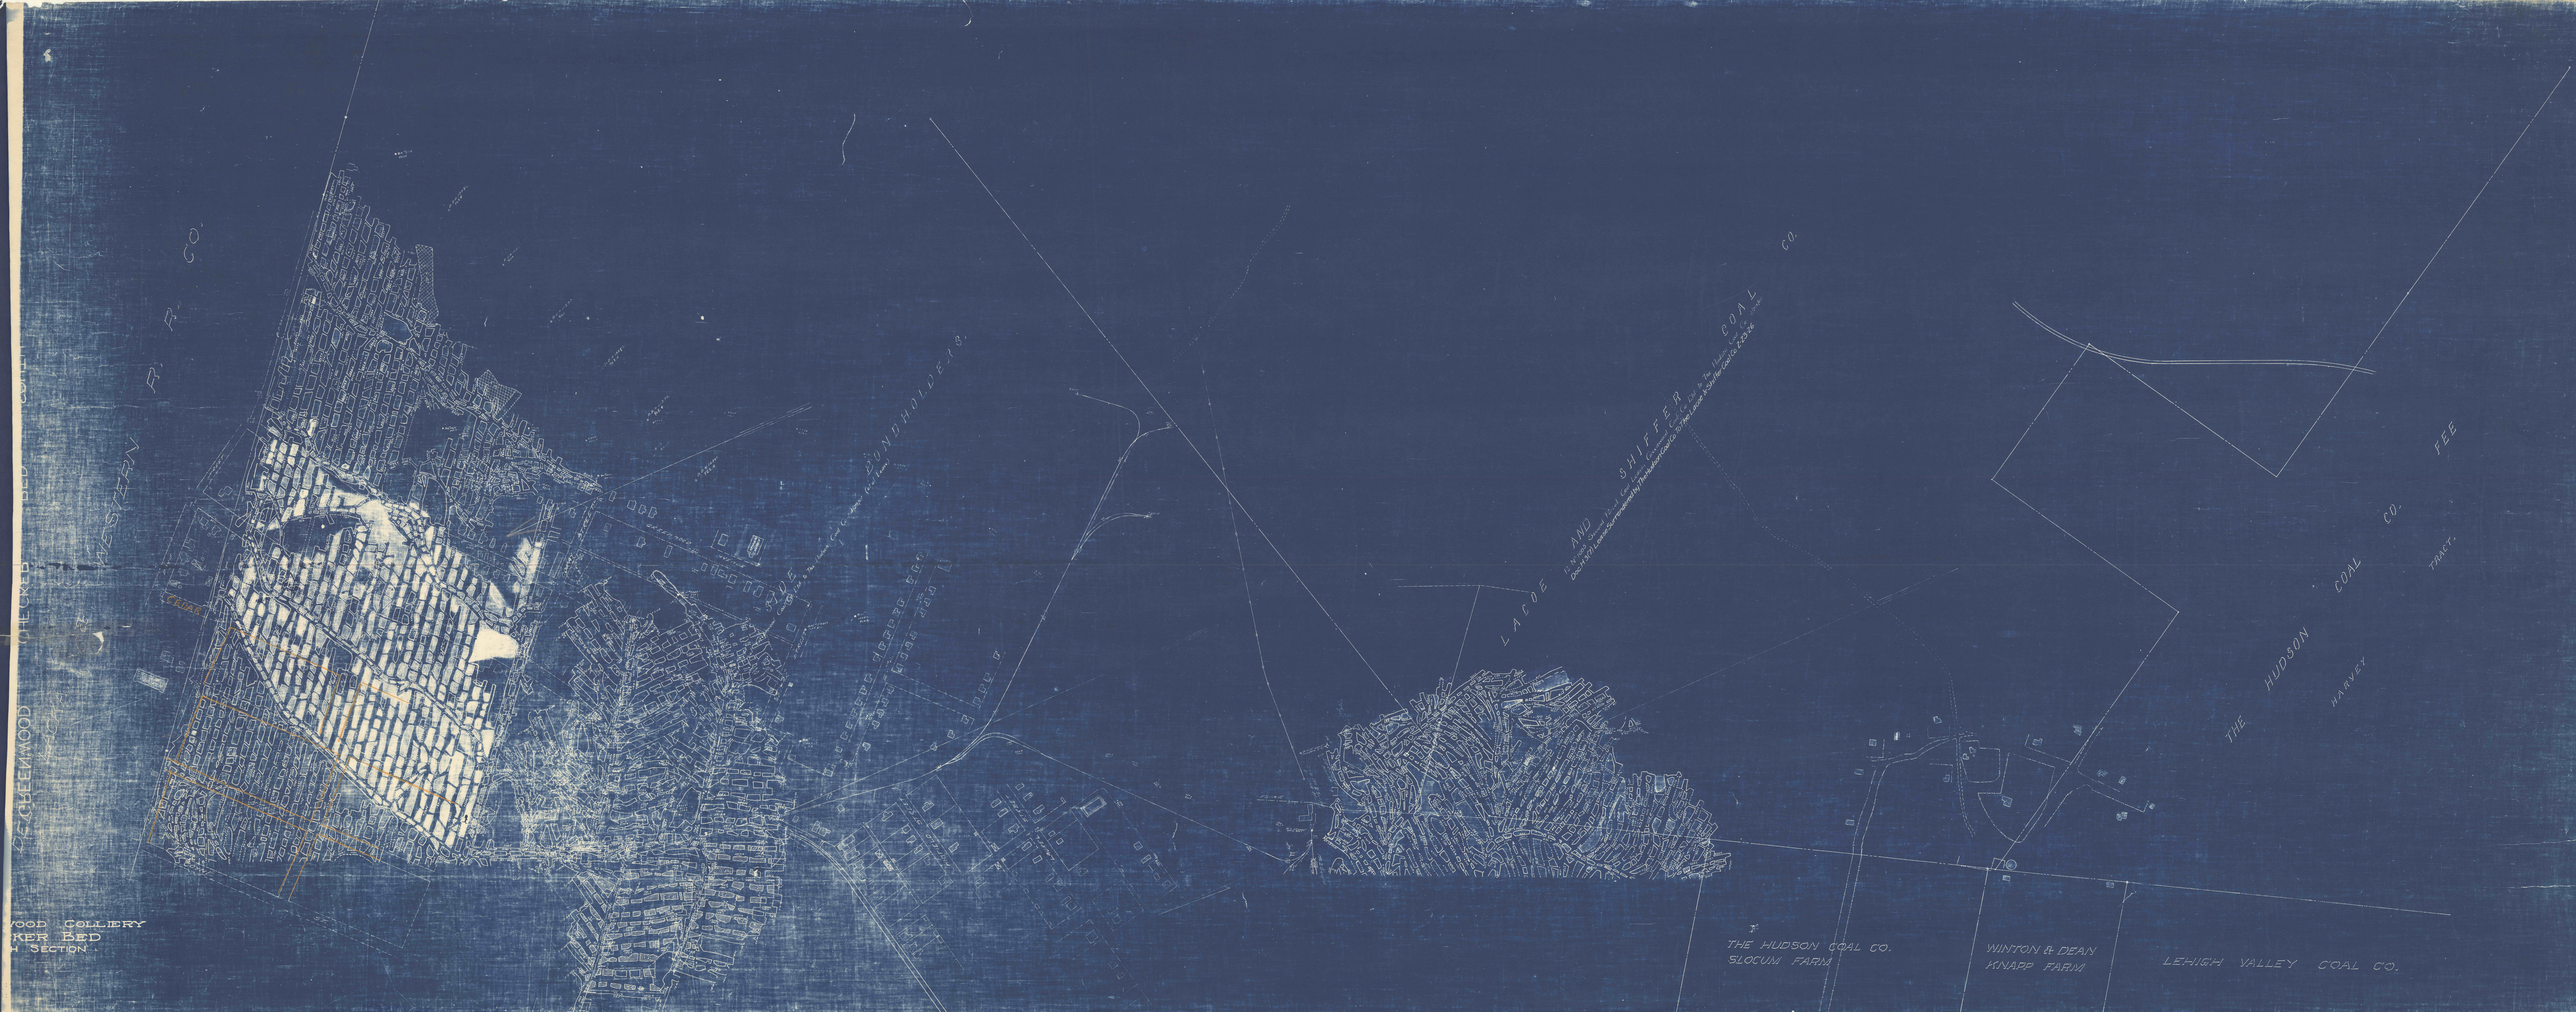
WESTERN R. R. CO.
COAL
LACOE AND SHIFFER COAL CO.
THE HUDSON COAL CO. FEE
HARVEY TRACT.
THE HUDSON COAL CO.
SLOCUM FARM
WINTON & DEAN
KNAPP FARM
LEHIGH VALLEY COAL CO.
OOD COLLIERY
KER BED
H SECTION