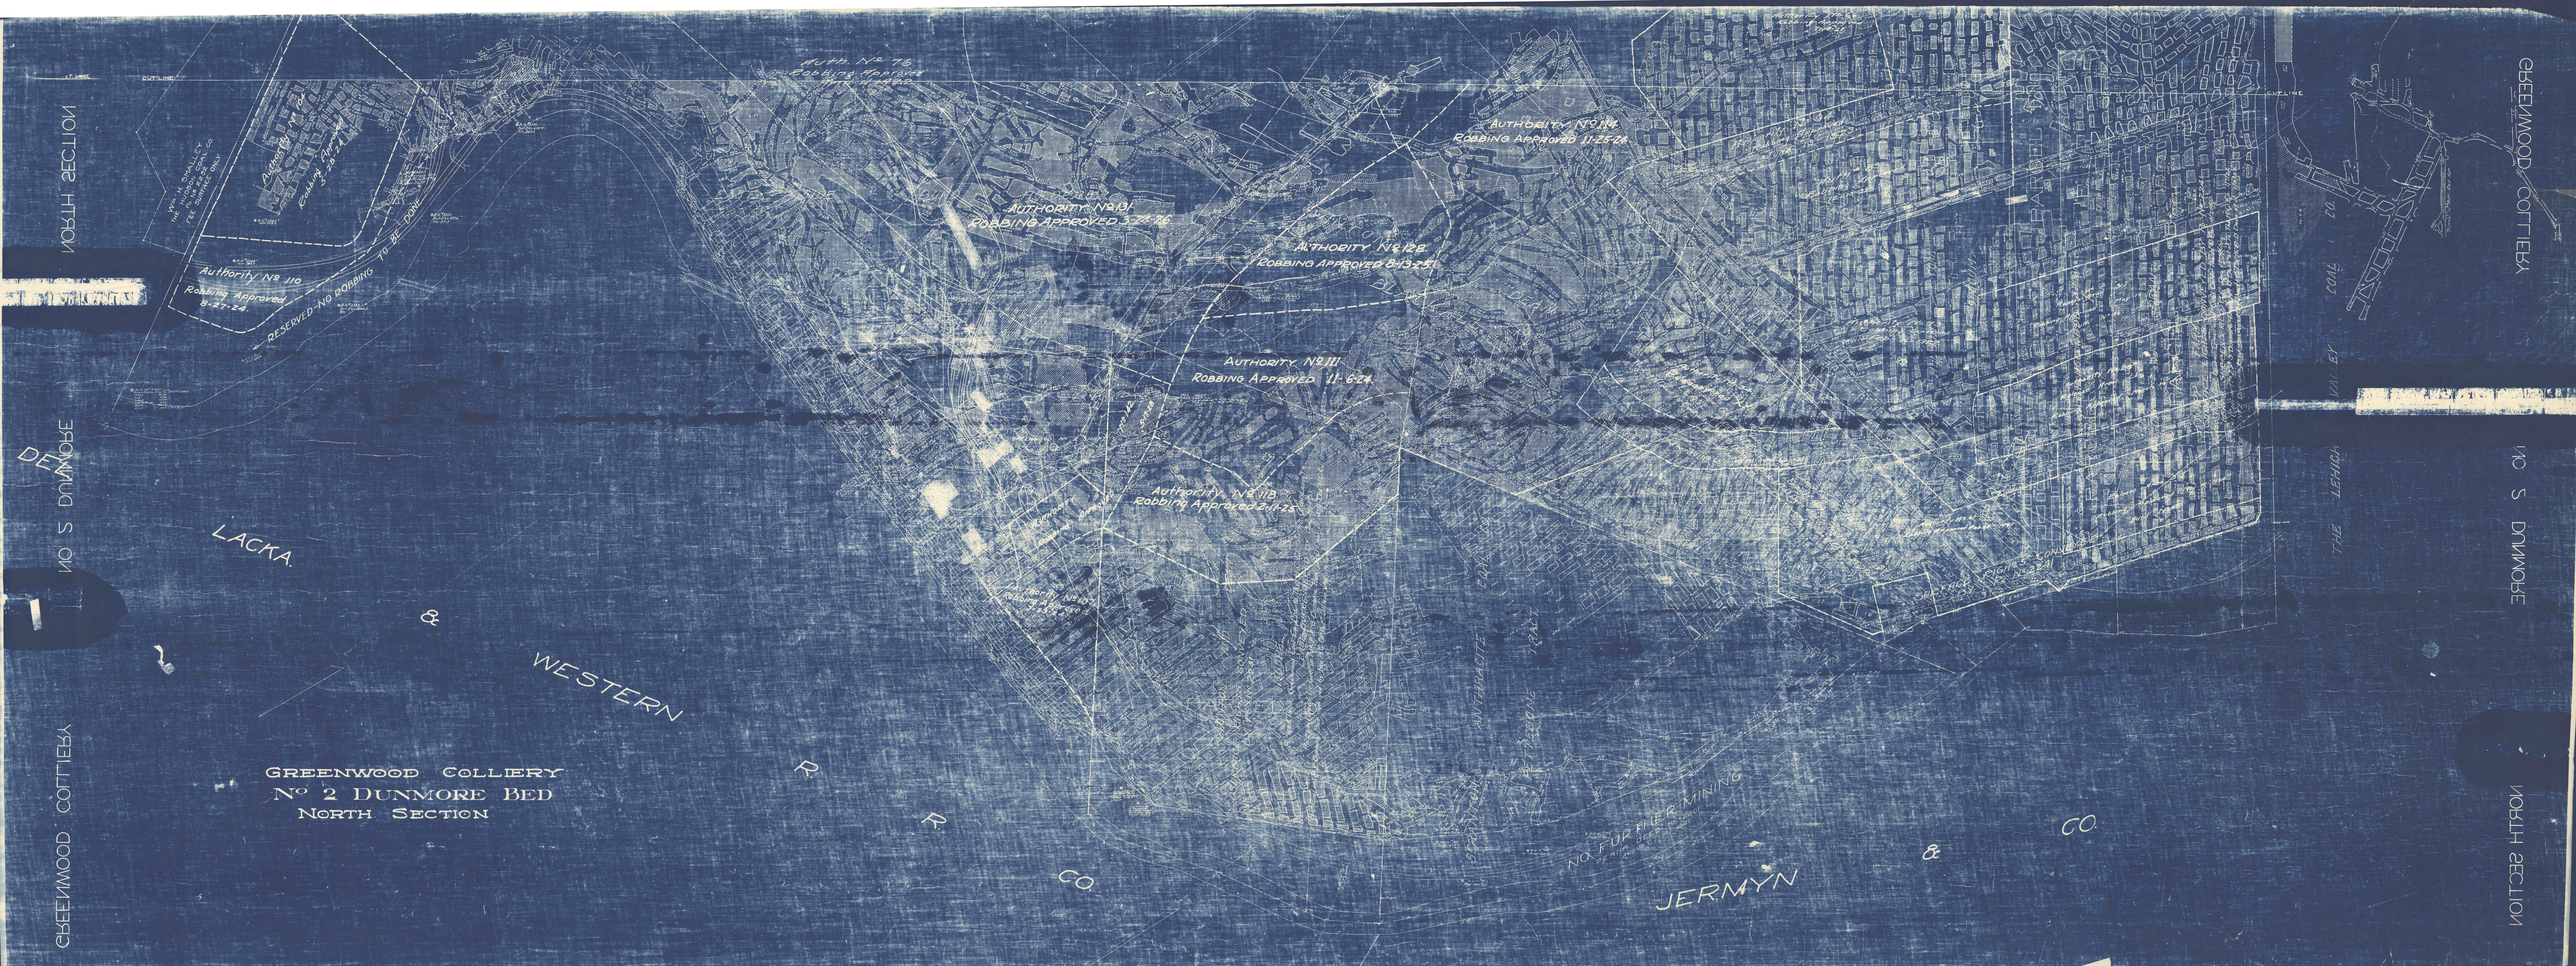
GREENWOOD COLLIERY
No 2 DUNMORE BED
NORTH SECTION
NORTH SECTION
GREENWOOD COLLIERY
No 2 DUNMORE
NORTH SECTION
GREENWOOD COLLIERY
No 2 DUNMORE
DEL
LACKA
&
WESTERN
R.
R.
CO
JERMYN
&
CO.
Authority No 110
Robbing Approved
8-27-24
RESERVED-NO ROBBING TO BE DONE
Authority No 131
ROBBING APPROVED 3-27-26
Authority No 128
ROBBING APPROVED 8-13-25
Authority No 114
ROBBING APPROVED 11-25-24
Authority No 111
ROBBING APPROVED 11-6-24
Authority No 118
Robbing Approved 2-11-25
NO FURTHER MINING
THE LEHIGH VALLEY COAL CO.