


EXTENSION OF MINE WORKINGS
APPLIED HEREON BY
ON

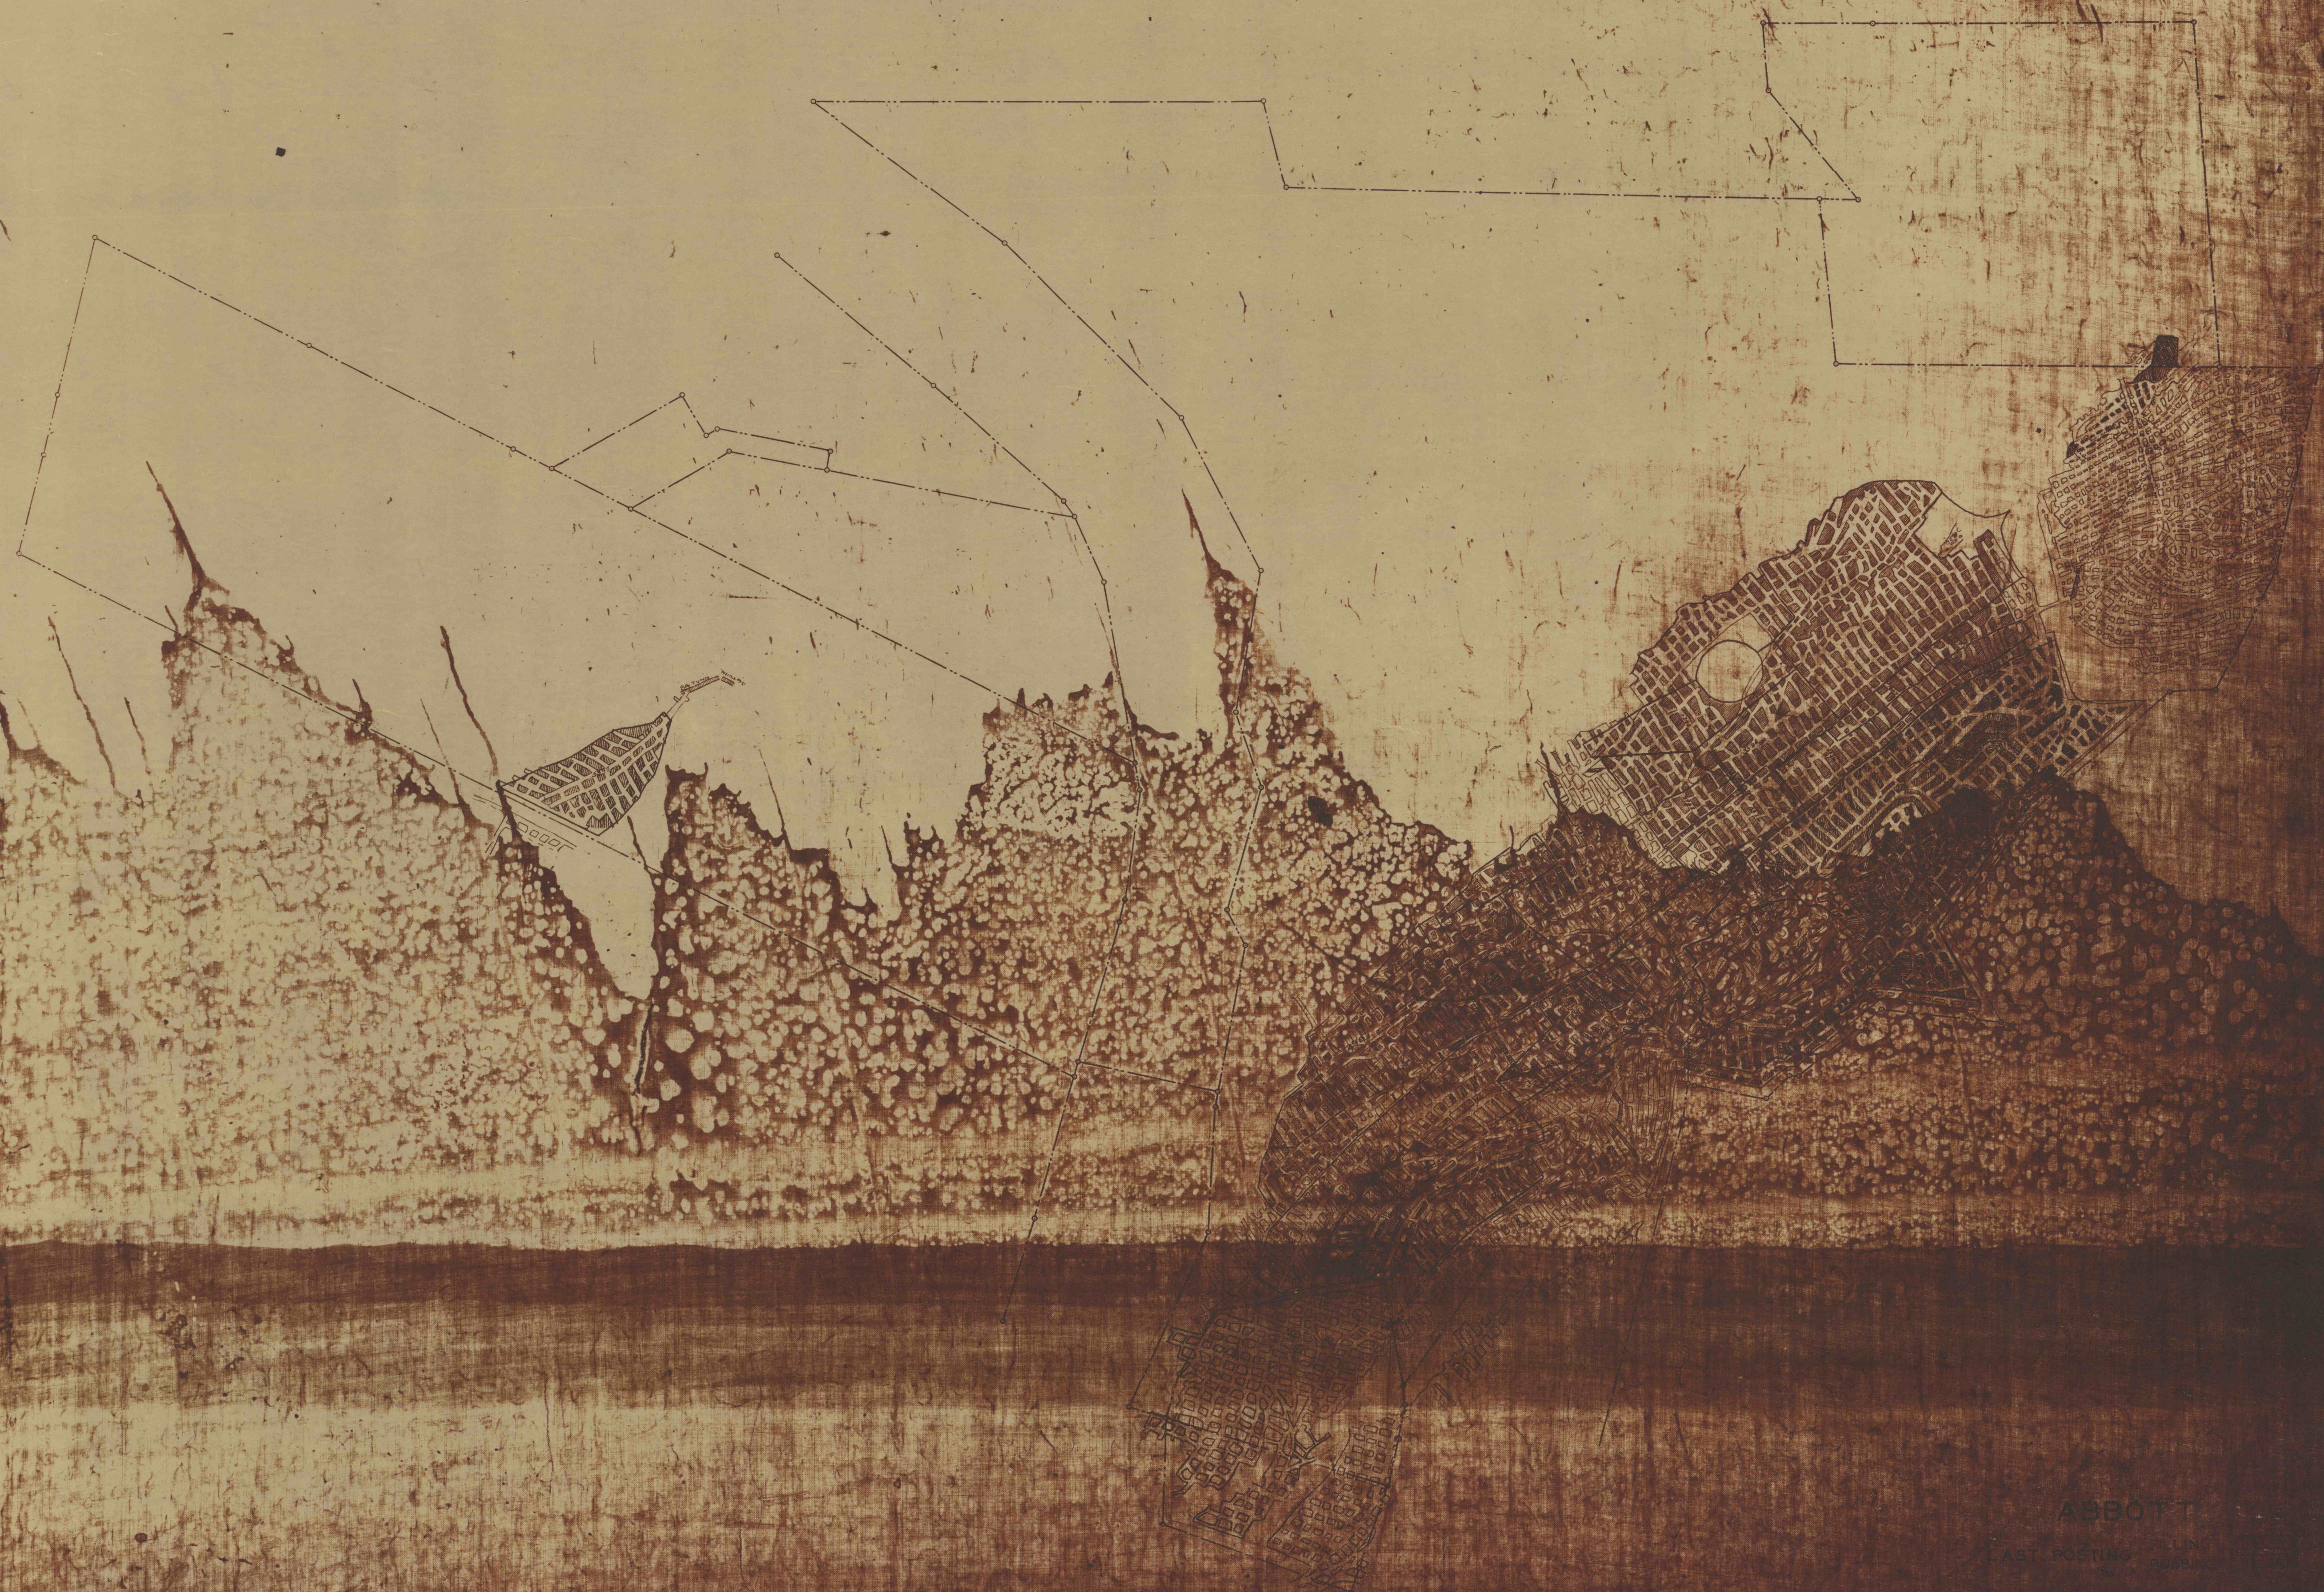

ABBOTT

LAST POSTING