


EXTENSION OF MINE WORKINGS
APPLIED HEREON BY []
ON []

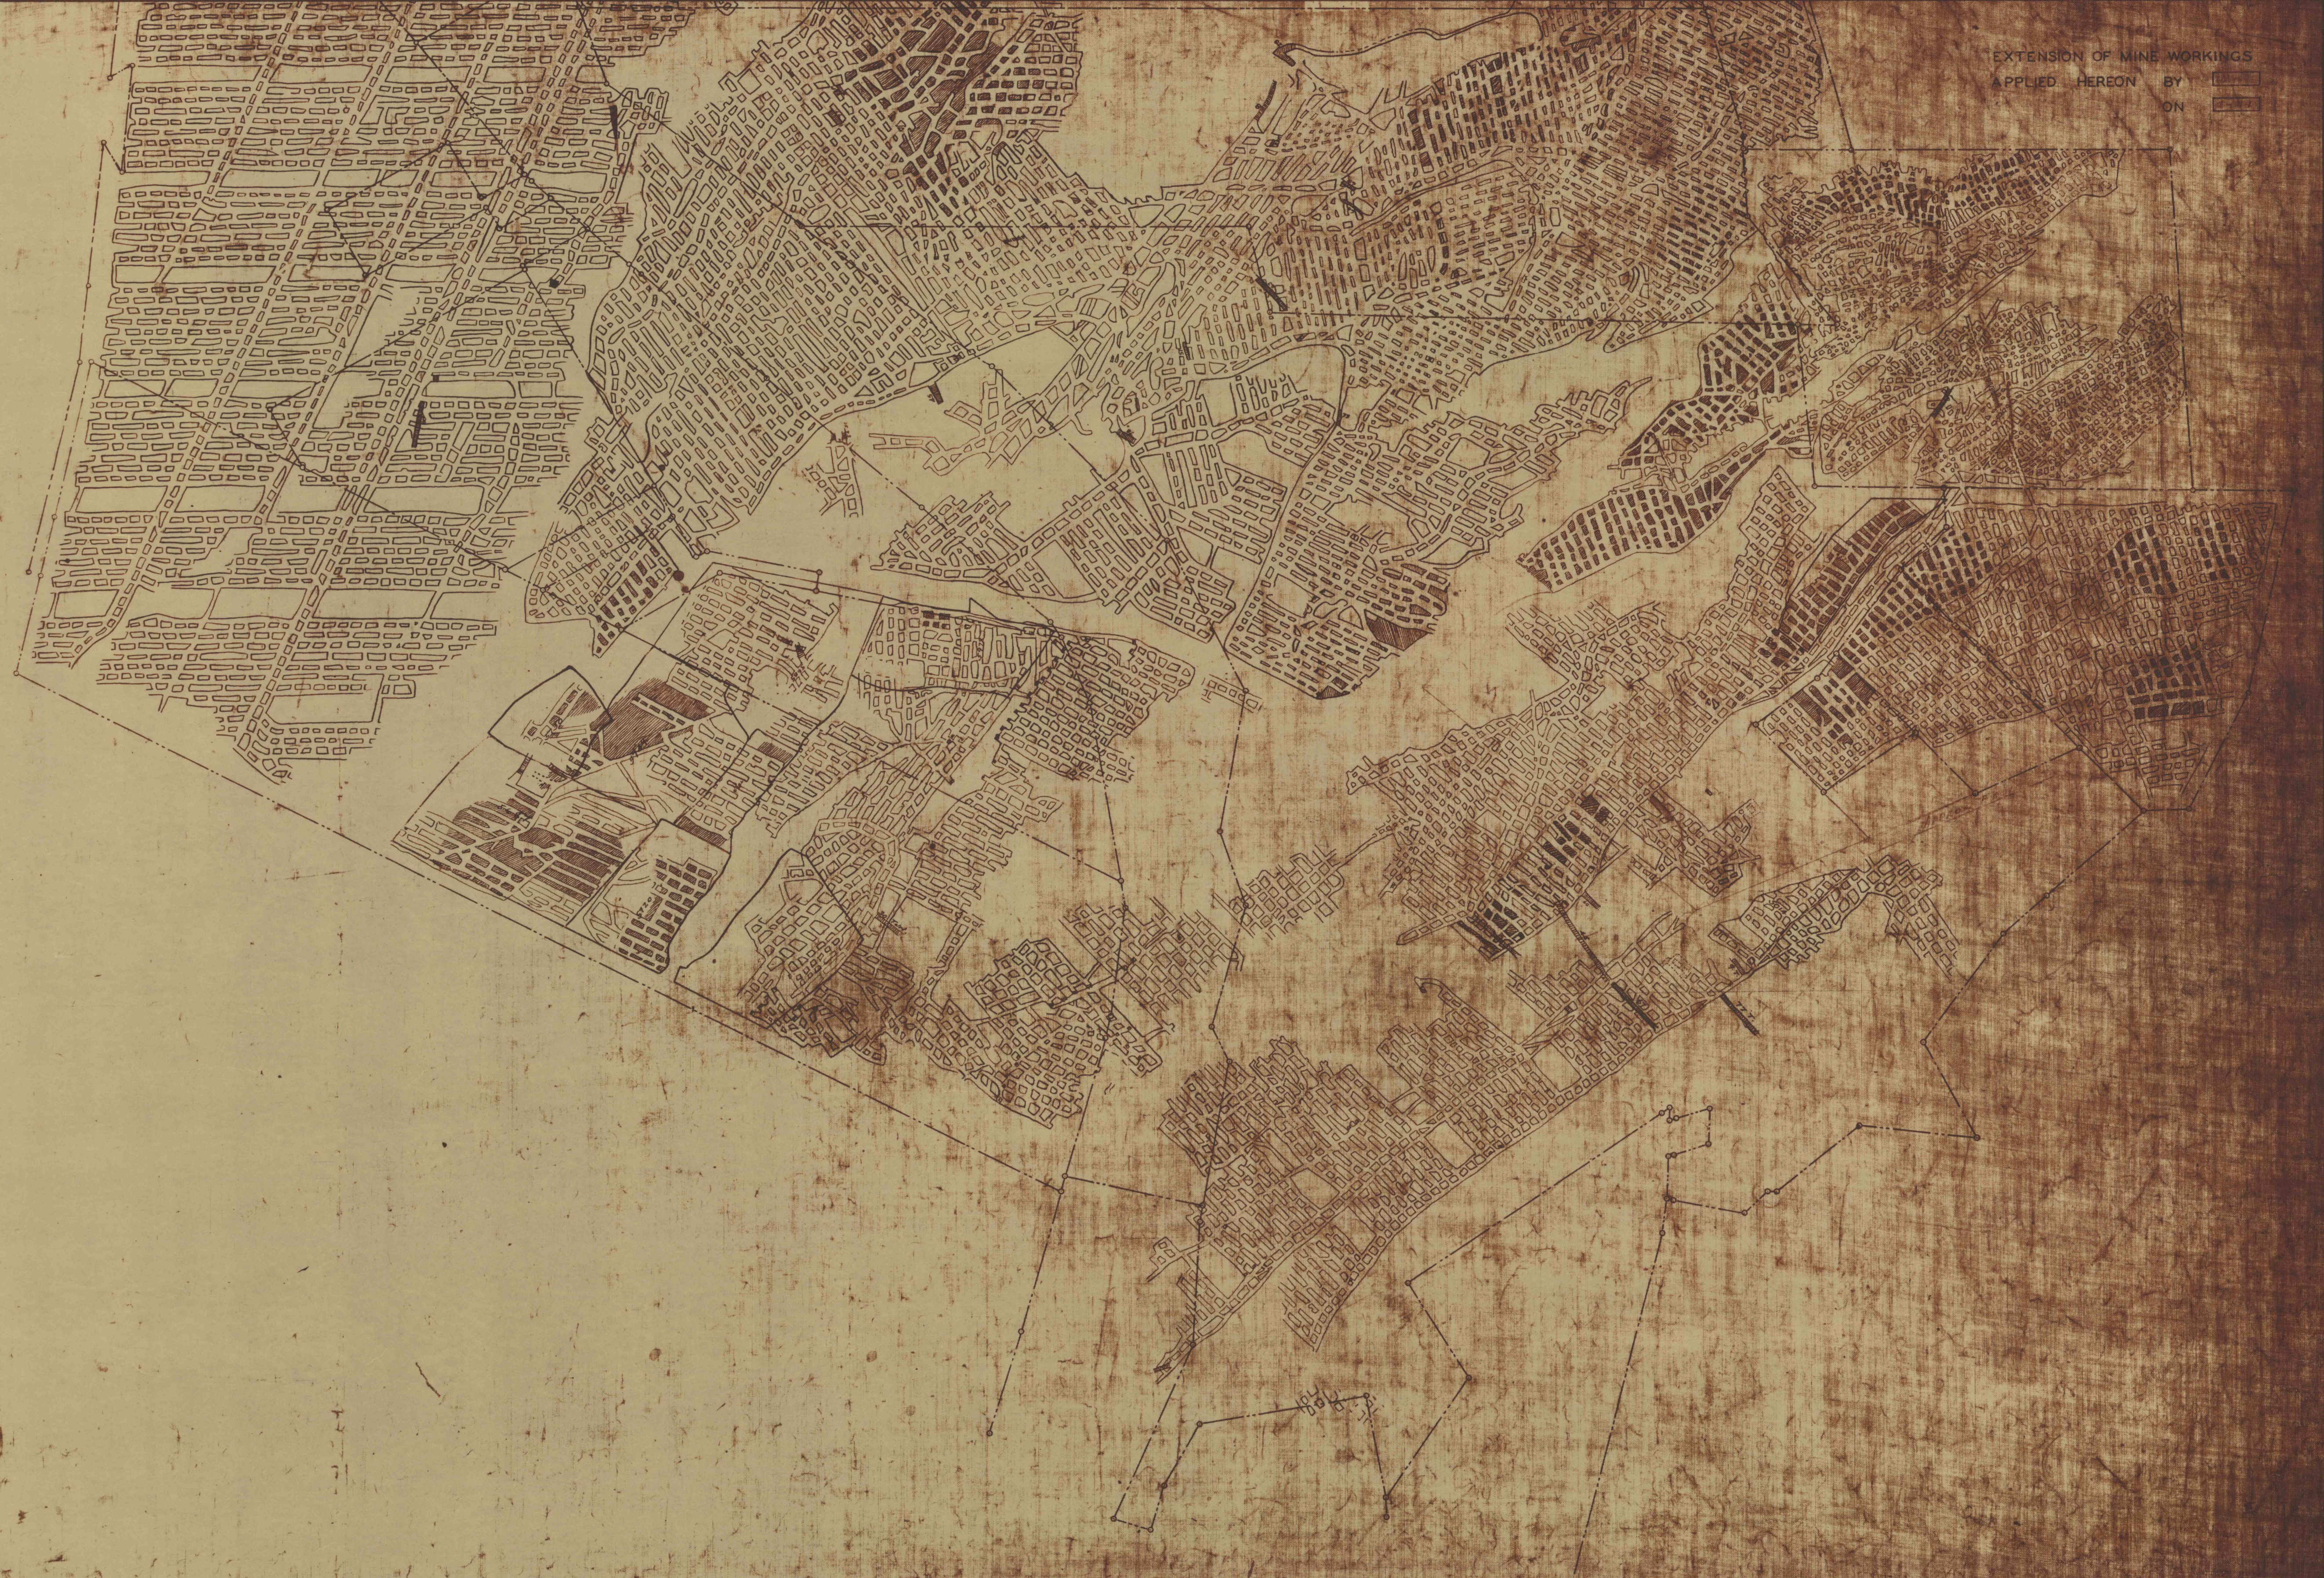

TOP-FIVE-FOOT
LAST POSTING FILING []
ROBBING []