
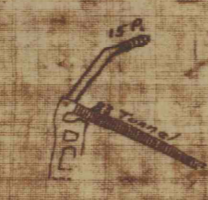


EXTENSION OF MINE WORKINGS

APPLIED HEREON BY   
ON 

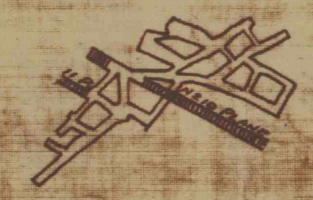

BOTTOM ROSS

LAST POSTING  FILLING  
ROBBING 