


EXTENSION OF MINE WORKINGS
APPLIED HEREON BY []
ON []

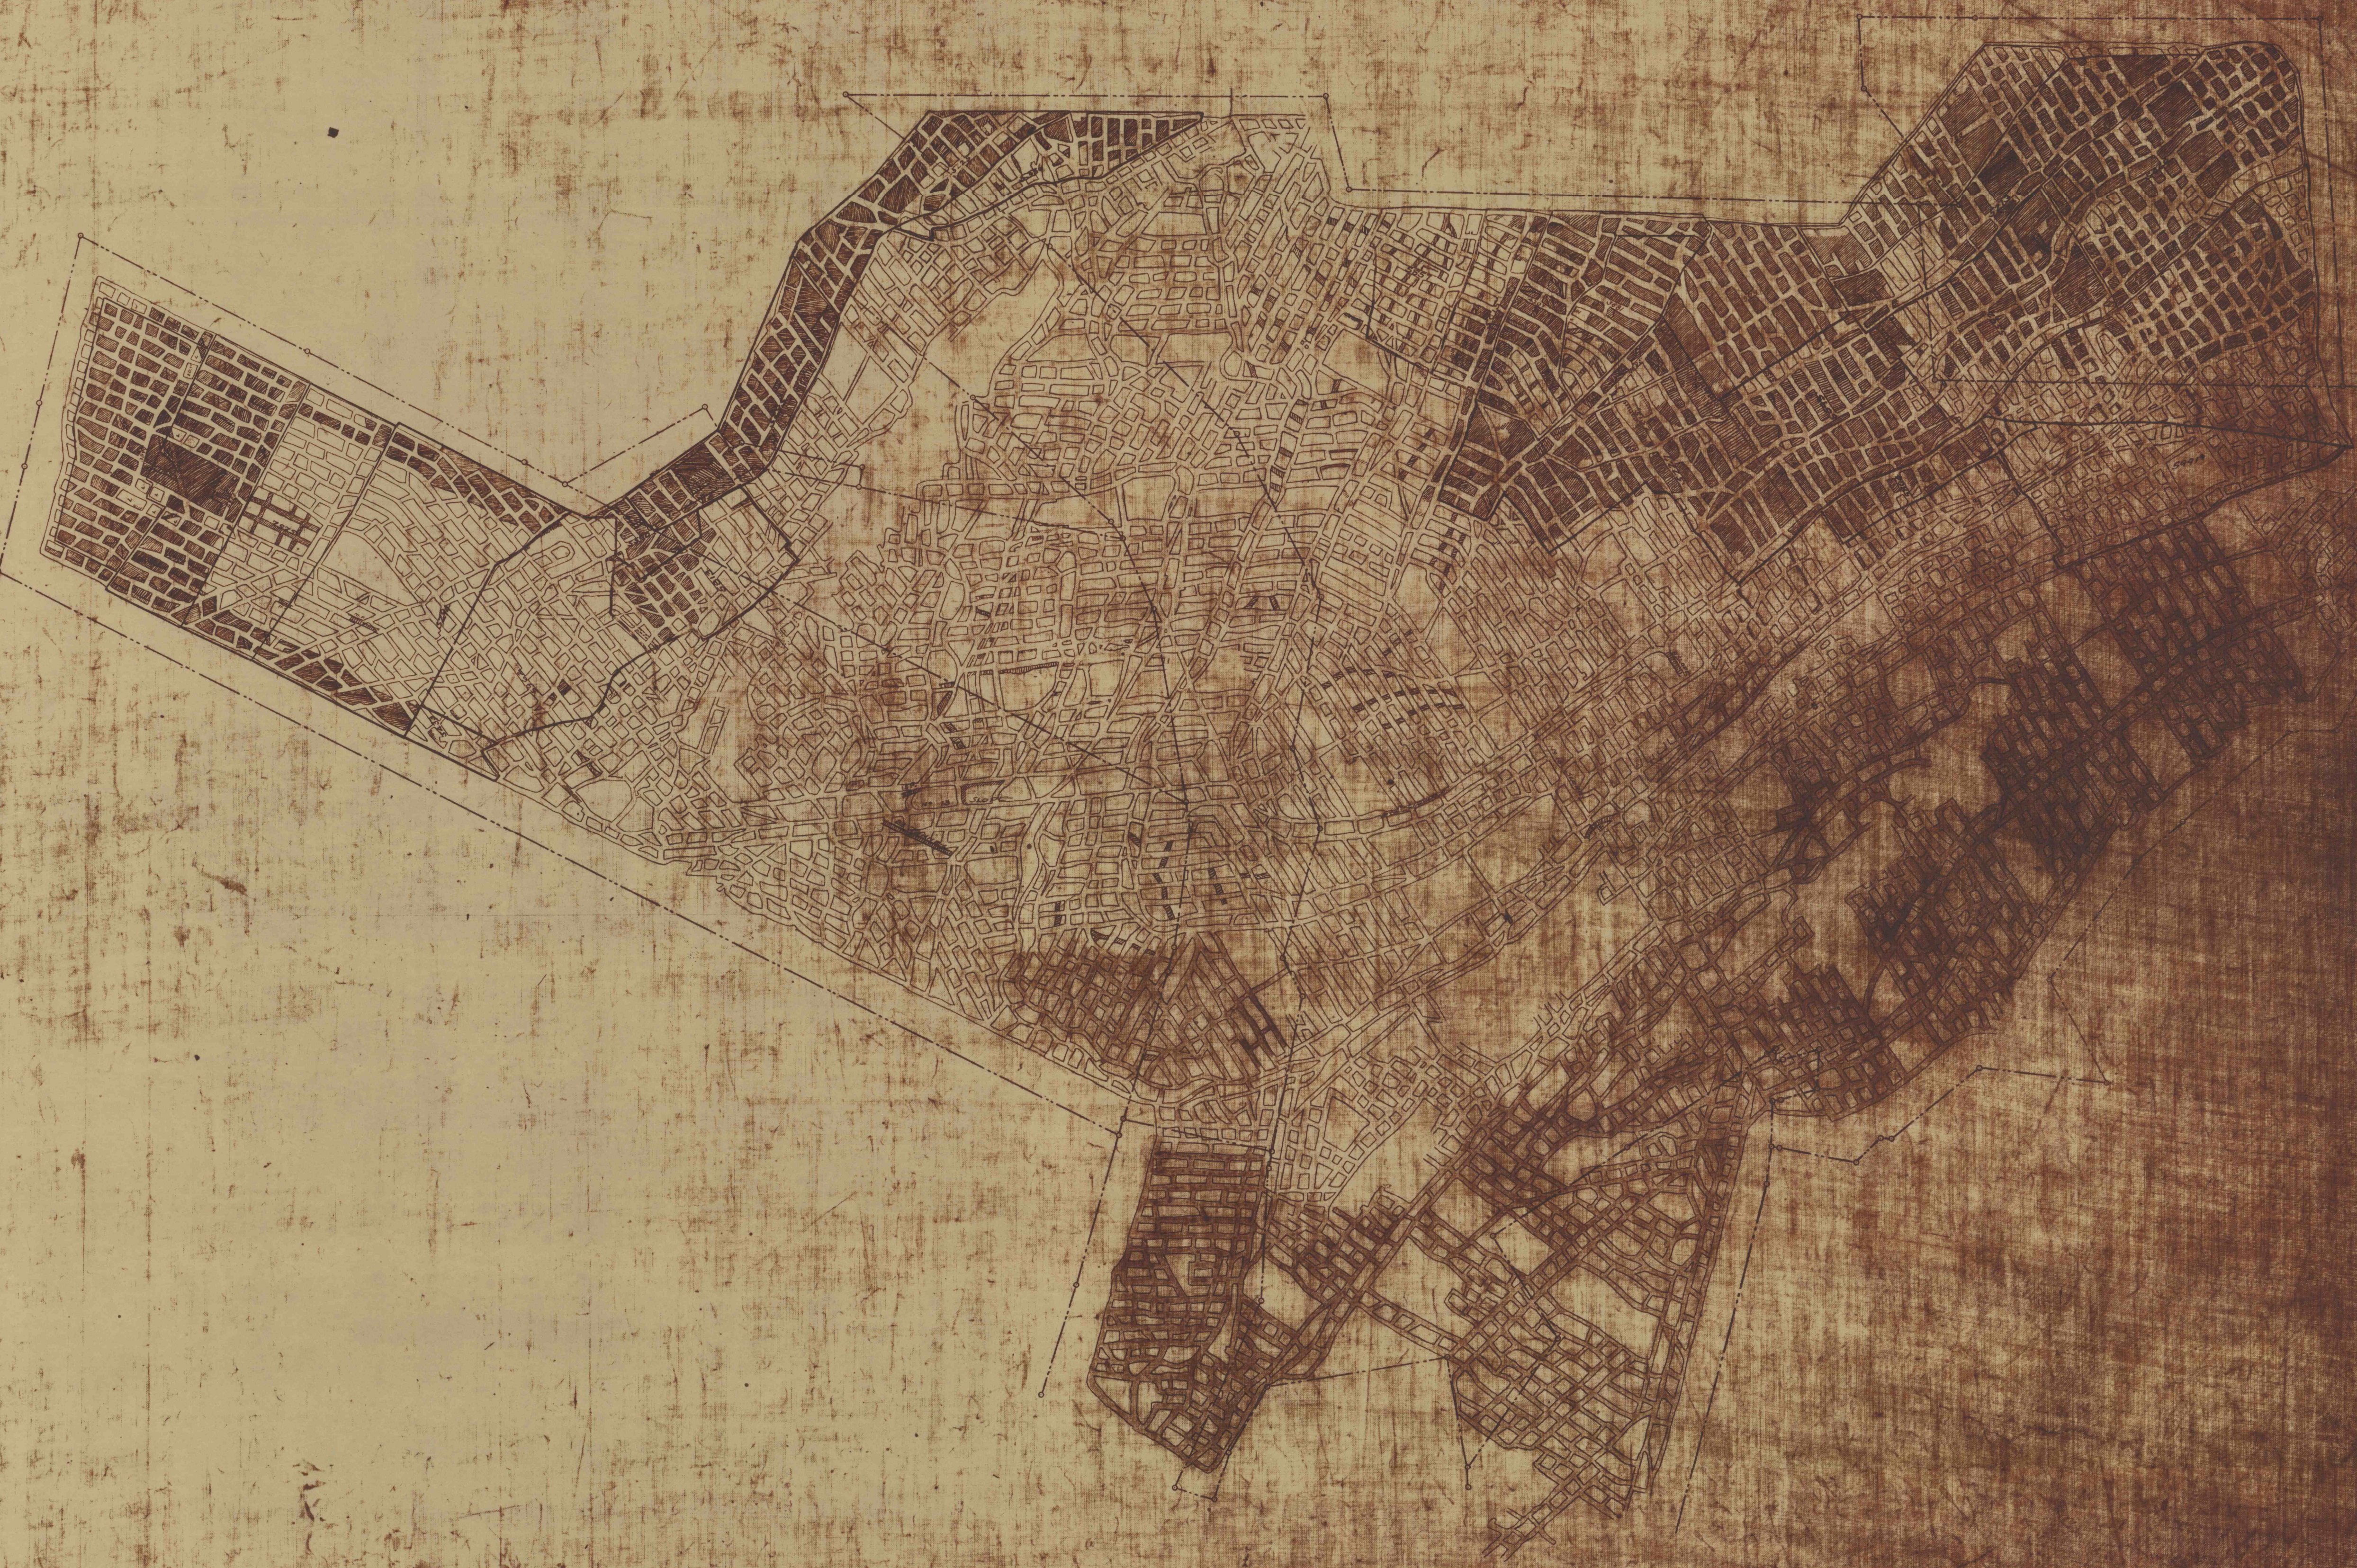

RED ASH
LAST POSTING FILLING
ROBBIN