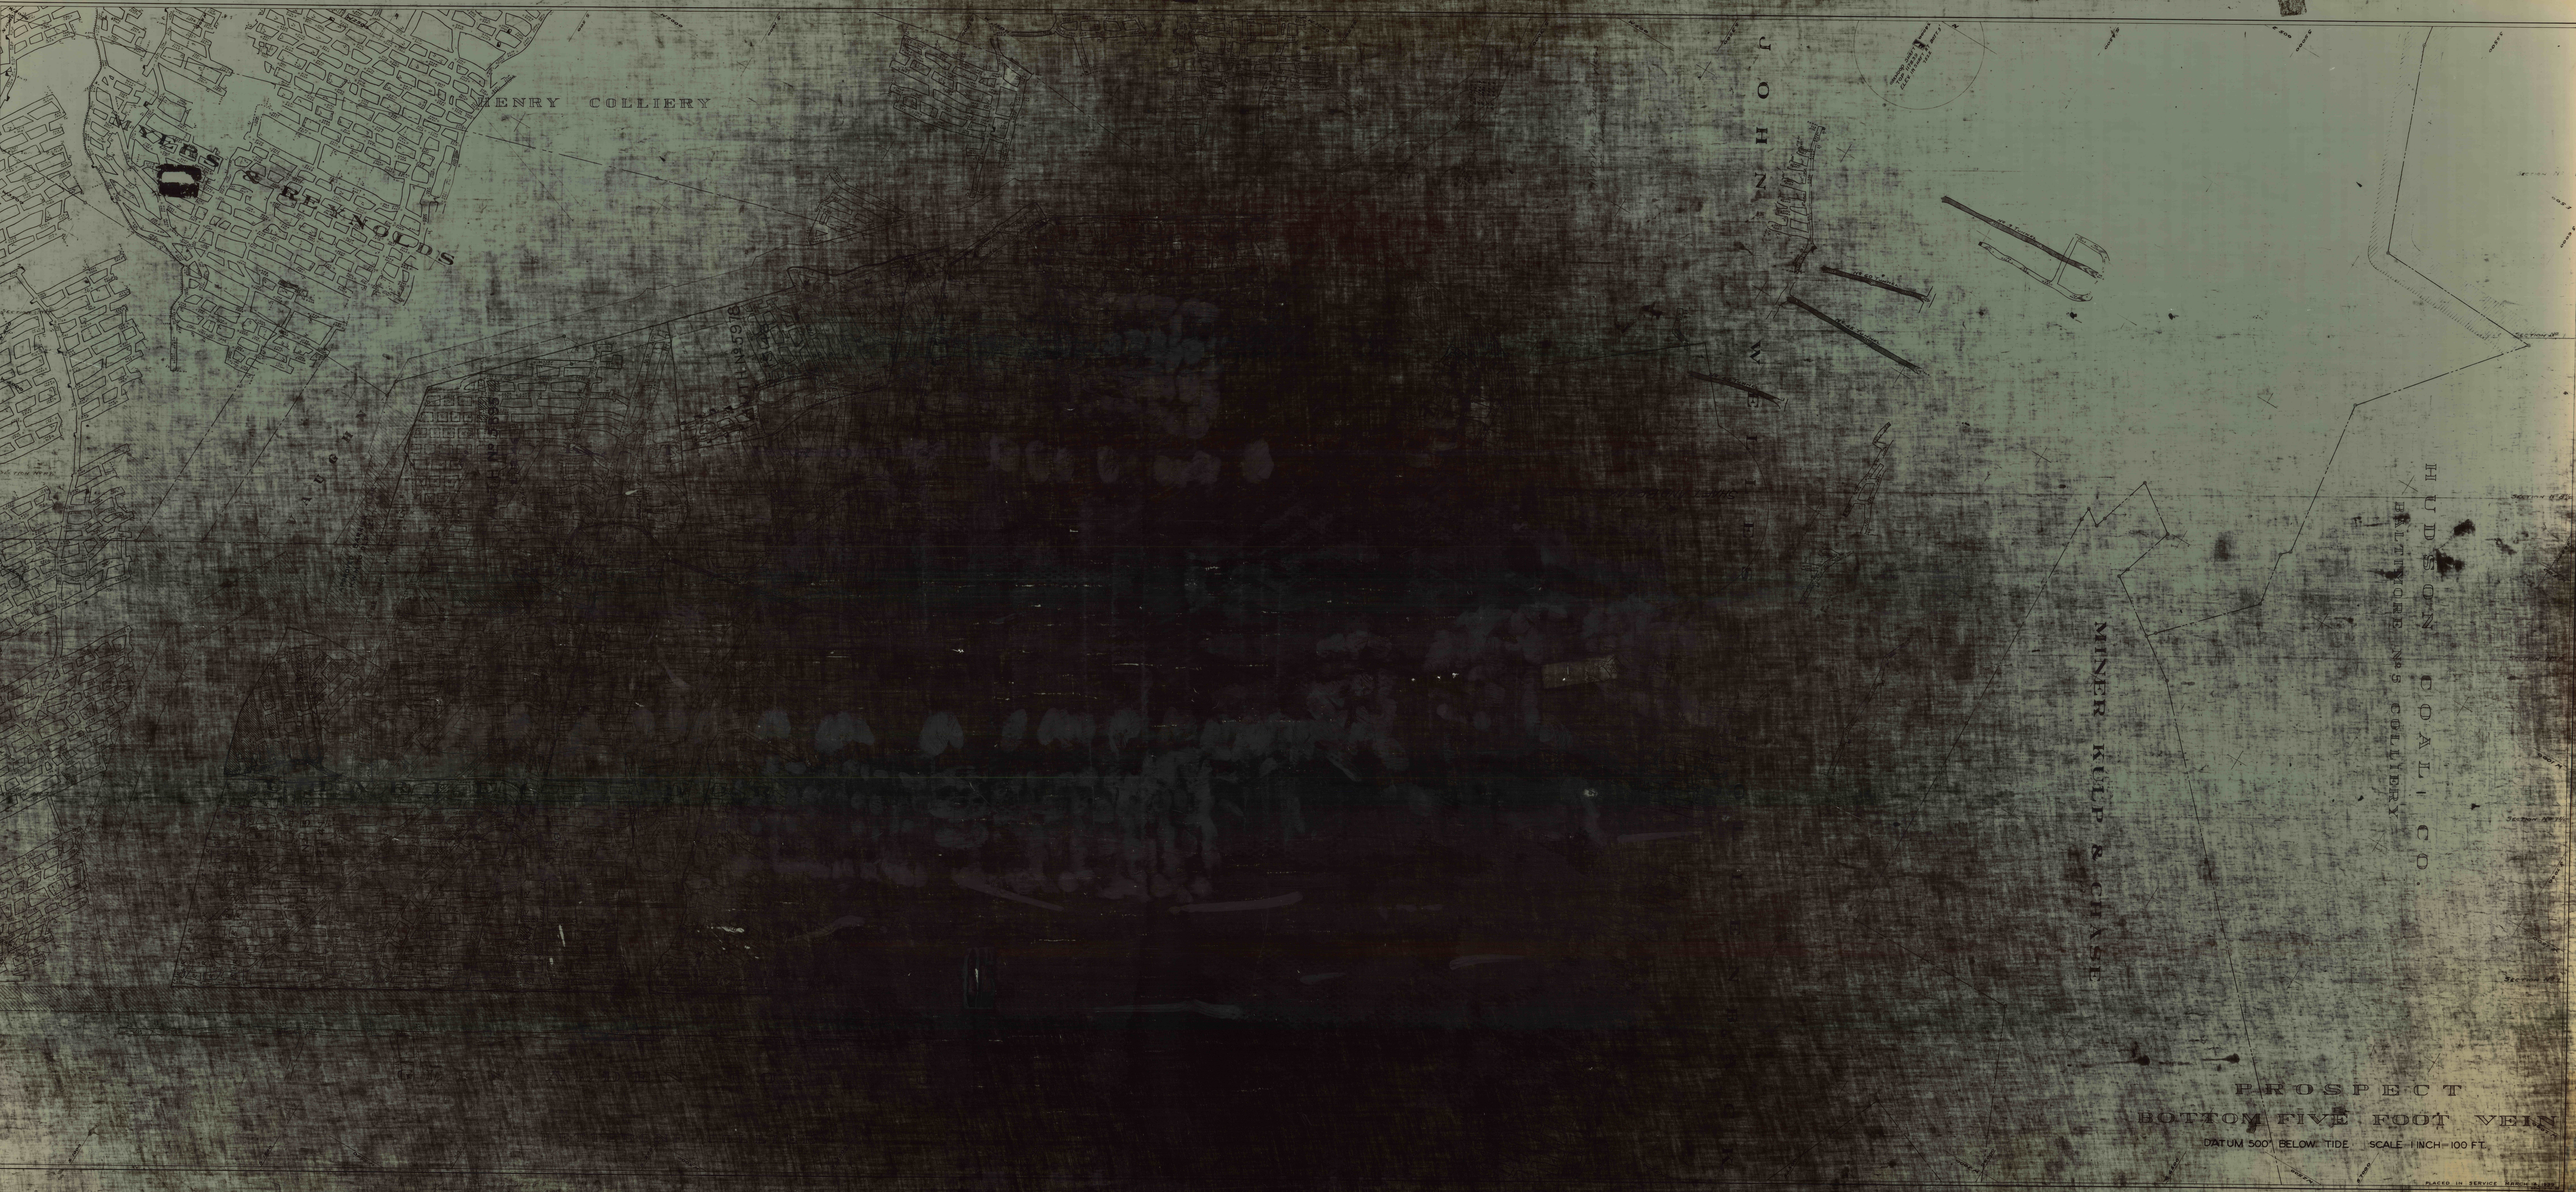
HENRY COLLIERY
MYERS & REYNOLDS
JOHN WELLES
MINER KULP & CHASE
HUDSON COAL CO.
BALTIMORE No 5 COLLIERY
PROSPECT
BOTTOM FIVE FOOT VEIN
DATUM 500' BELOW TIDE. SCALE 1 INCH = 100 FT.