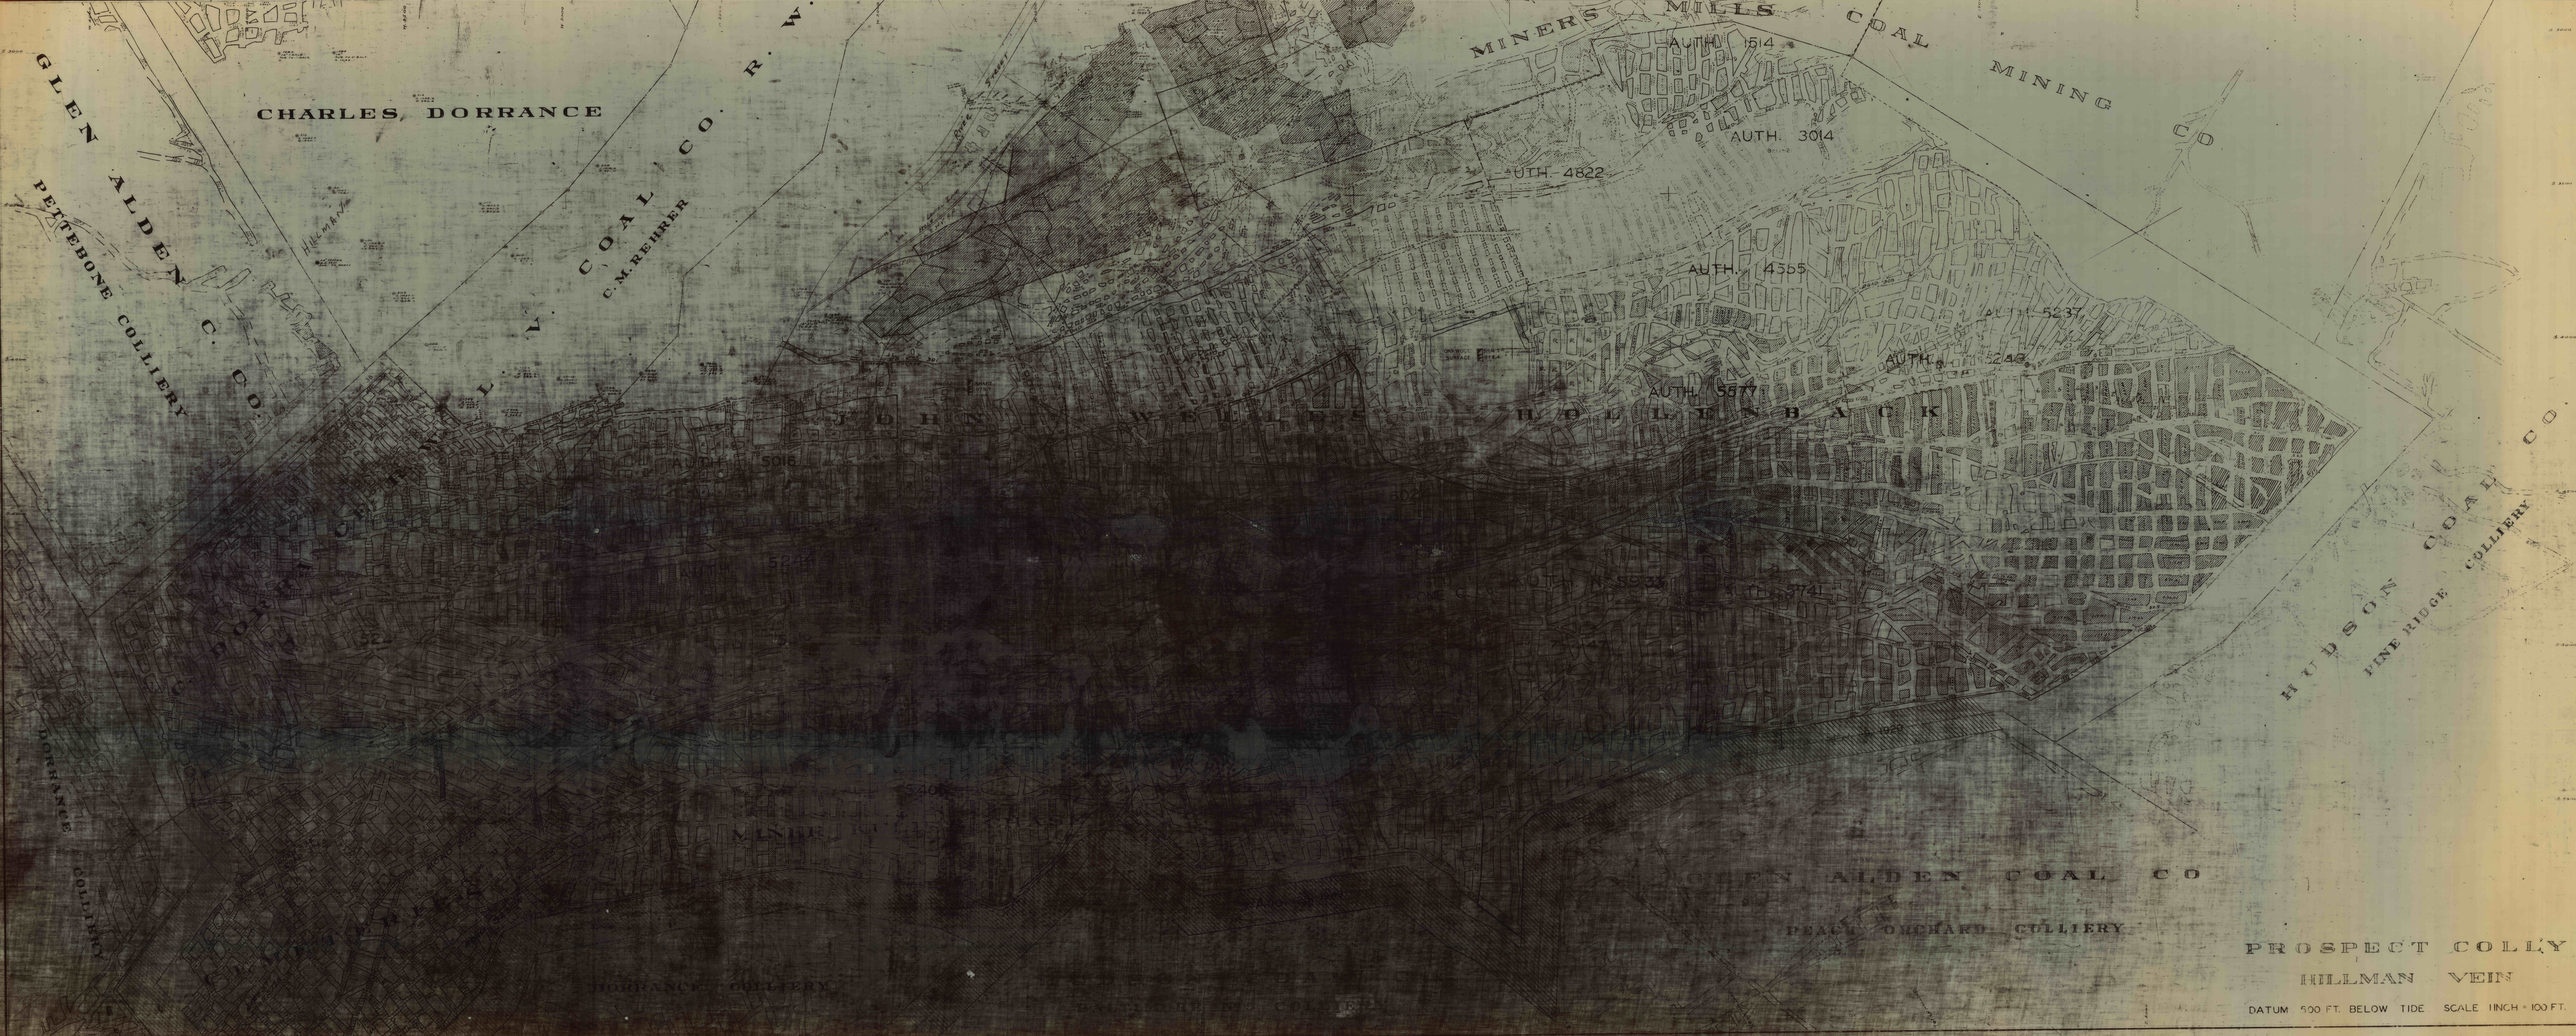
CHARLES, DORRANCE
GLEN ALDEN C. CO.
PETTEBONE COLLIERY
COAL CO
C.M. REHRER
MINERS MILLS
COAL MINING CO
AUTH. 1514
AUTH. 3014
AUTH. 4822
AUTH. 4355
AUTH. 5237
AUTH. 5240
AUTH. 5577
AUTH. 5016
AUTH. 5938
AUTH. 5741
HILLMAN
JOHN WEIRES
HOLLENBACK
HUDSON COAL CO
PINE RIDGE COLLIERY
DORRANCE COLLIERY
GLEN ALDEN COAL CO
PEACE ORCHARD COLLIERY
DORRANCE COLLIERY
PROSPECT COLLY
HILLMAN VEIN
DATUM 500 FT. BELOW TIDE SCALE 1 INCH = 100 FT.