


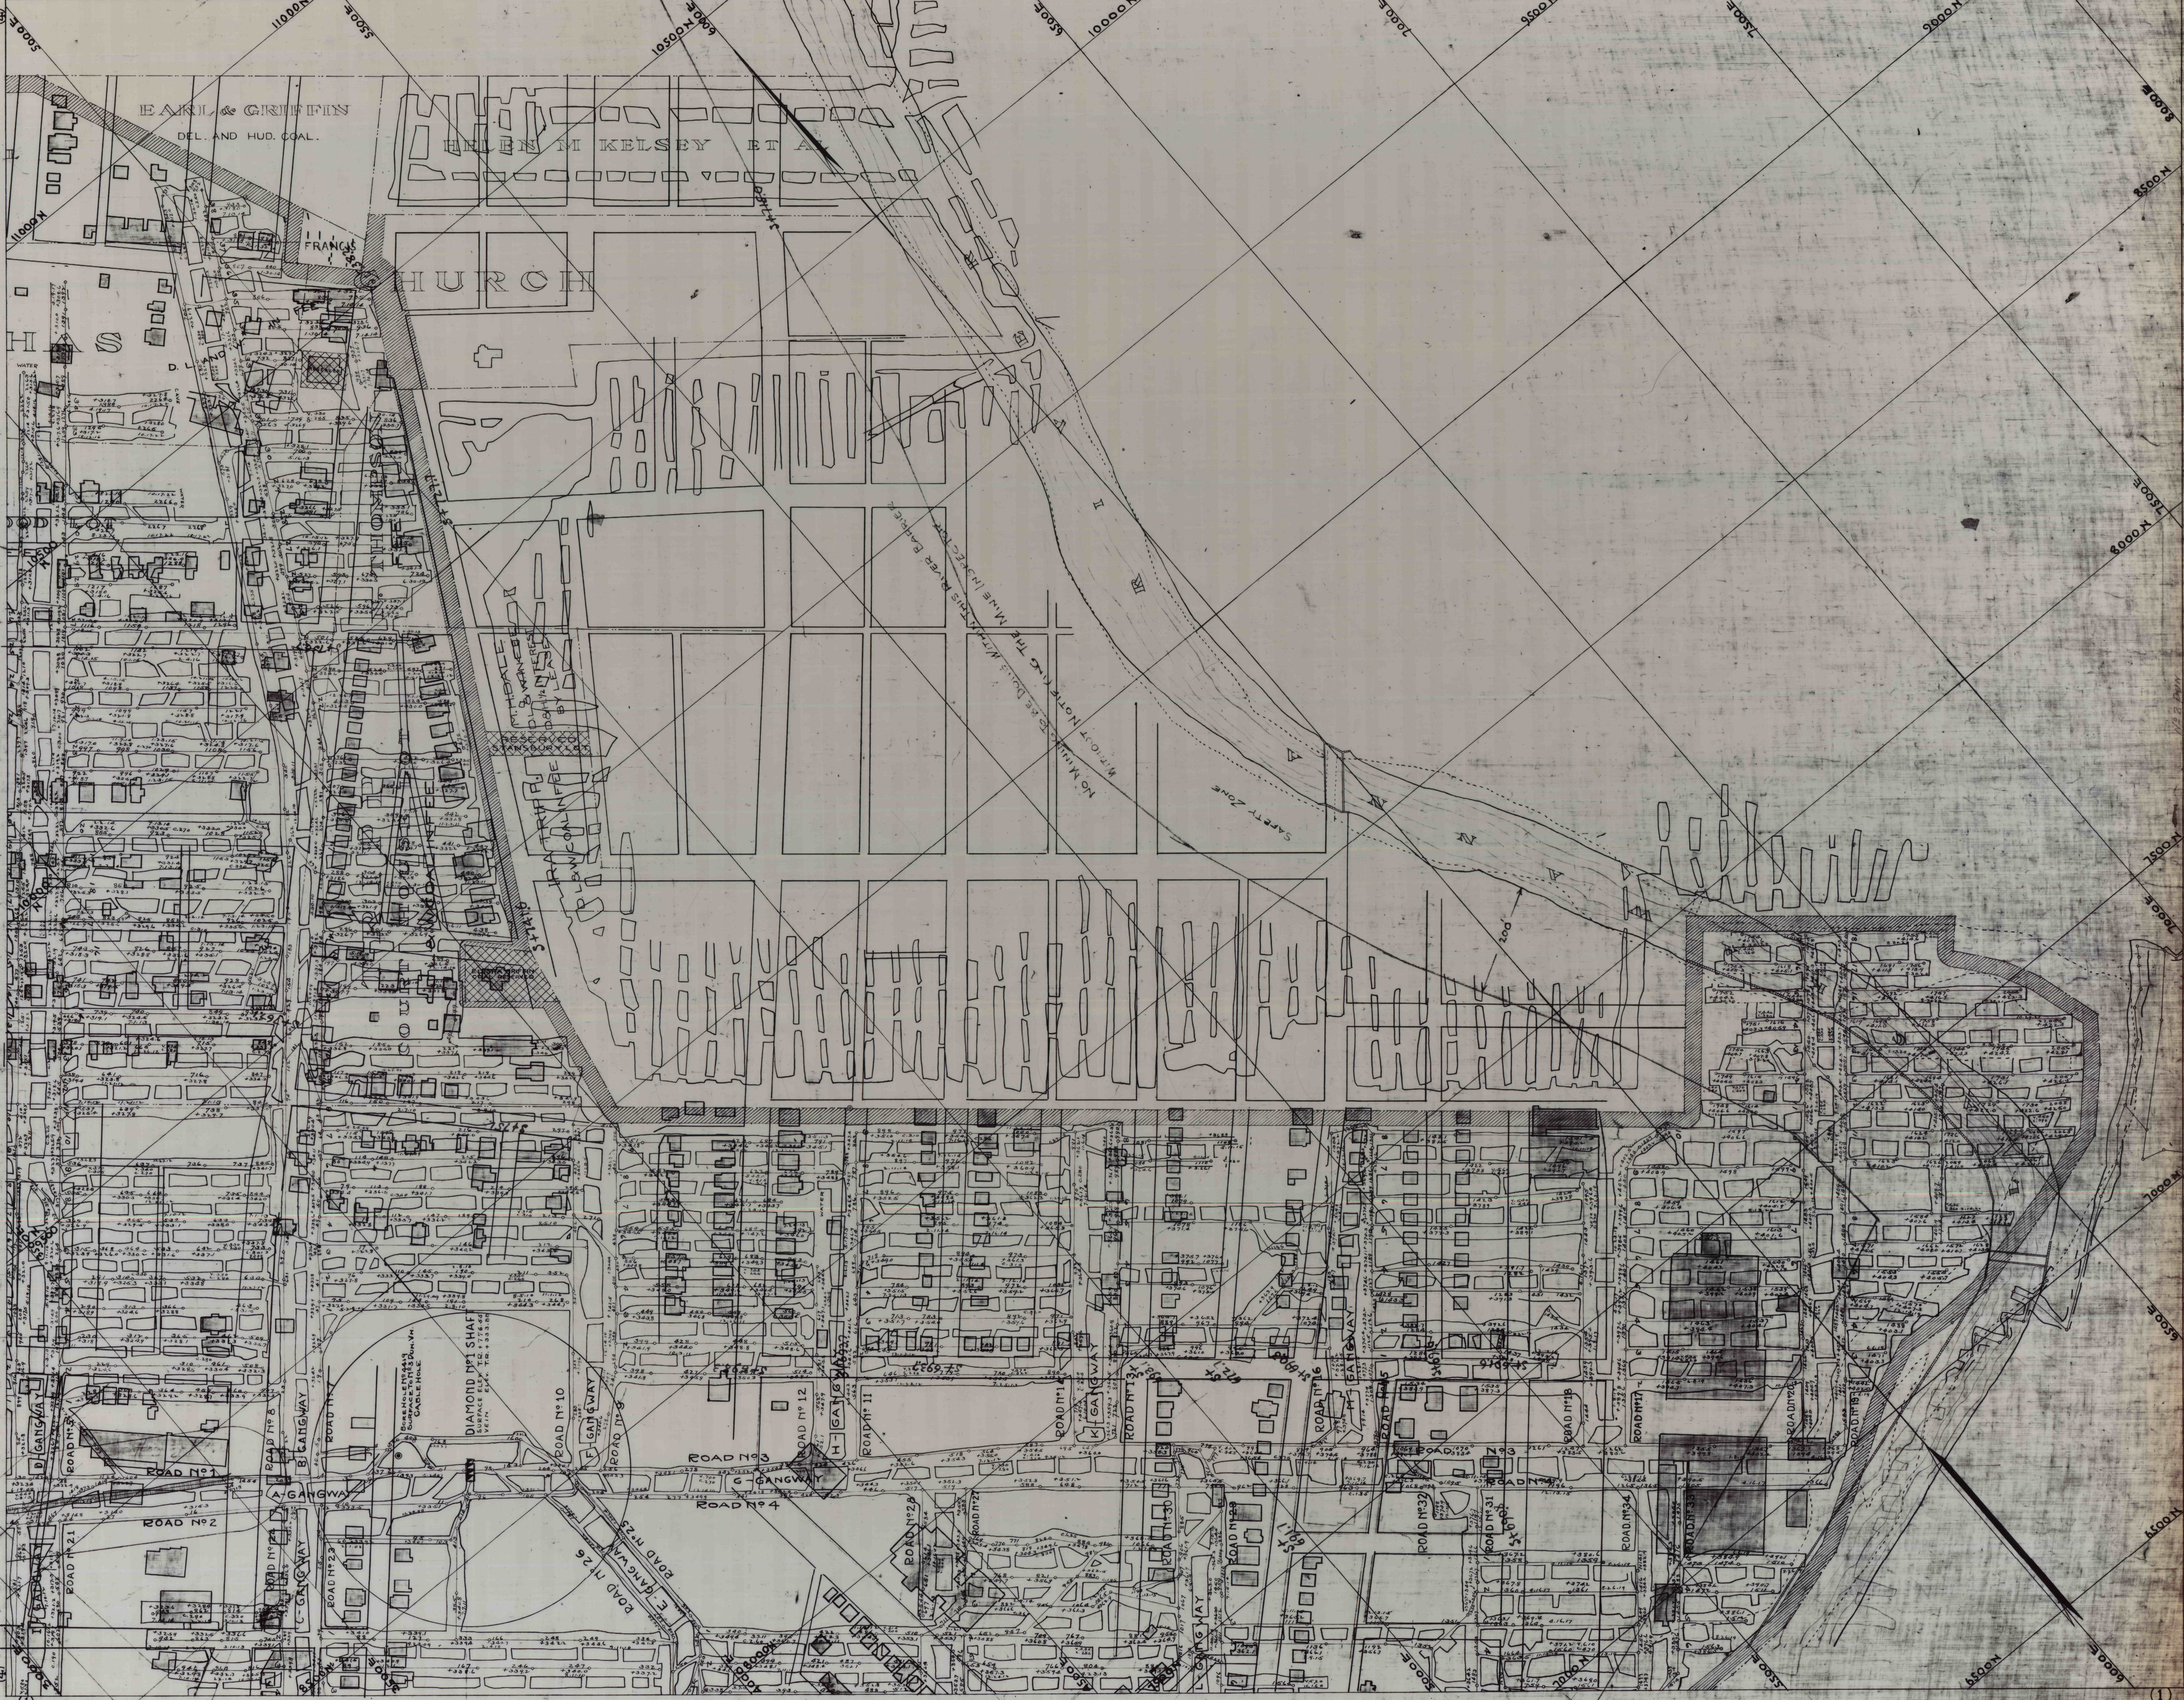

DIAMOND COLL'Y. NO 2 DUNMORE BED