


750'


SECTION - 8 -

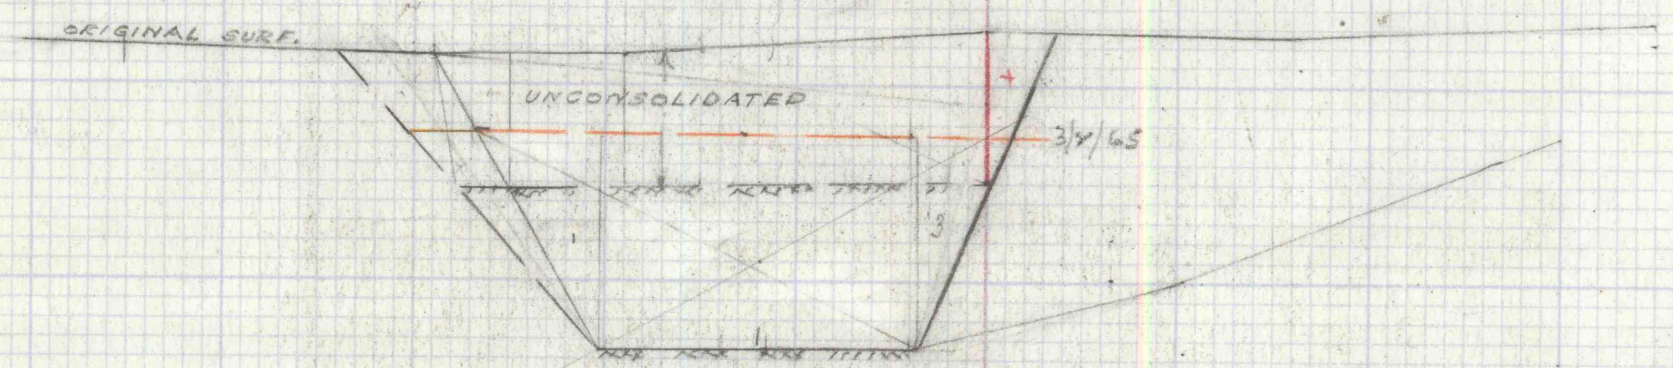

750'


750'

SECTION - 9 -

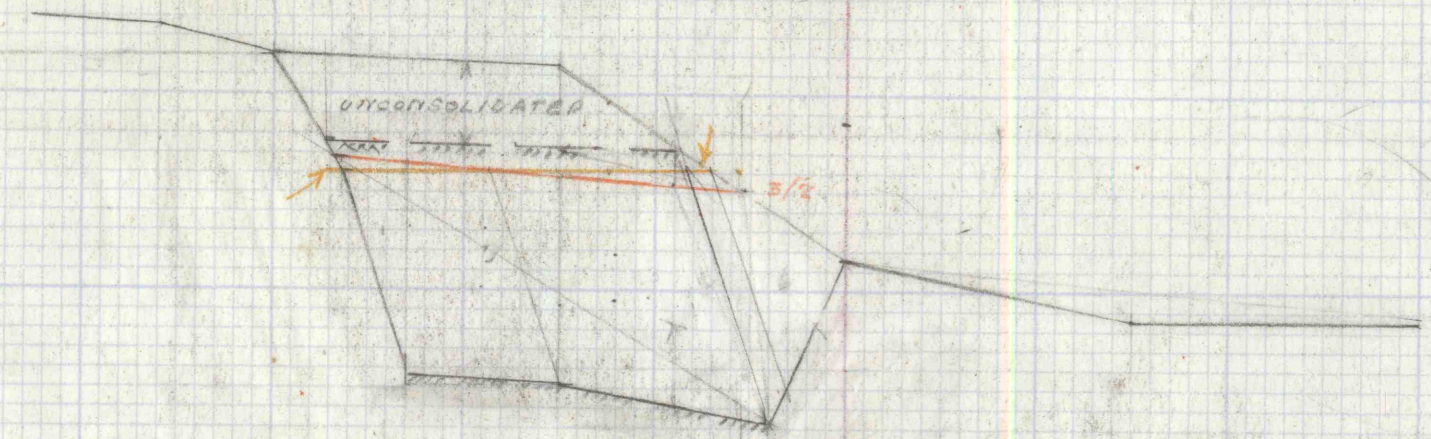


750'

SECTION - 10 -

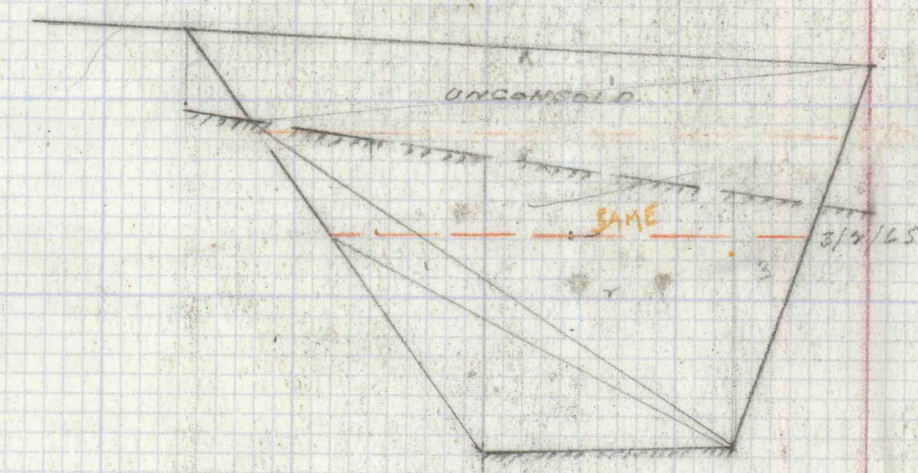

750'

SECTION - 11 -

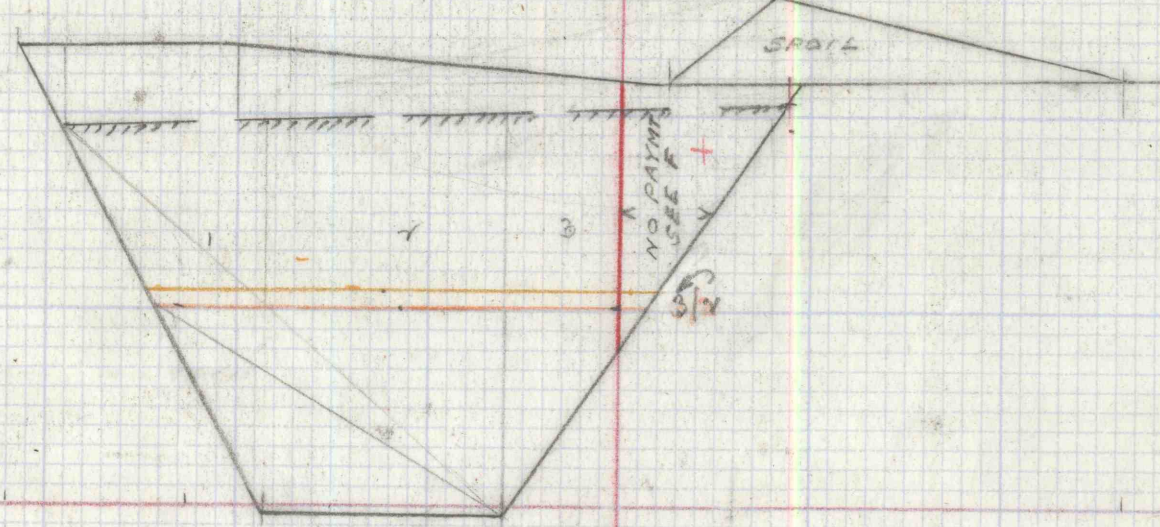

750'

SECTION 12

PLAINS TWP. MINE FIRE  
 PROJECT NR-64  
 VERTICAL SCALE 1"=20'  
 HORIZONTAL SCALE 1"=20'