


See No. 2 Dunmore  
Plan No. 1 for additional workings  
in this area. QUINCY CO  
CLAY AVENUE

No. 2-DUNMORE

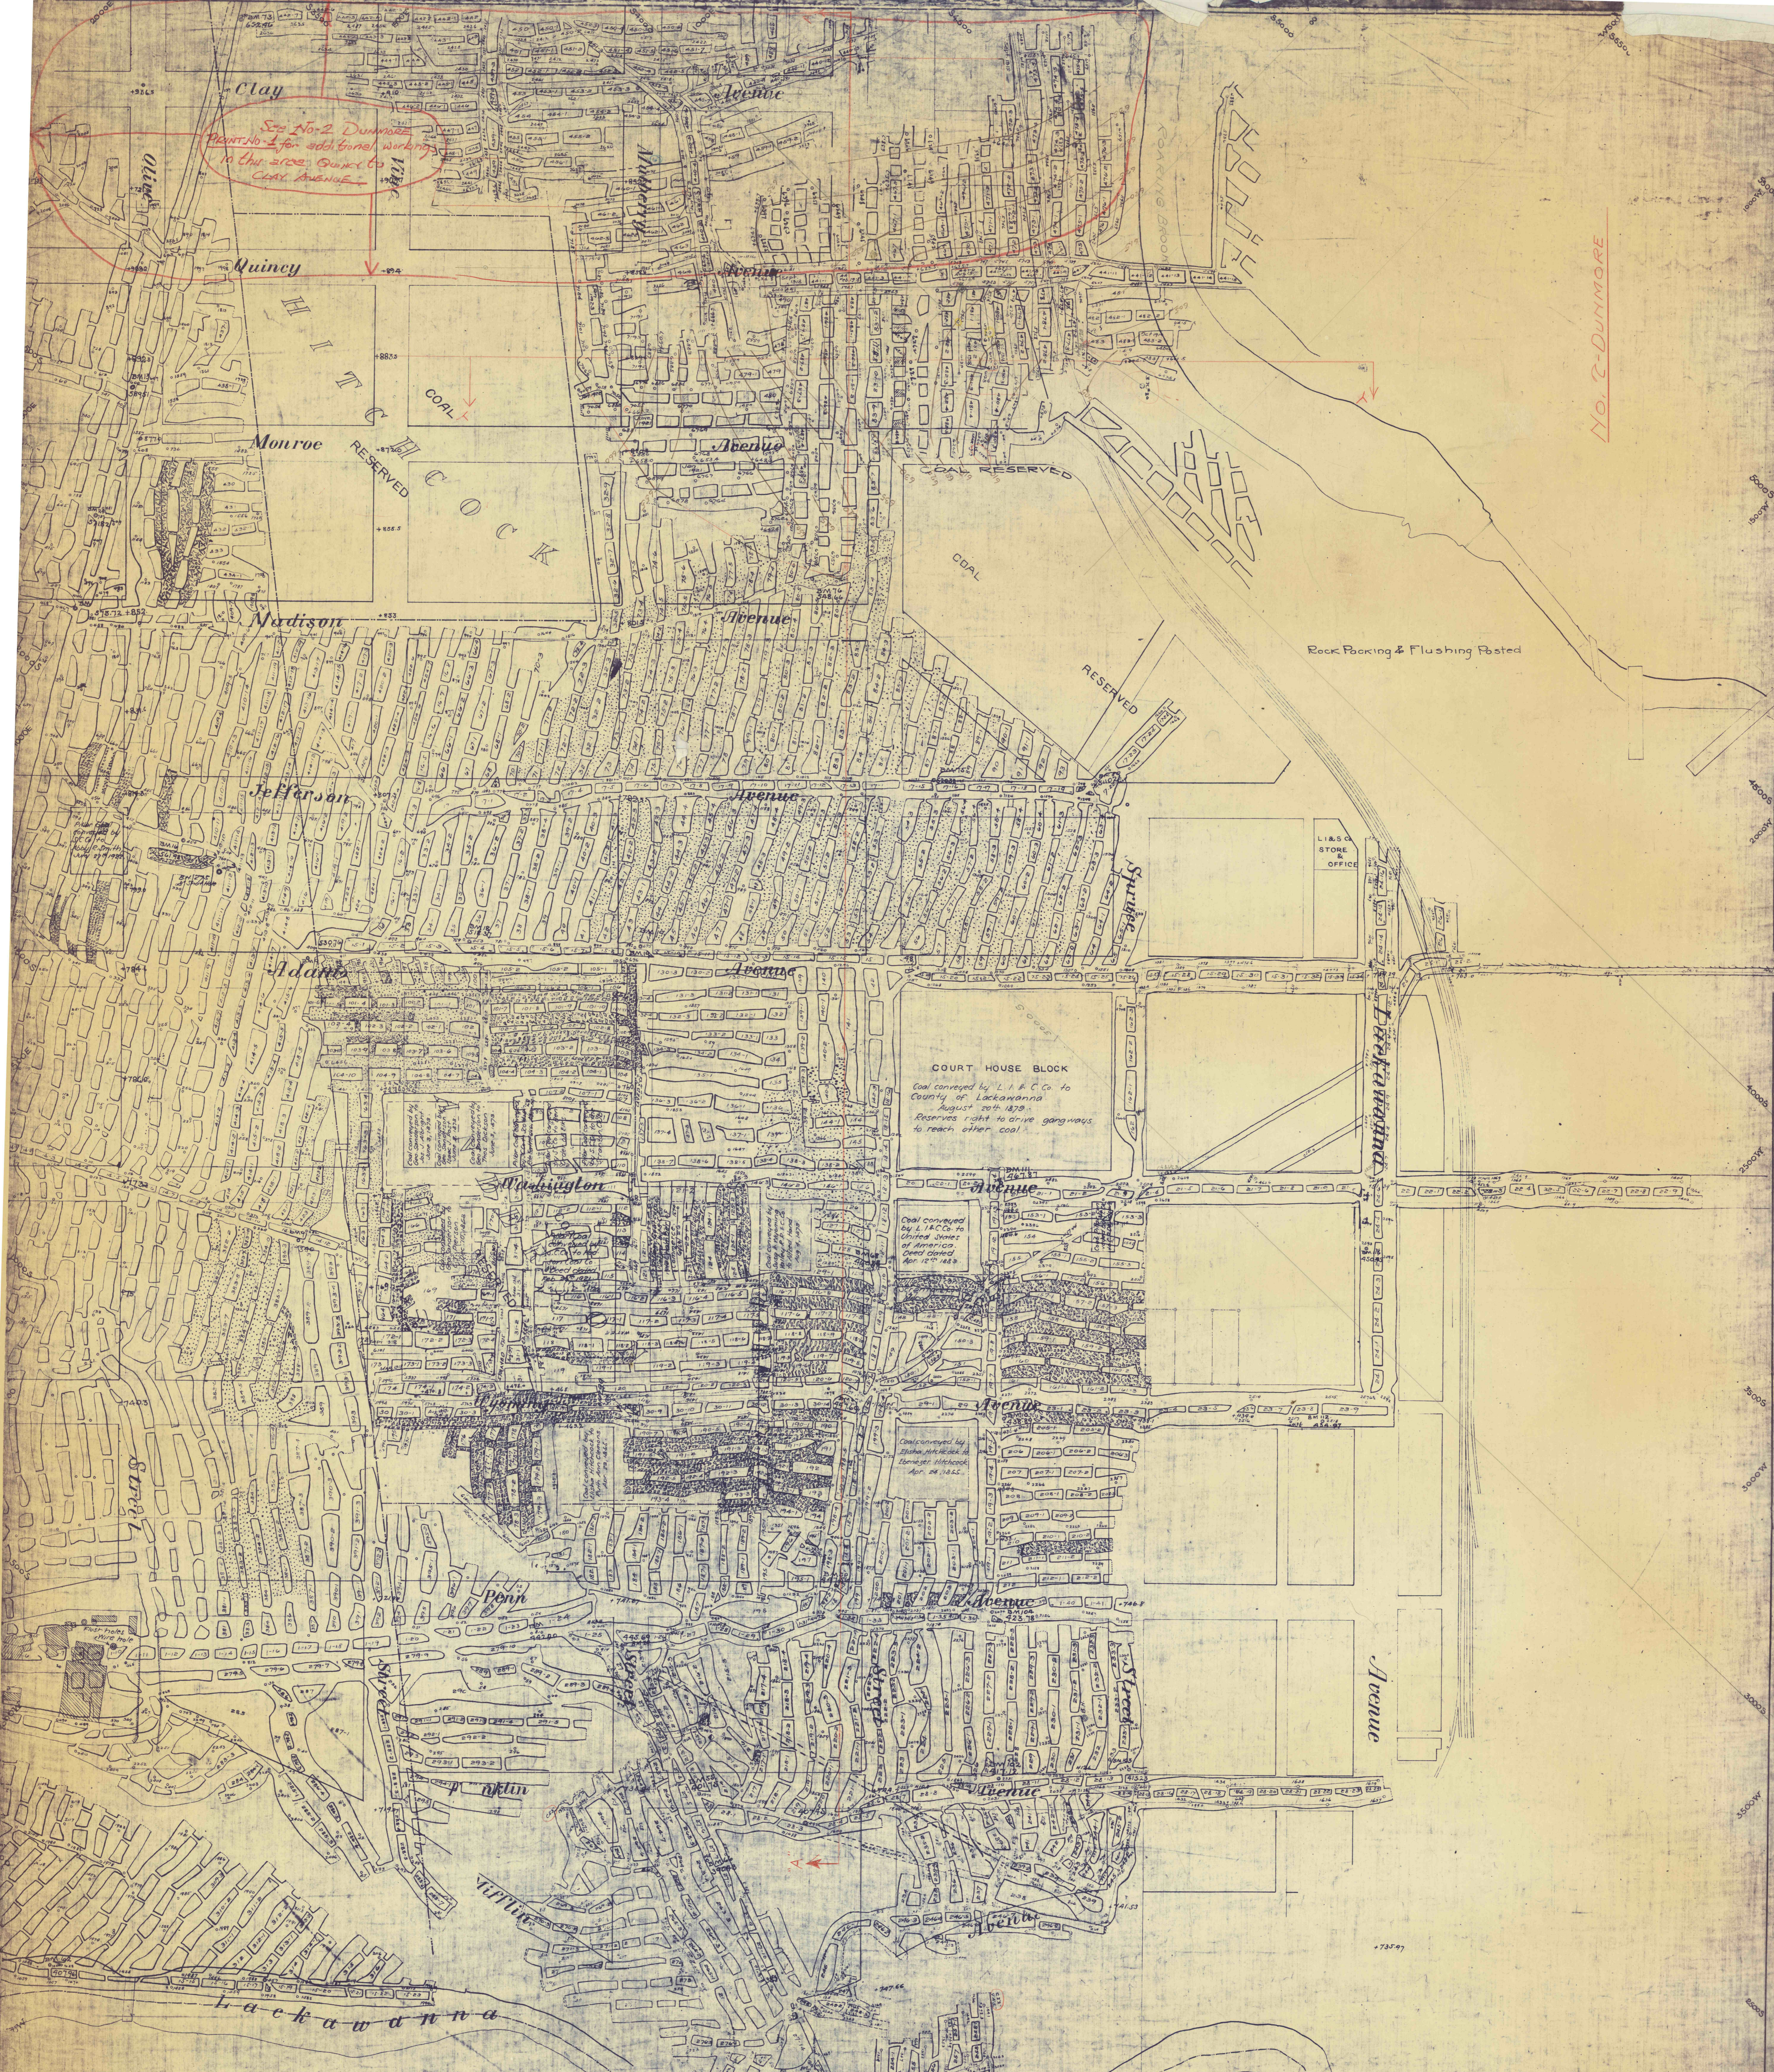

COURT HOUSE BLOCK  
Coal conveyed by L. I. & C. Co. to  
County of Lackawanna  
August 20th 1879  
Reserves right to drive gangways  
to reach other coal

Coal conveyed  
by L. I. & C. Co. to  
United States of America  
April 12th 1883

Coal conveyed by  
Homer H. Hitchcock  
April 26 1855

MAP  
SHOWING

No. 2 Dunmore Vein Workings "Plan" No. 1

West of Olive Street

PINE BROOK MINE

Scale 1"=100

SCRANTON Pa. MAY 29th 1899

C. D. Root  
Mining Engineer  
112 Centre St.