


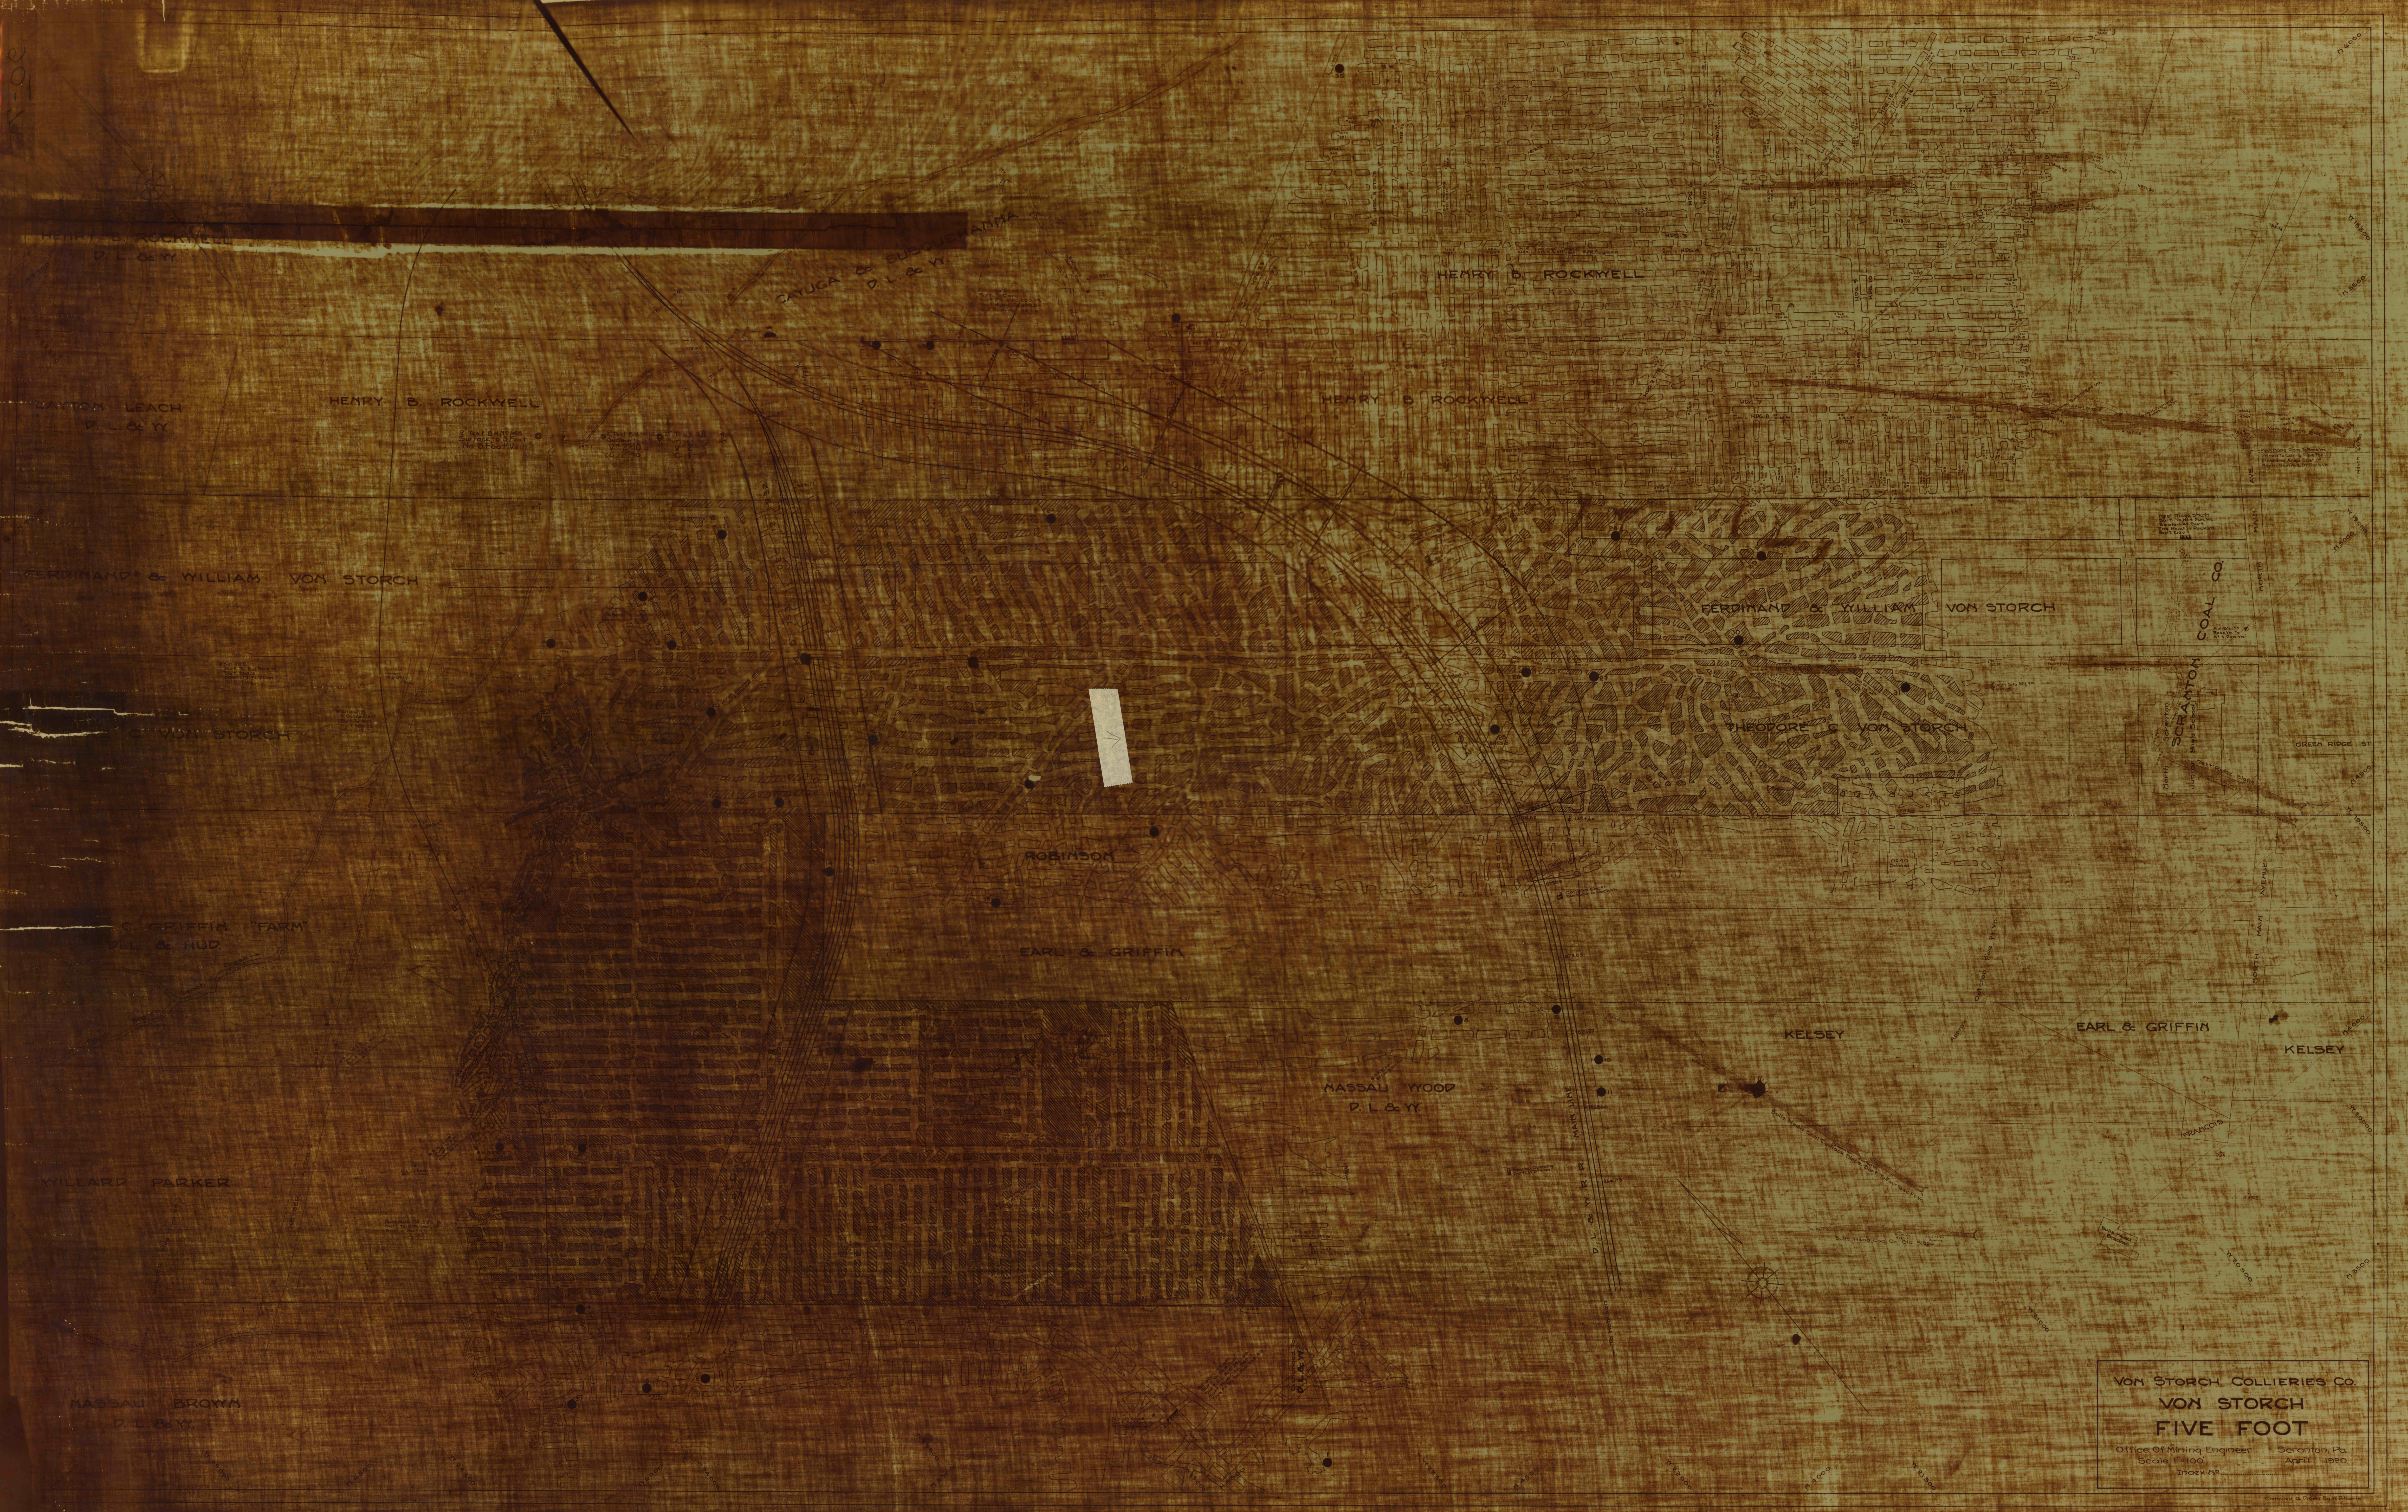

VON STORCH COLLIERIES CO.
VON STORCH
FIVE FOOT
Office of Mining Engineers
Scale 1"=100'
Scranton, Pa.
April 11, 1920.
Index No.