

30 INCH VEIN
WEST RIDGE COLLIERY
SCALE 1" = 100'

ROBINSON TRACT


T. C. VON STORCH TRACT

FERD VON STORCH TRACT

No. 2 Duane

Main Shaft

No. 40 Shaft

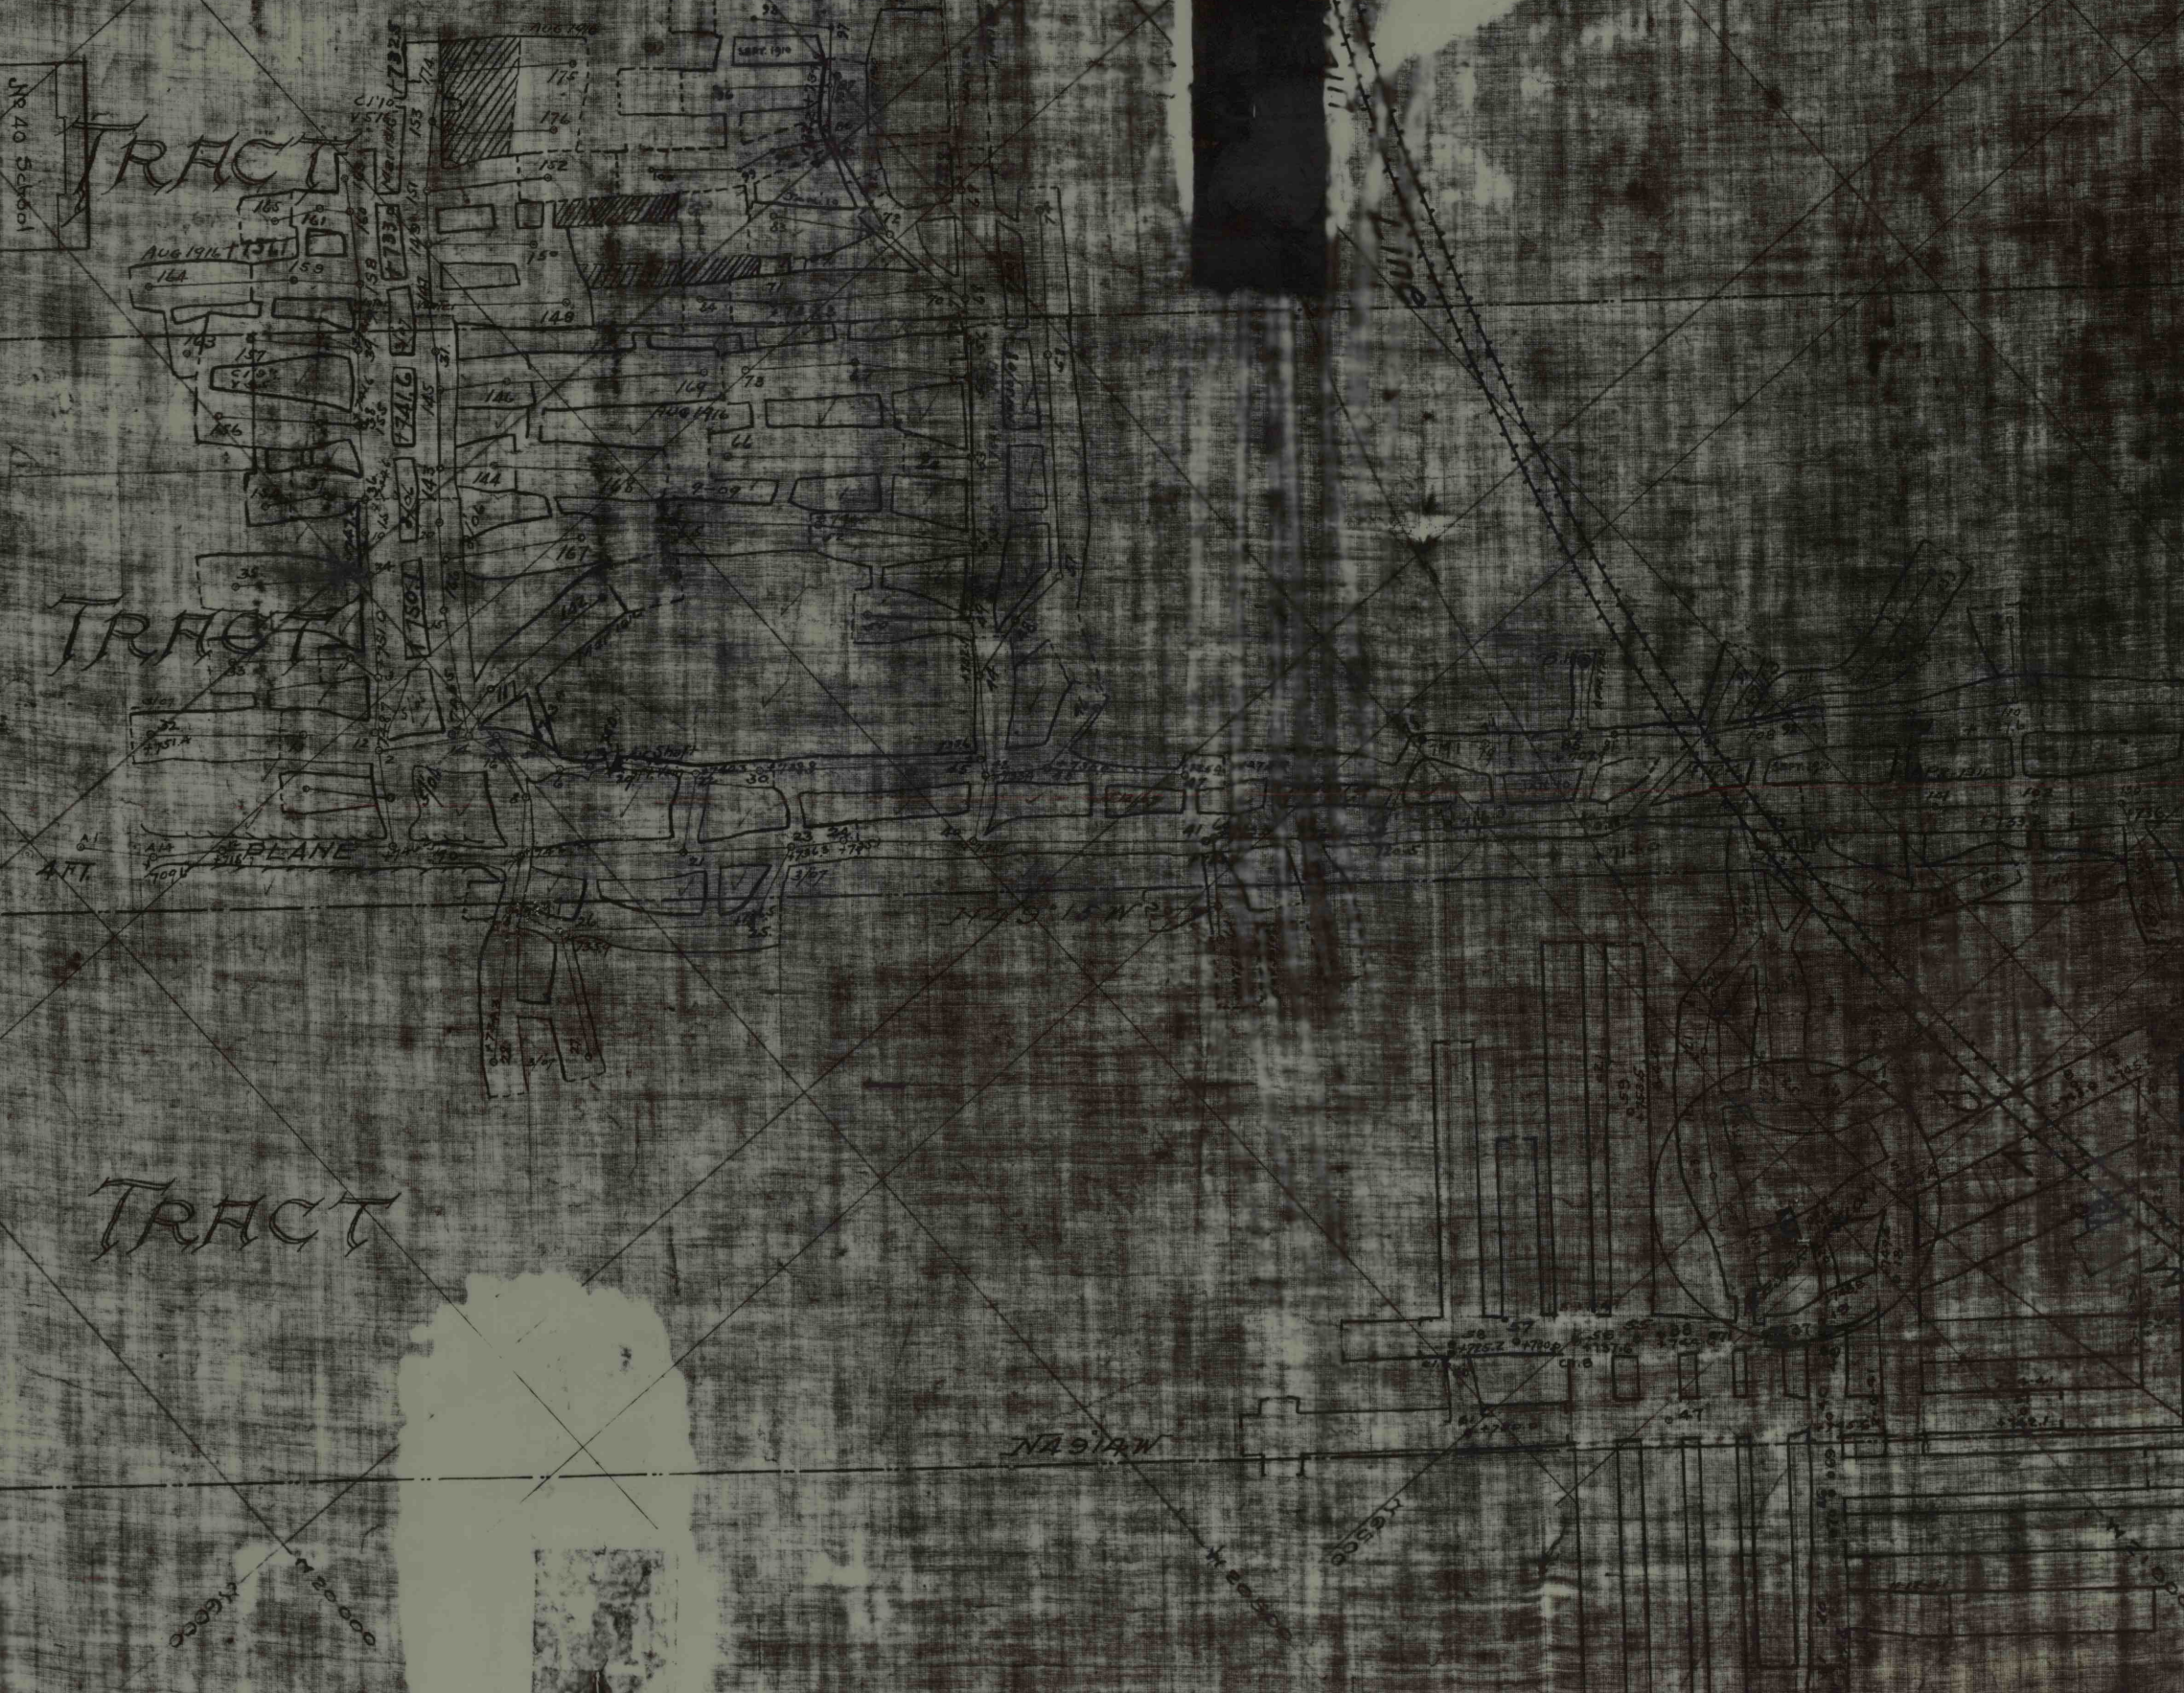

Lackey

NORTH

SOUTH