

LAYTON LEACH
GLEN ALDEN

HENRY B. ROCKWELL


FERDINAND & WILLIAM VON STORCH

THEODORE C. VON STORCH

PHILLIP C. GRIFFIN
"FARM"

WILLARD PARKER
"MILLER LOT"

HARRY TAYLOR
NEW COUNTY

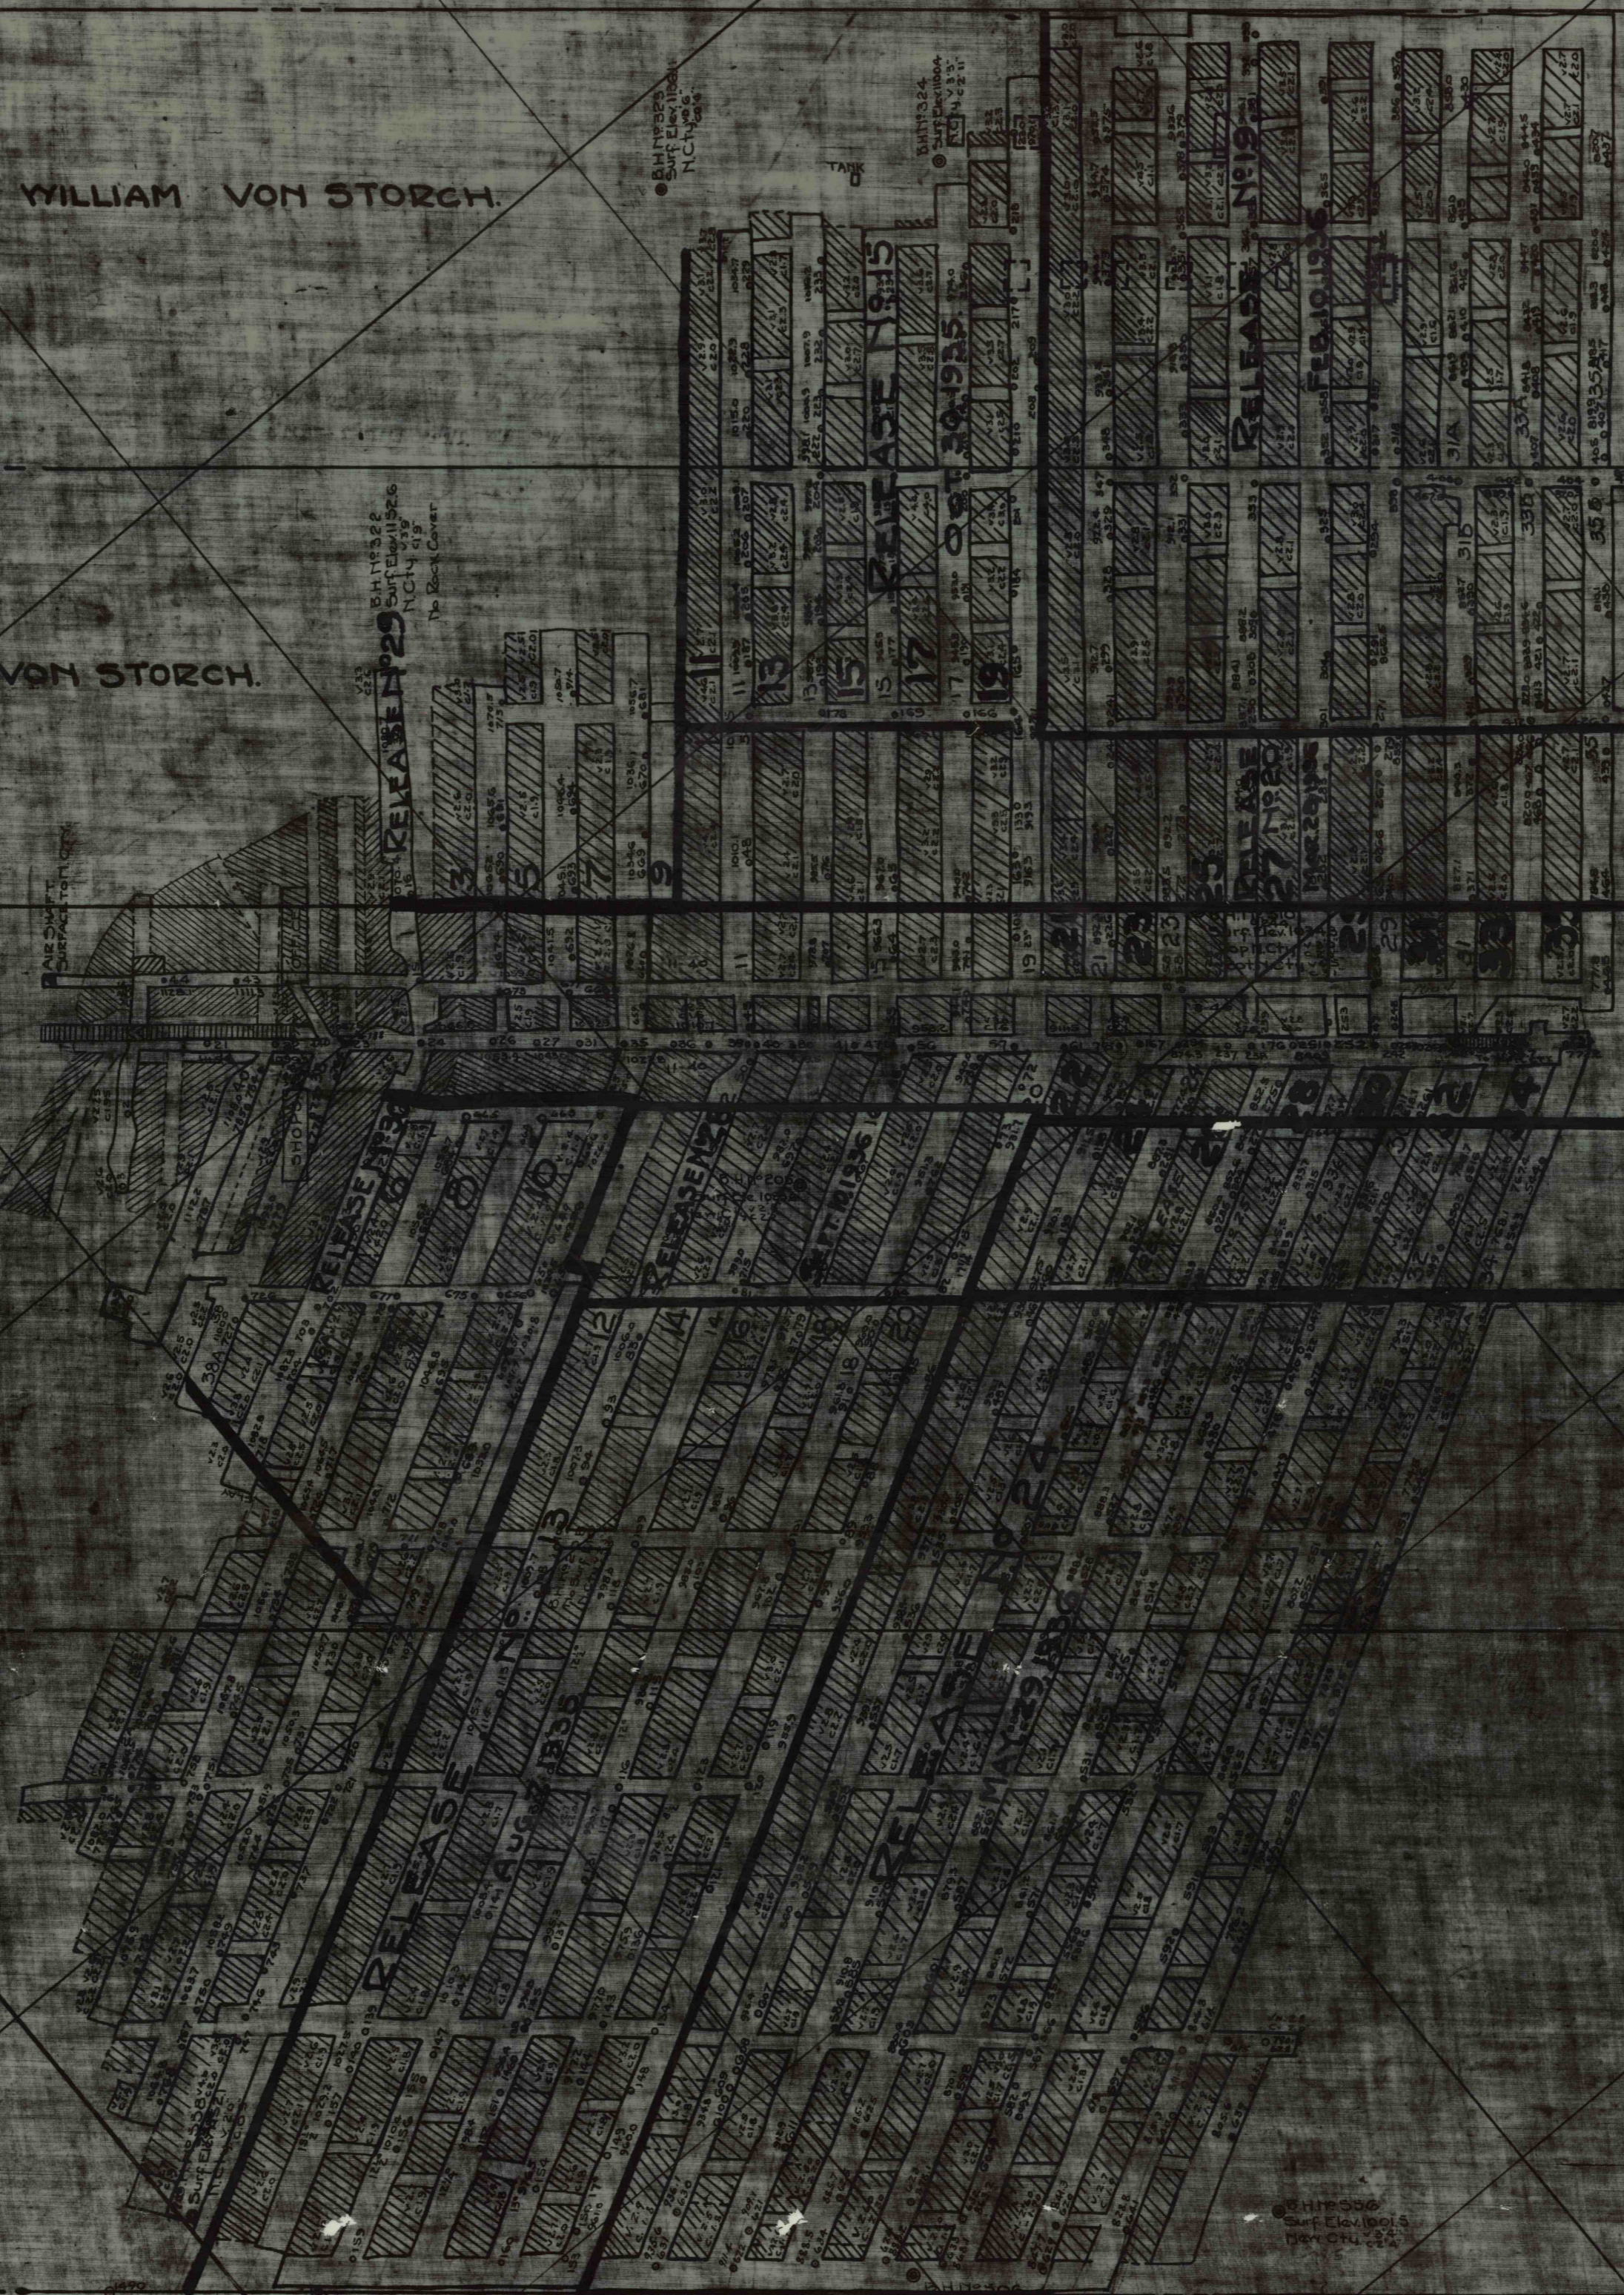

RELEASED
BUTTS 24
SURFACE
NCH 417
No Book Cover



CH 113500
SURFACE
ELEV. 104.4
TOP RCH 113500
BOT 11319 228

