

HENRY B. ROCKWELL
D. L. & W.

LAYTON LEACH
D. L. & W.

FERDINAND & WILLIAM VON STORCH

THEODORE C. VON STORCH

PHILLIP C. GRIFFIN "FARM"
DEL. & HUD.

WILLARD PARKER

HASSAU BROWN
D. L. & W.

HASSAU WOOD
D. L. & W.

HENRY B. ROCKWELL



HENRY B. ROCKWELL

EARL & GRIFFIN

KELSEY

HENRY B. ROCKWELL

CAYUGA & SUSQUEHANNA
D. L. & W.

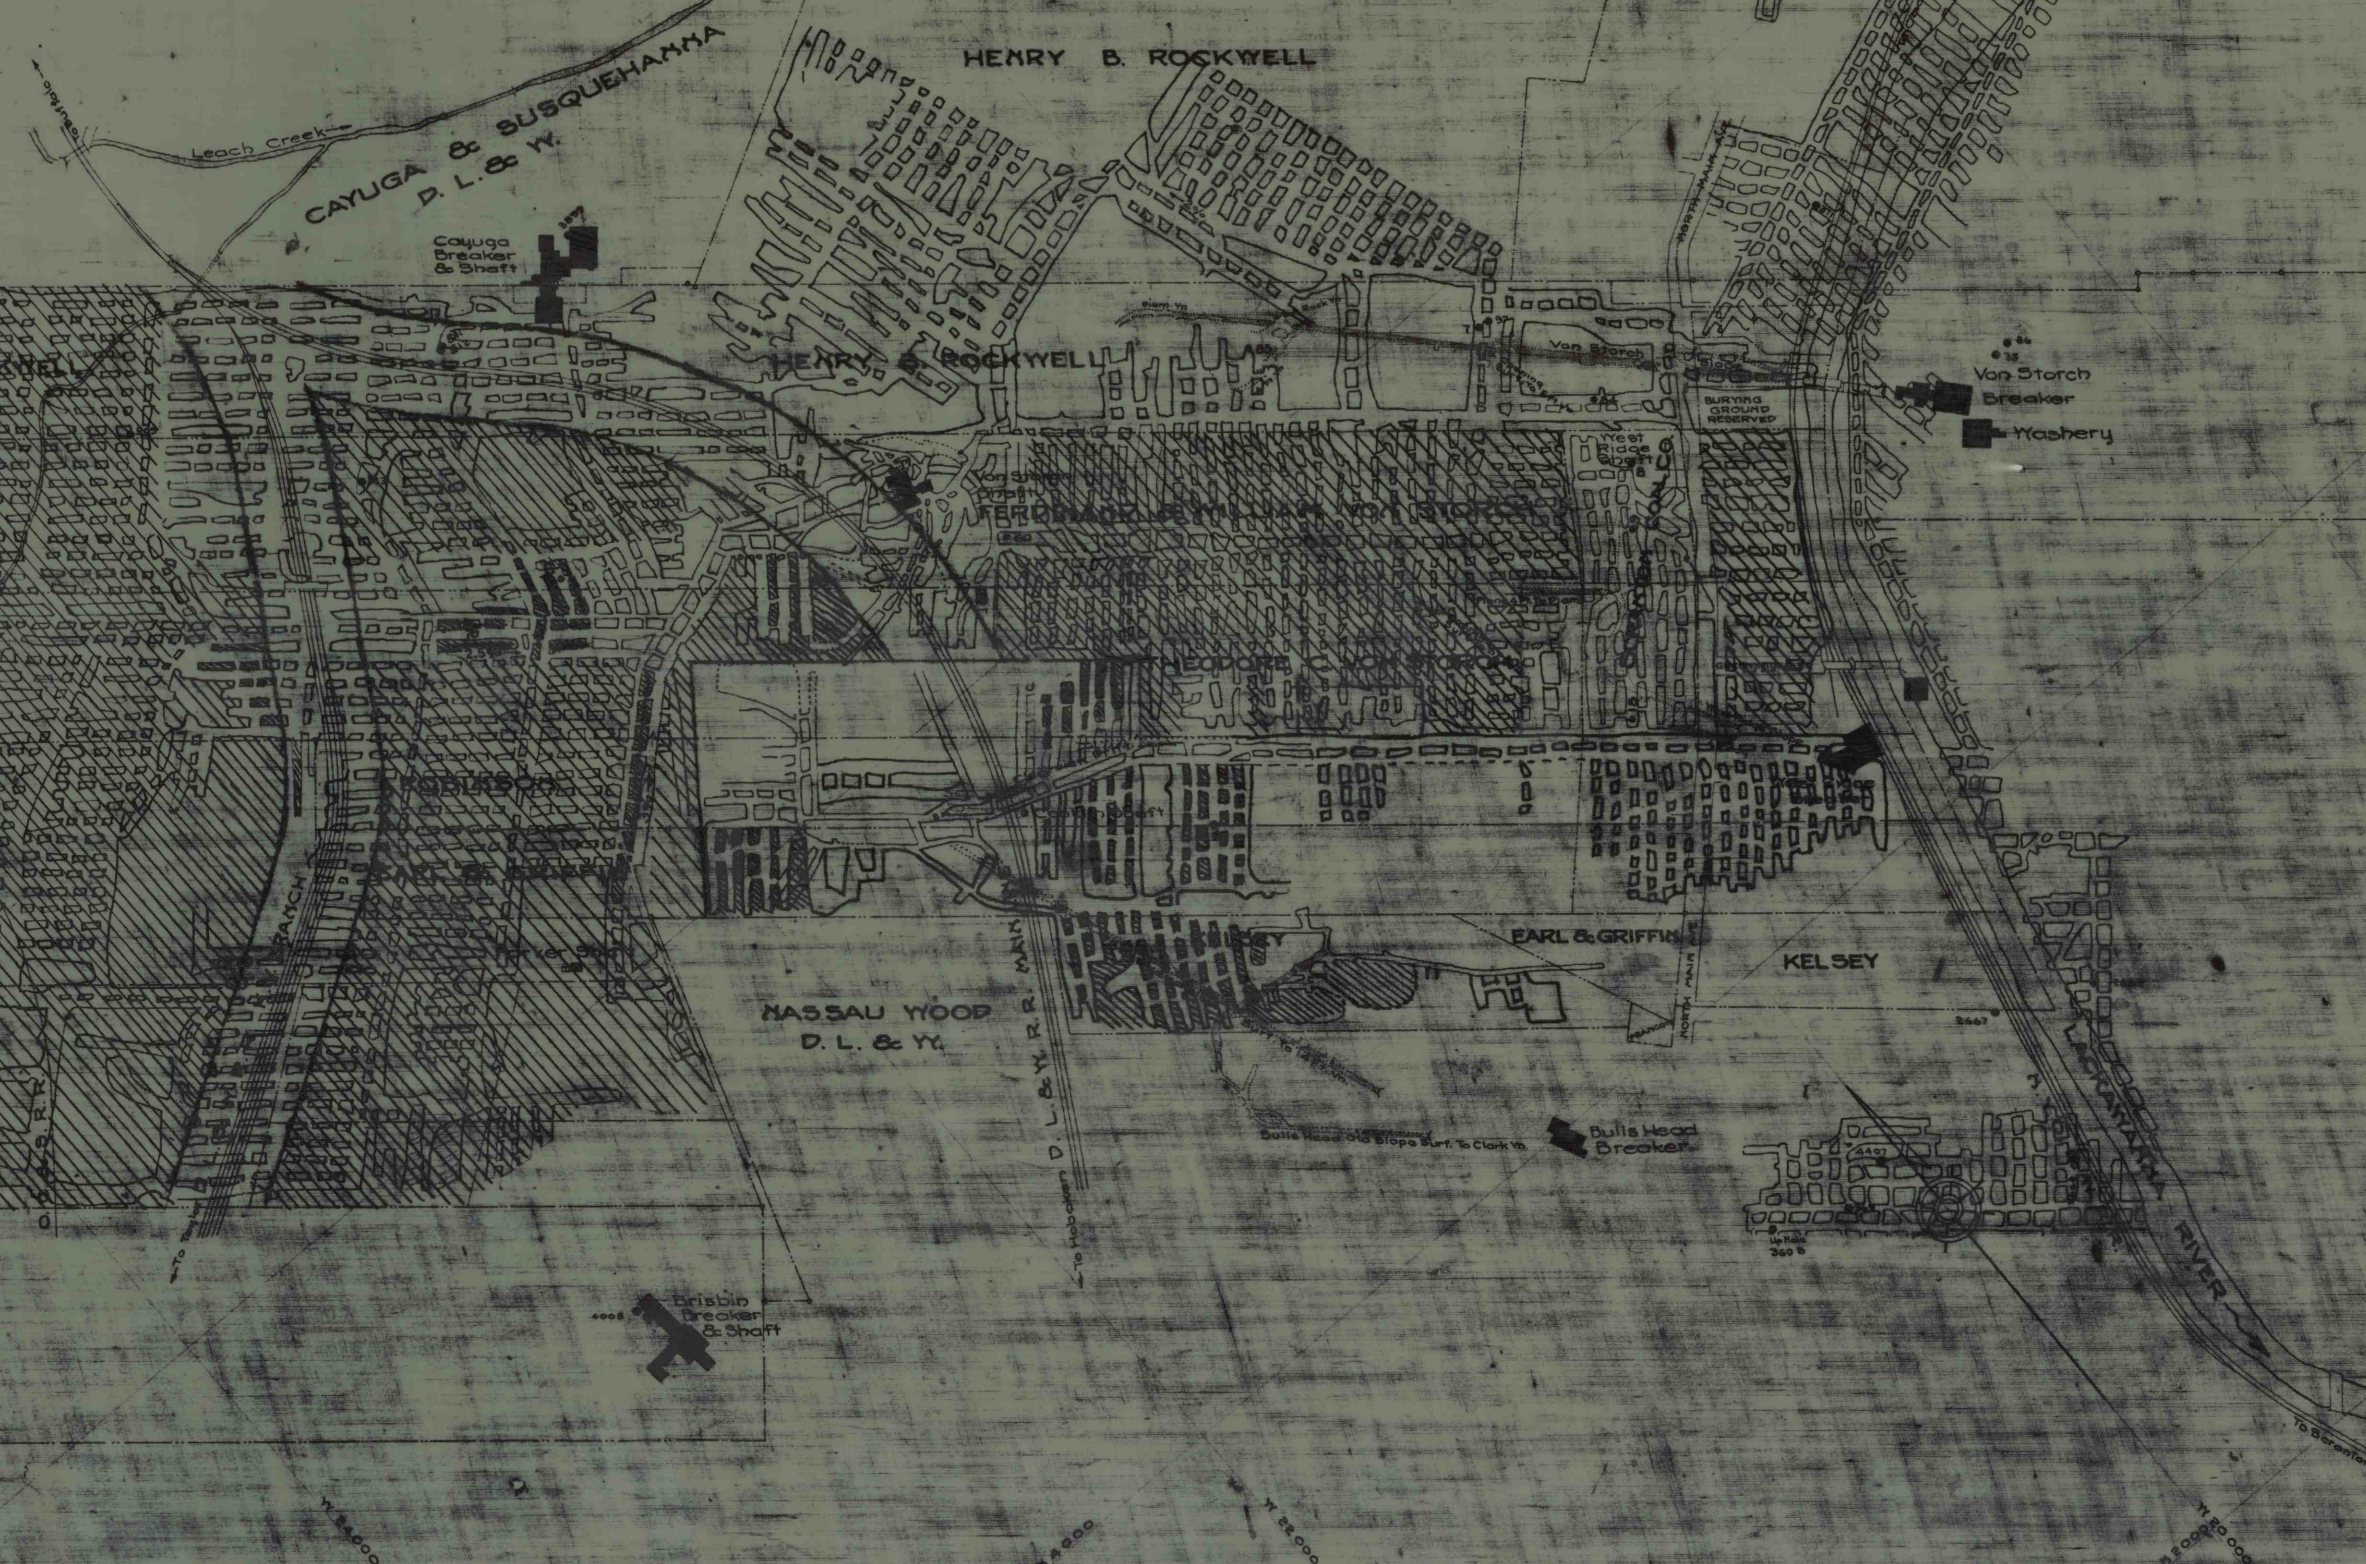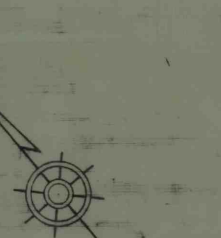

VON STORCH COLLIERIES CO.

**VON STORCH
NEW COUNTY**

Office Of Mining Engr. Scranton, Pa.
Scale 1"=400' June, 22, 1921.
Index No.