


5-5-A-6

5-5-A-6

1"=100'
PLAN

E 2000
S 3500

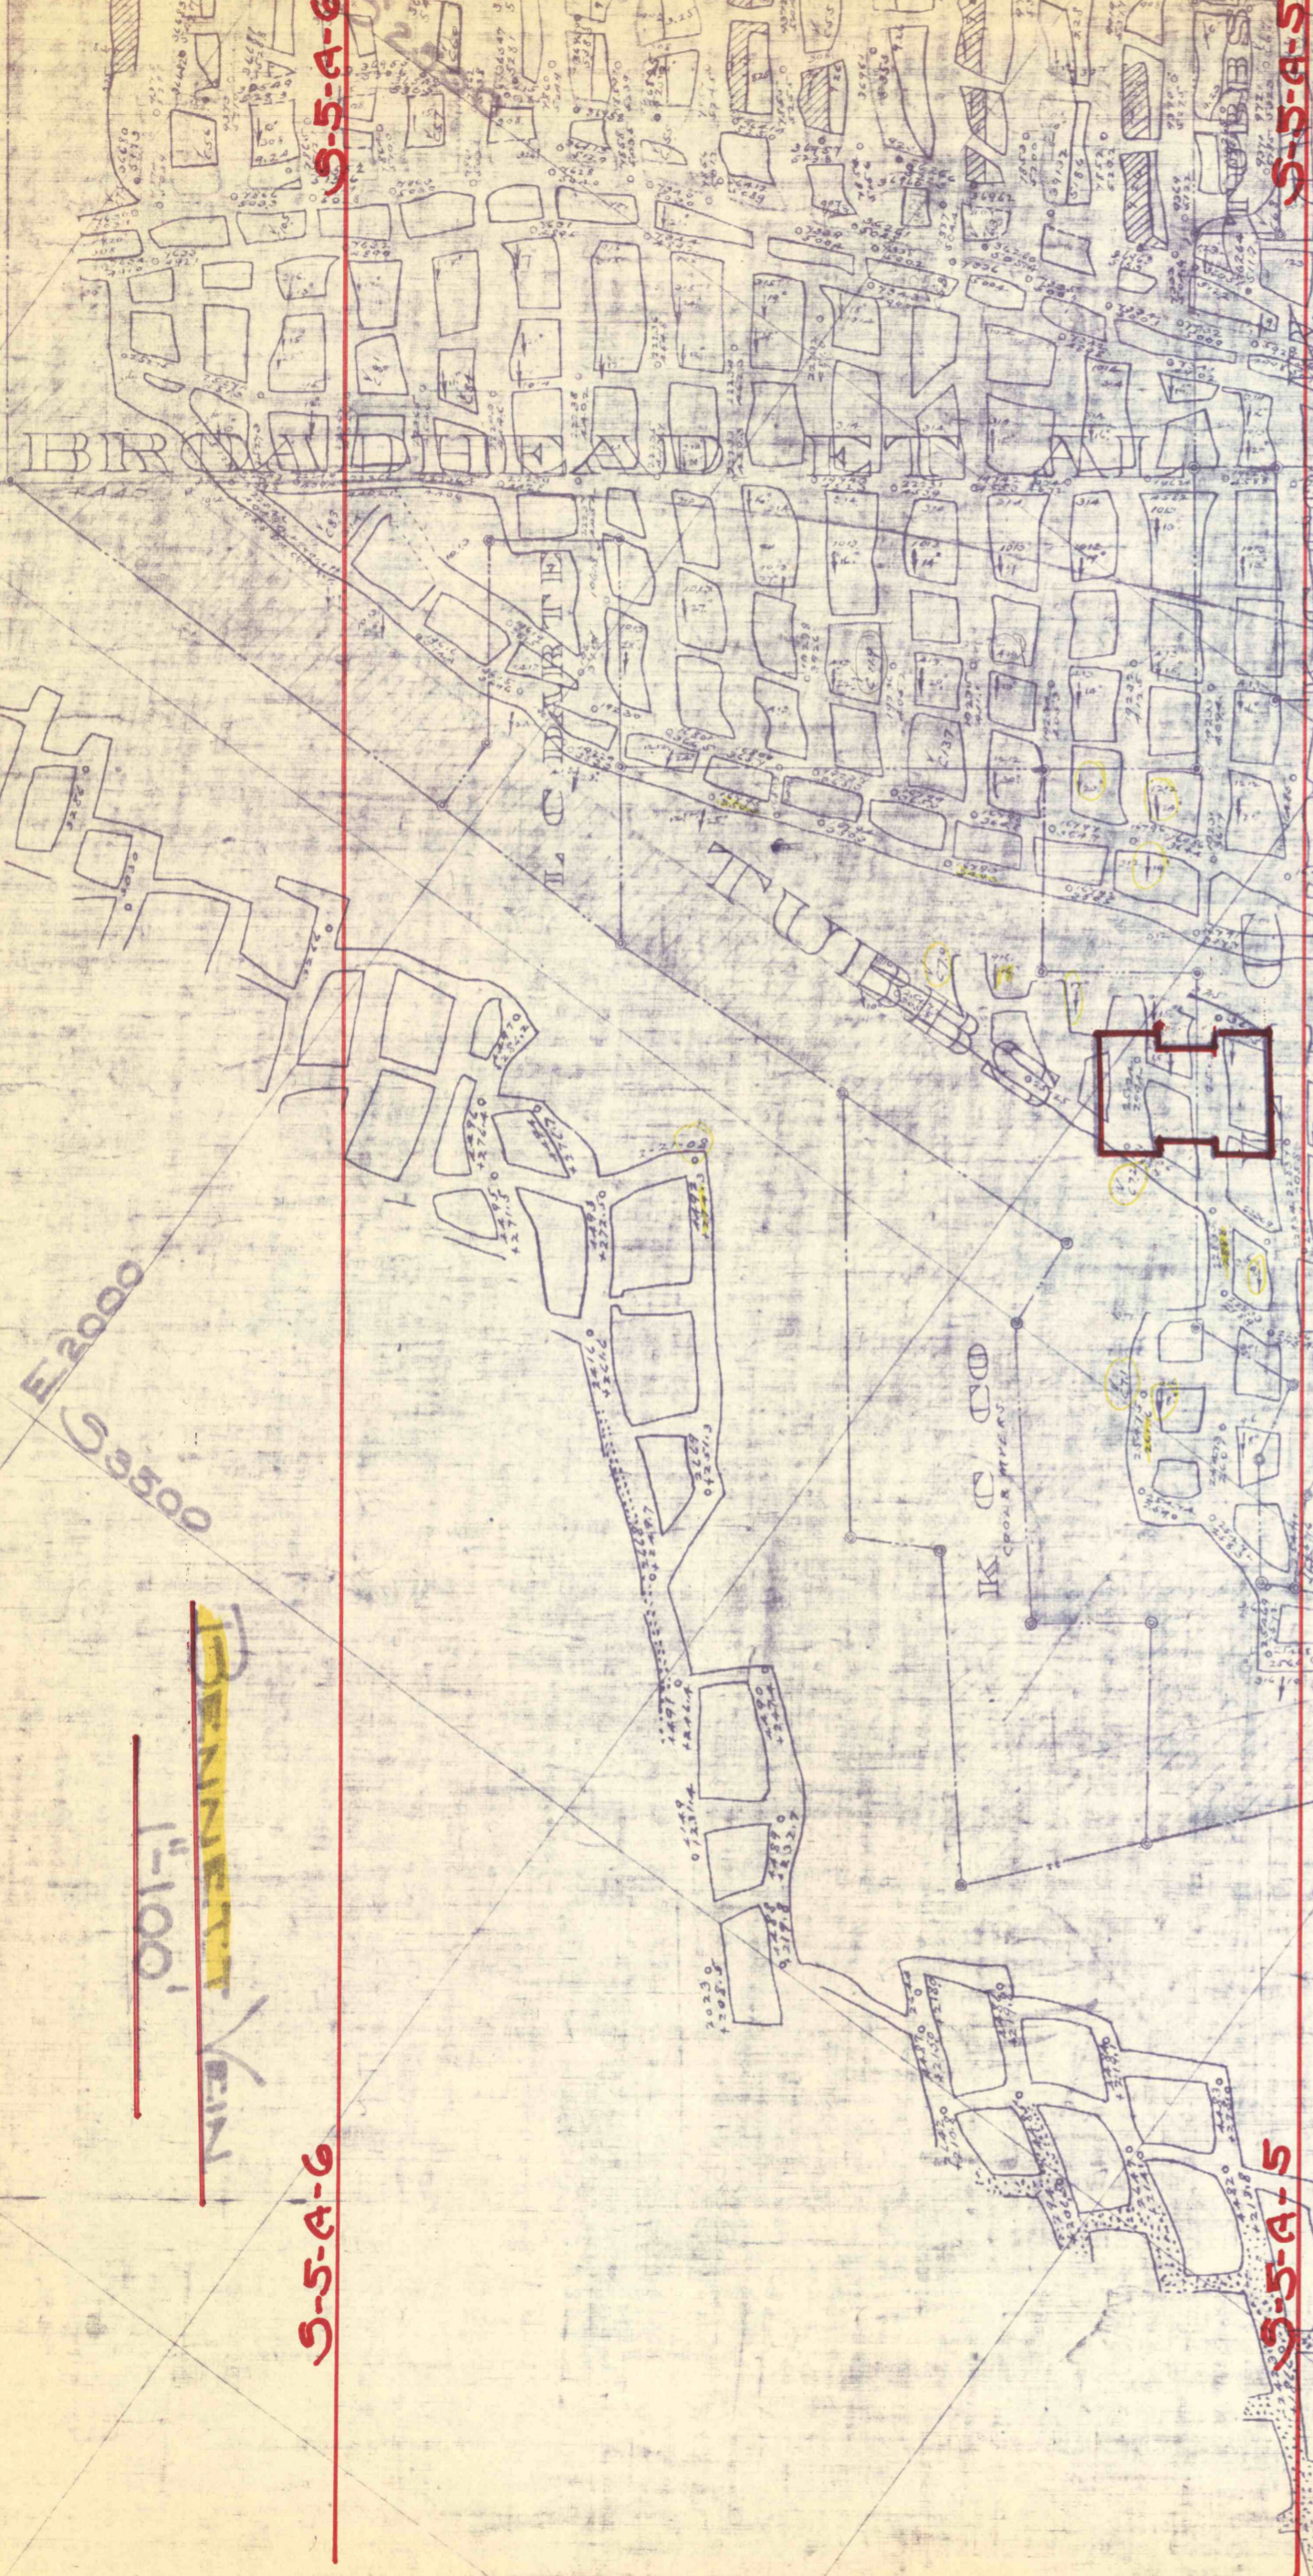

5-5-A-5

5-5-A-5



5-5-A-4

5-5-A-4

