


BLISS COAL CORP.

TRUESDALE COAL CORP.

SUGAR NOTCH COLLIERY

PITTSBORO COAL MINING COMPANY
PITTSBORO COAL COLLIERY
MAFFETS

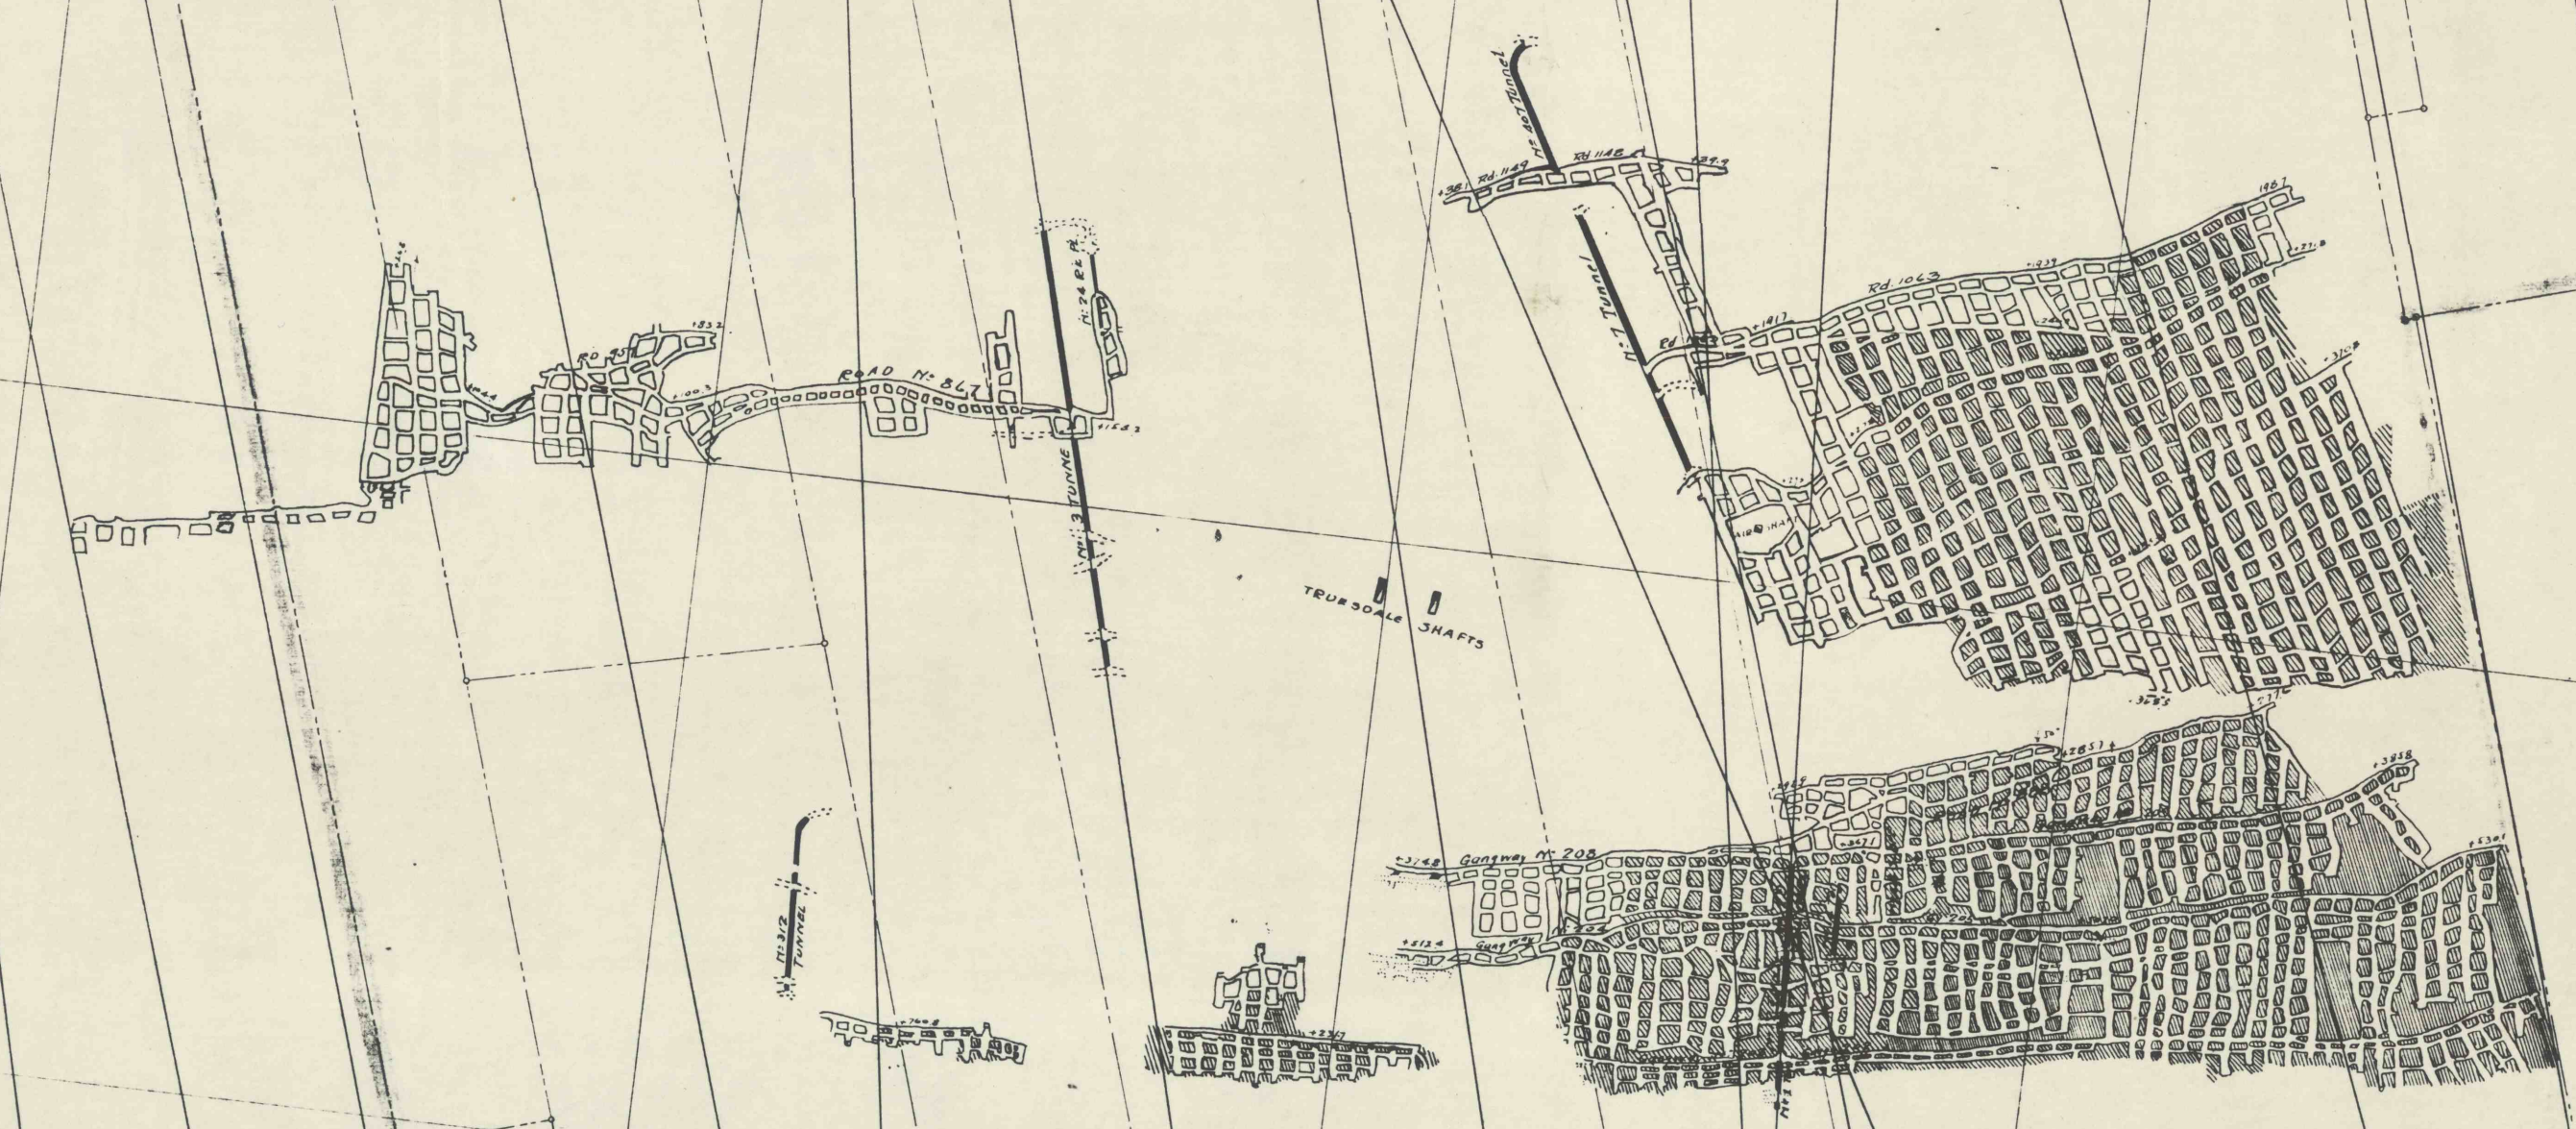

TRACING EXTENDED


TOP TWIN VEIN

BLISS & TRUESDALE COLLIERIES

SCALE 1"=400'