


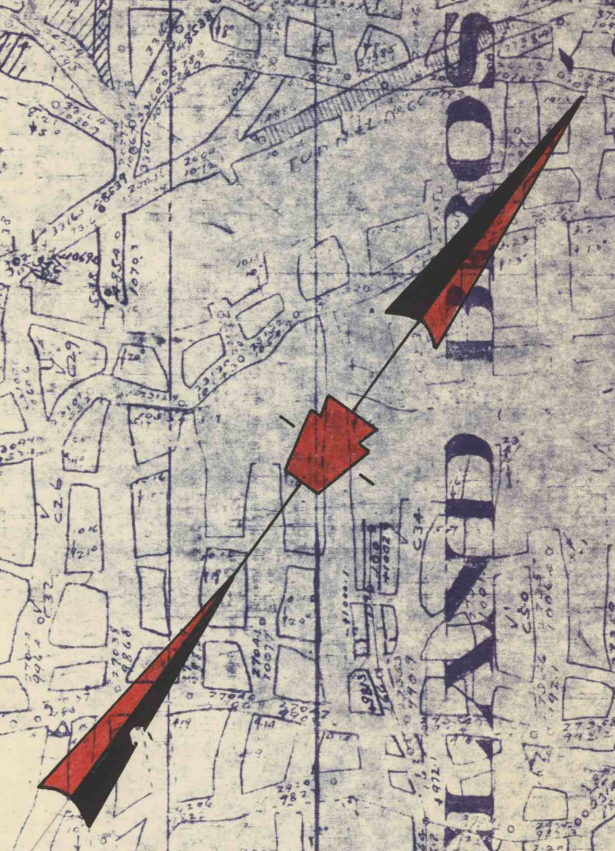

X-SEC.
R-6 B-1

X-SEC.
R-6 B-2

ELEVEN FOOT VEIN
KINGSTON COAL CO.
SCALE 1" = 100'



LOVELAND
























WILLIAMS








J. D. & H.