

bbim).av cief

D & H CO

D & H CANAL CO


Hoyt & Loveland

Hoyt & Loveland

Hoyt & Loveland

Loveland Bros

J. D. & H. N.

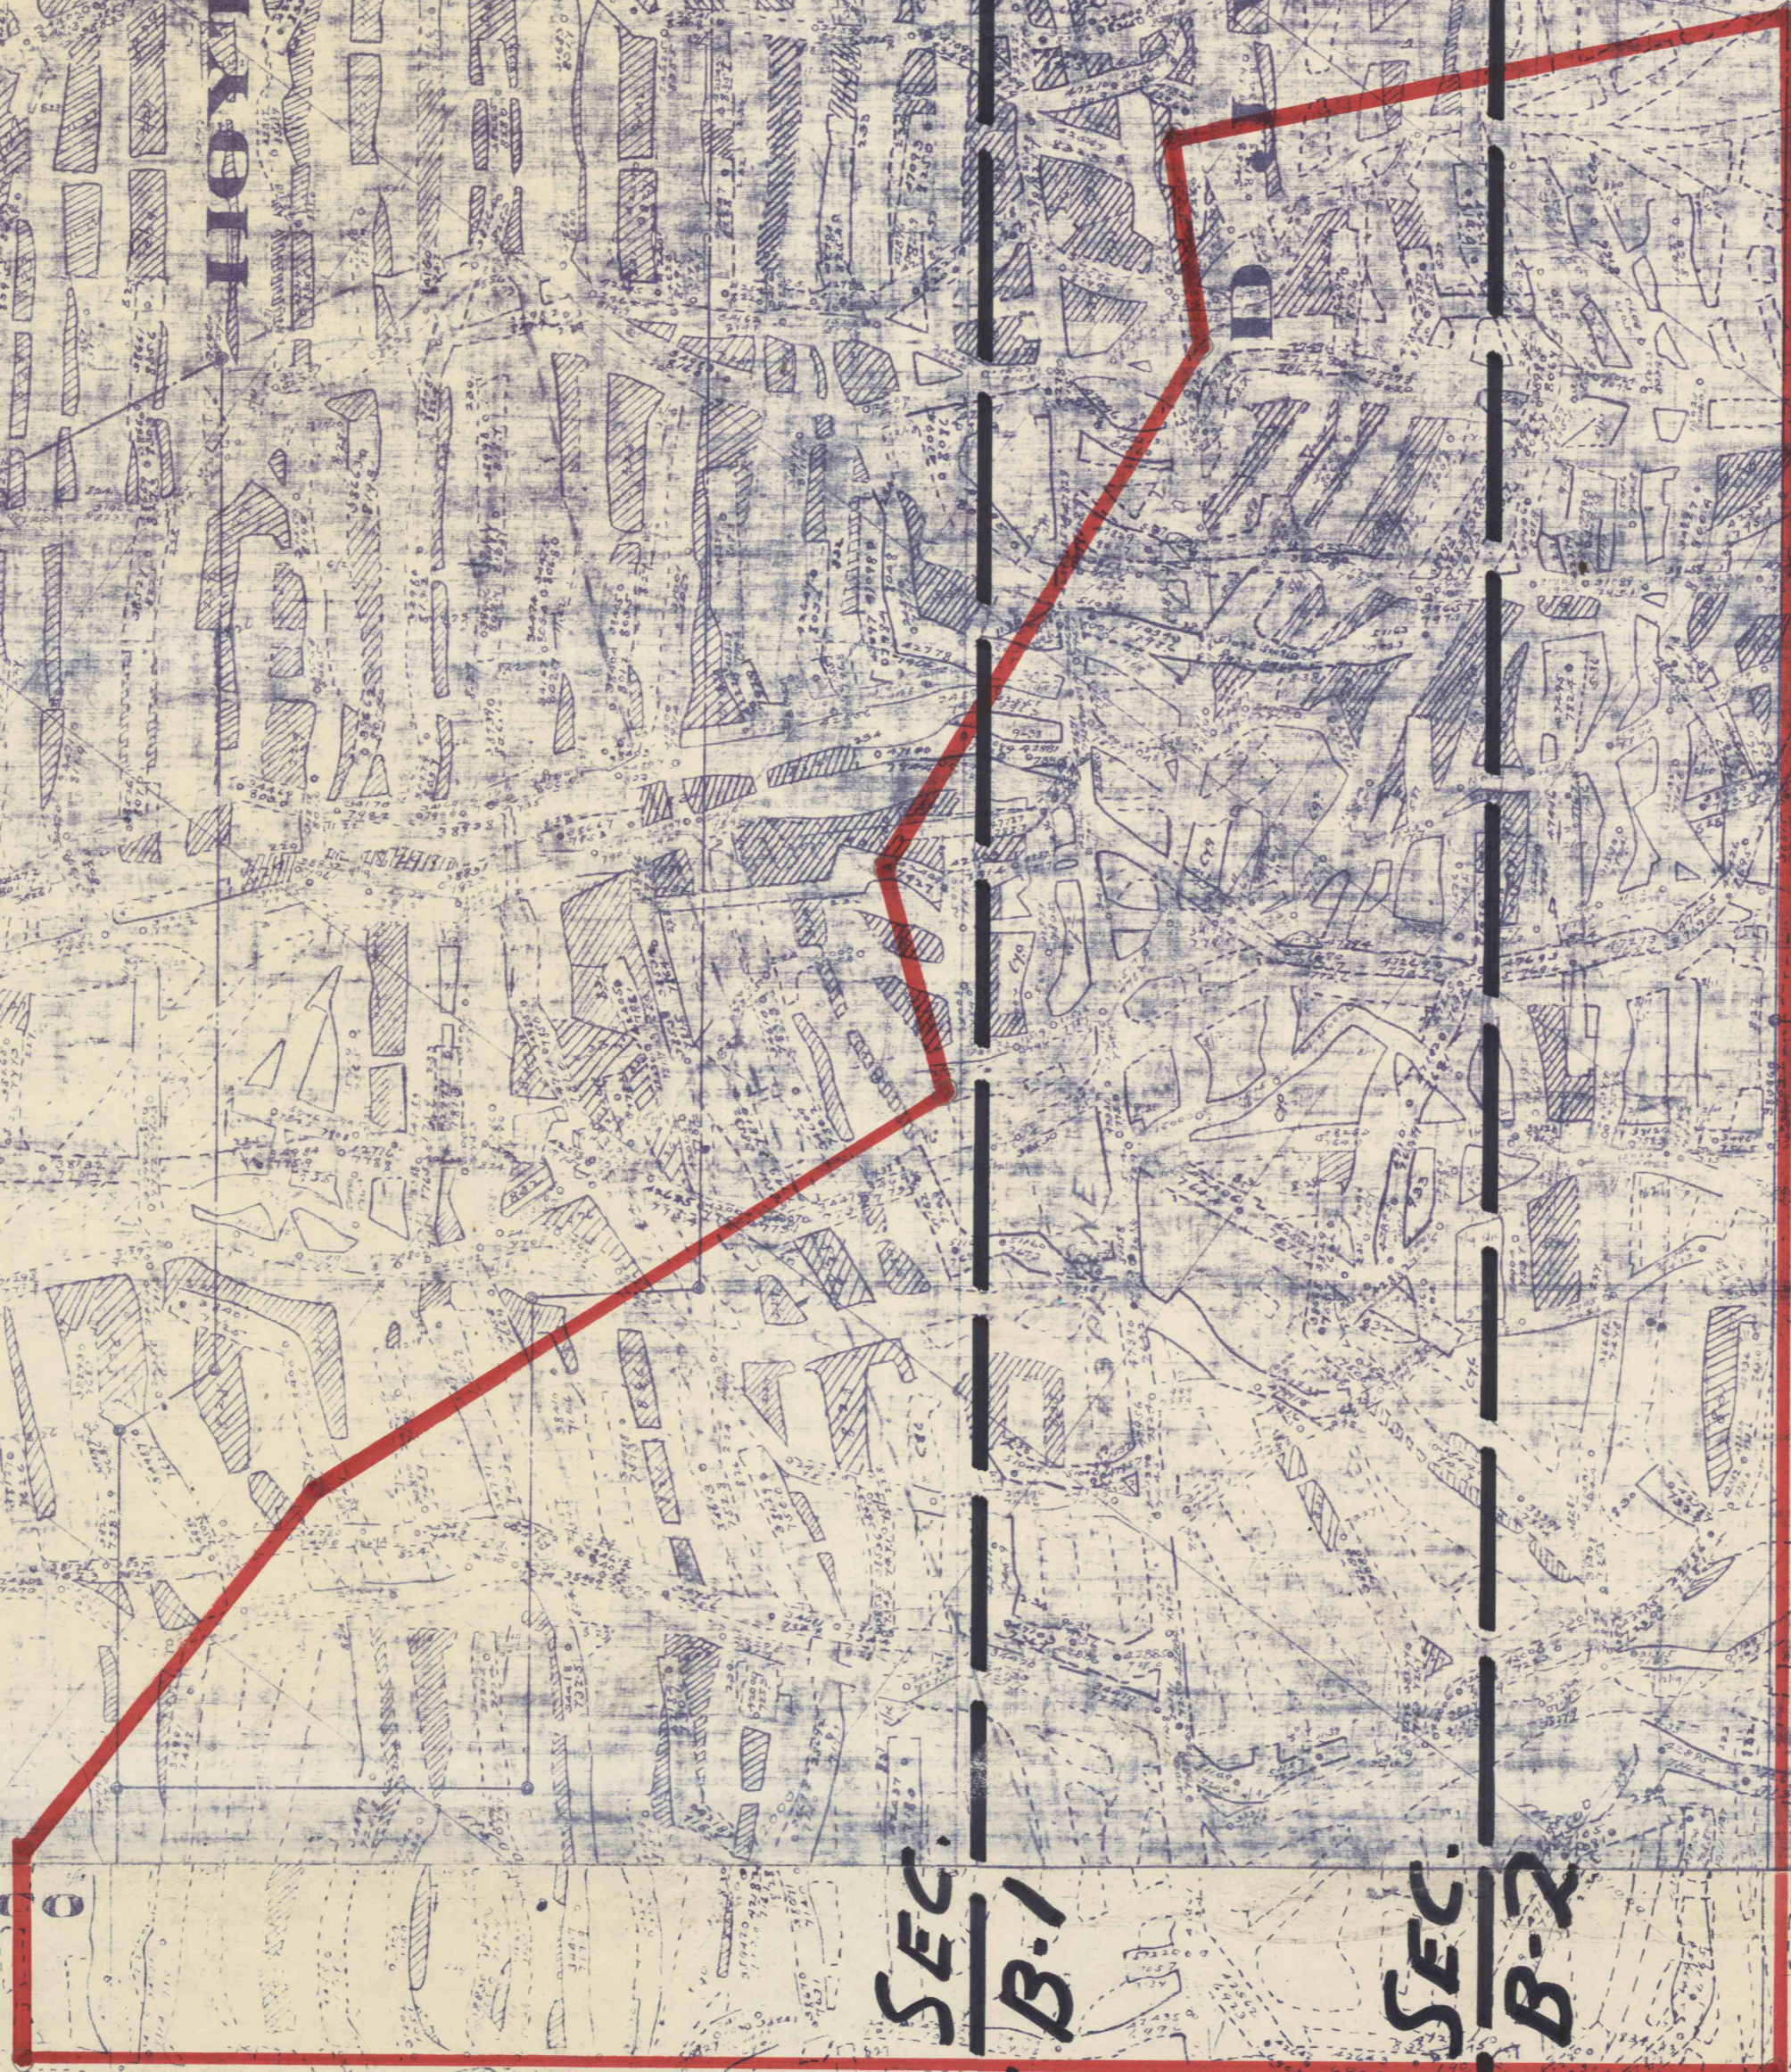

X-SEC.  
R-G B-1

X-SEC.  
R-G B-2

RED ASH VEIN  
KINGSTON COAL CO.  
SCALE 1" = 100'

