


R-6 B-2

R-6 B-3


R-6 B-4

R-6 B-8

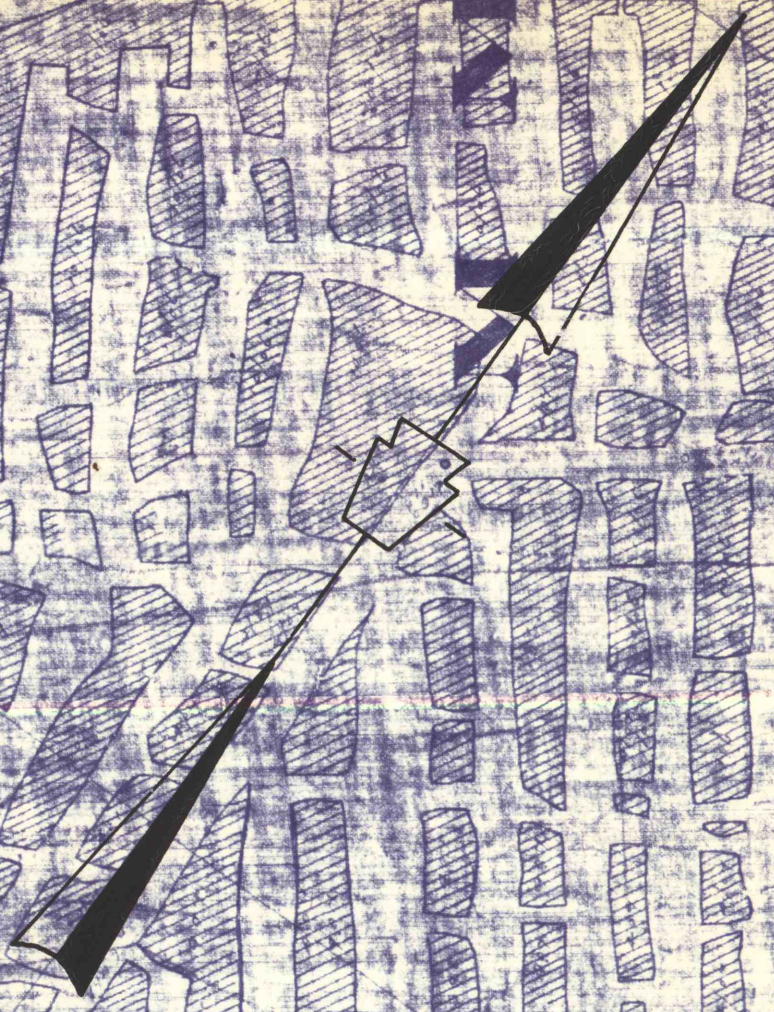

KINGSTON COAL

BROADHEAD TAIL

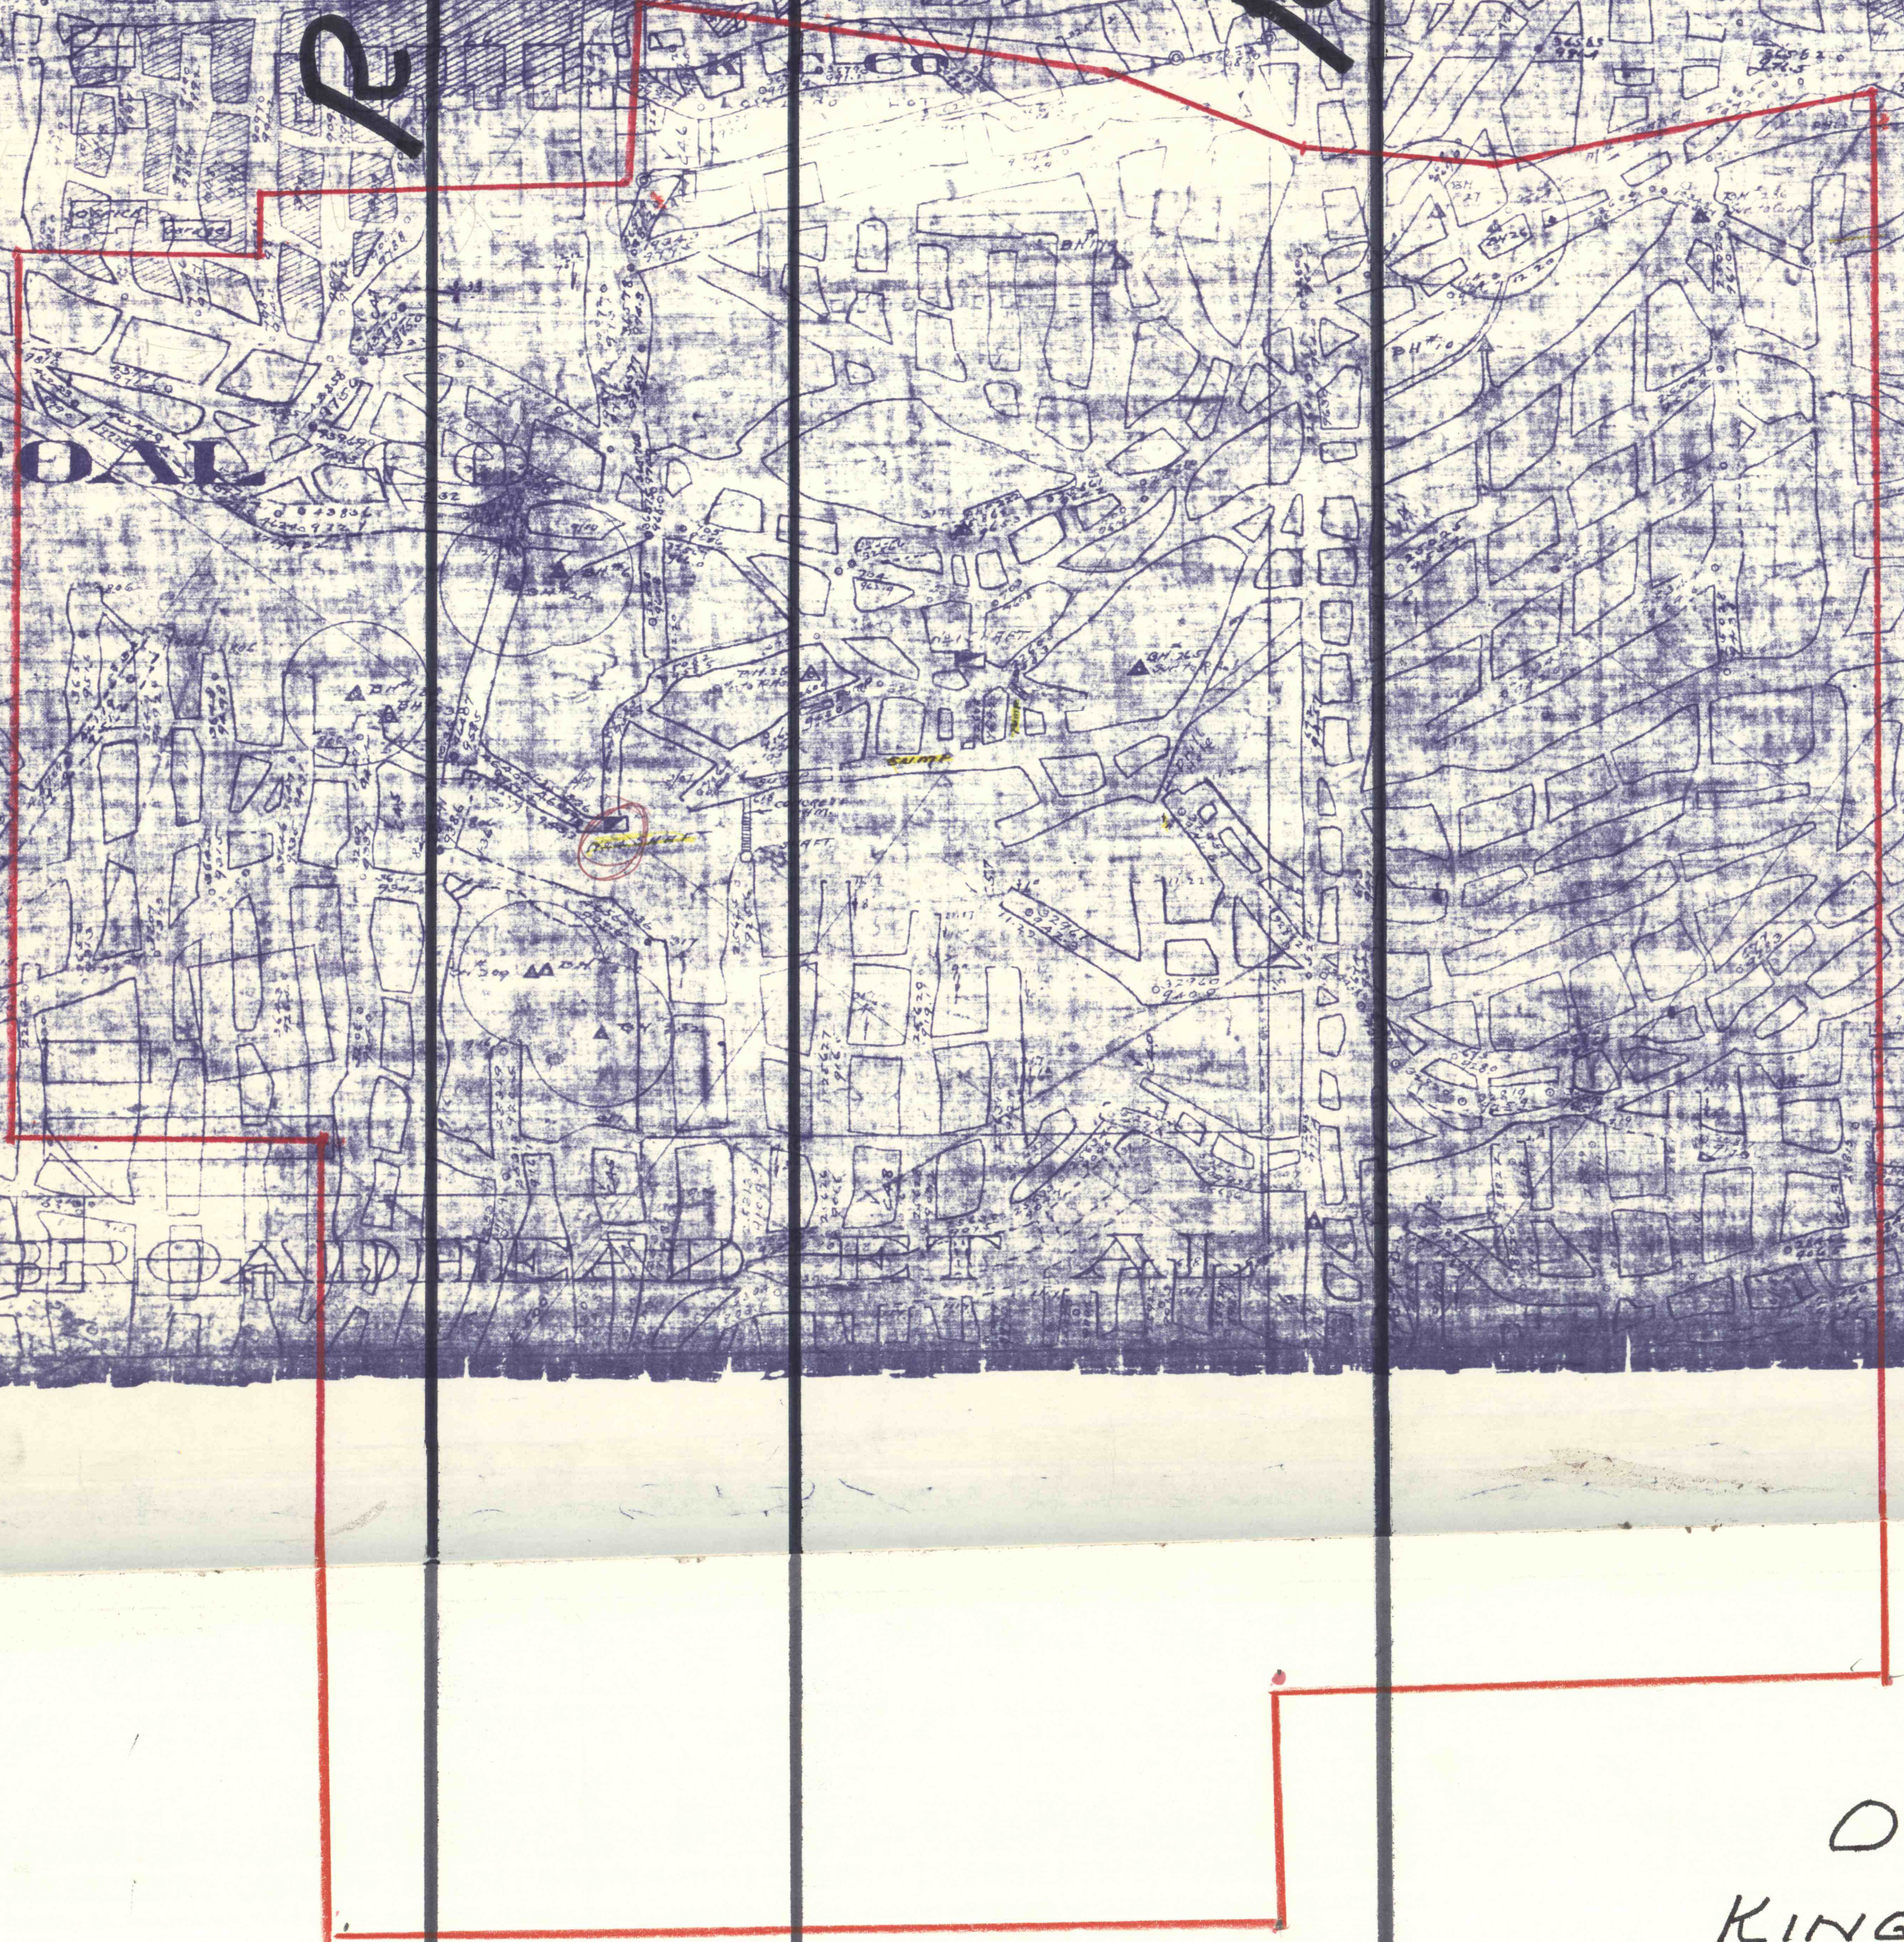

ORCHARD VEIN
KINGSTON COAL CO.
SCALE 1" = 100'