


R-6 B-2

R-6 B-3

R-6 B-4

R-6 B-8

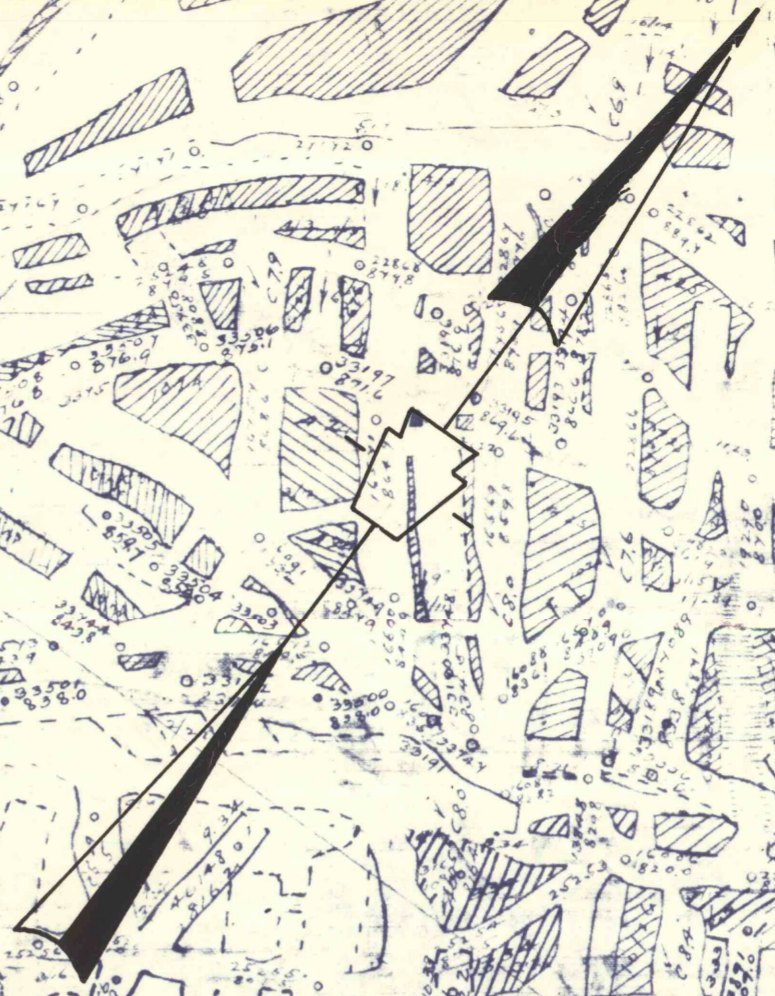

KINGSTON COAL CO

BROADHEAD ET AL
TRACT NO 4

HOYT ET AL

LE DARTÉ

TRACT NO 1

COOPER VEIN
KINGSTON COAL CO
SCALE 1" = 100'