


R-6 B-2

R-6 B-3

R-6 B-4

R-6 B-8

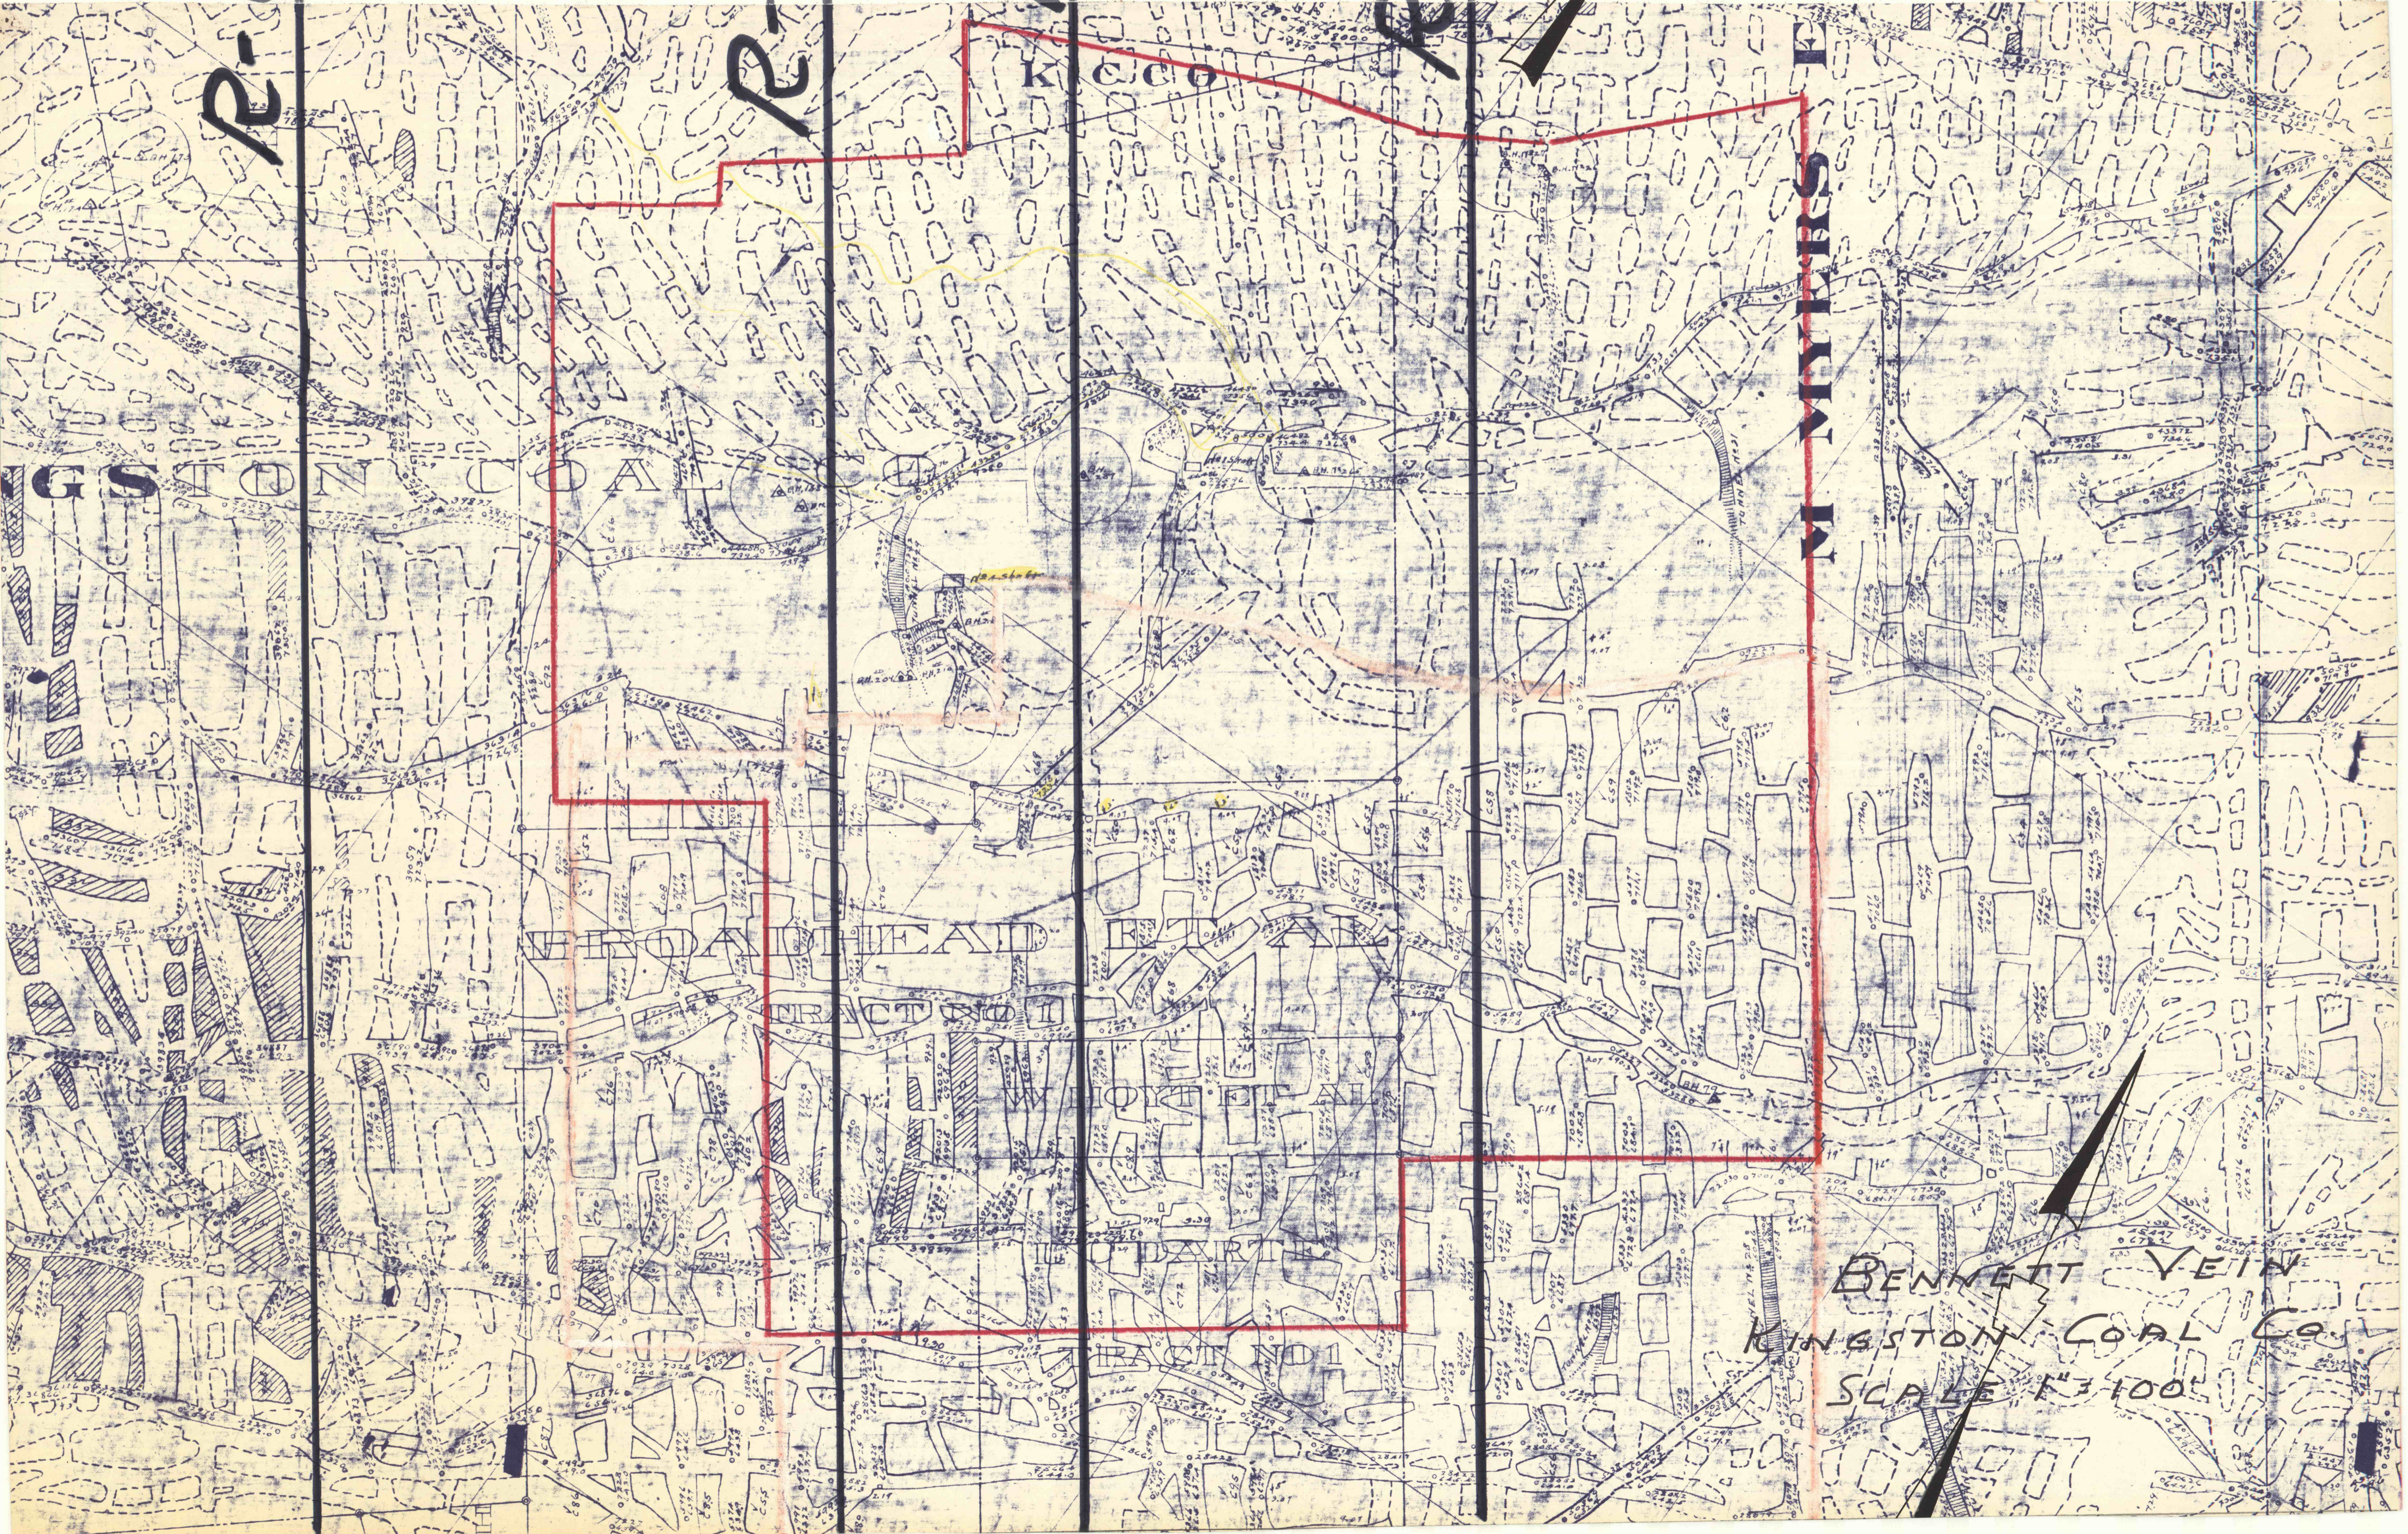

BENNETT VEIN
 KINGSTON COAL CO.
