

R-6 B-2

R-6 B-3

R-6 B-4

R-6 B-8

KINGSTON COAL CO


BROADHEAD ET AL
TRACT NO 1

W HOYT ET AL

L C DARTÉ

TRACT NO 1

EAST MINERS

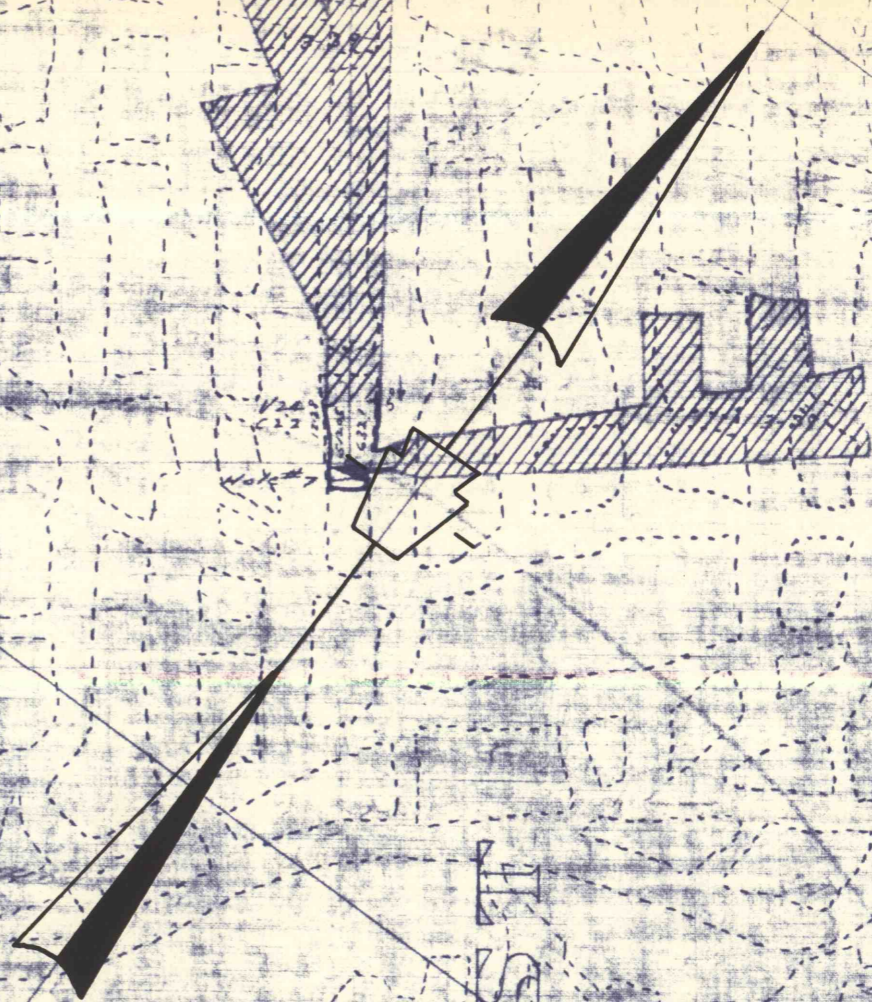

ROSS SPLIT VEIN
KINGSTON COAL CO.
SCALE 1" = 100'