


R-6 B-2

R-6 B-3

R-6 B-4

R-6 B-8

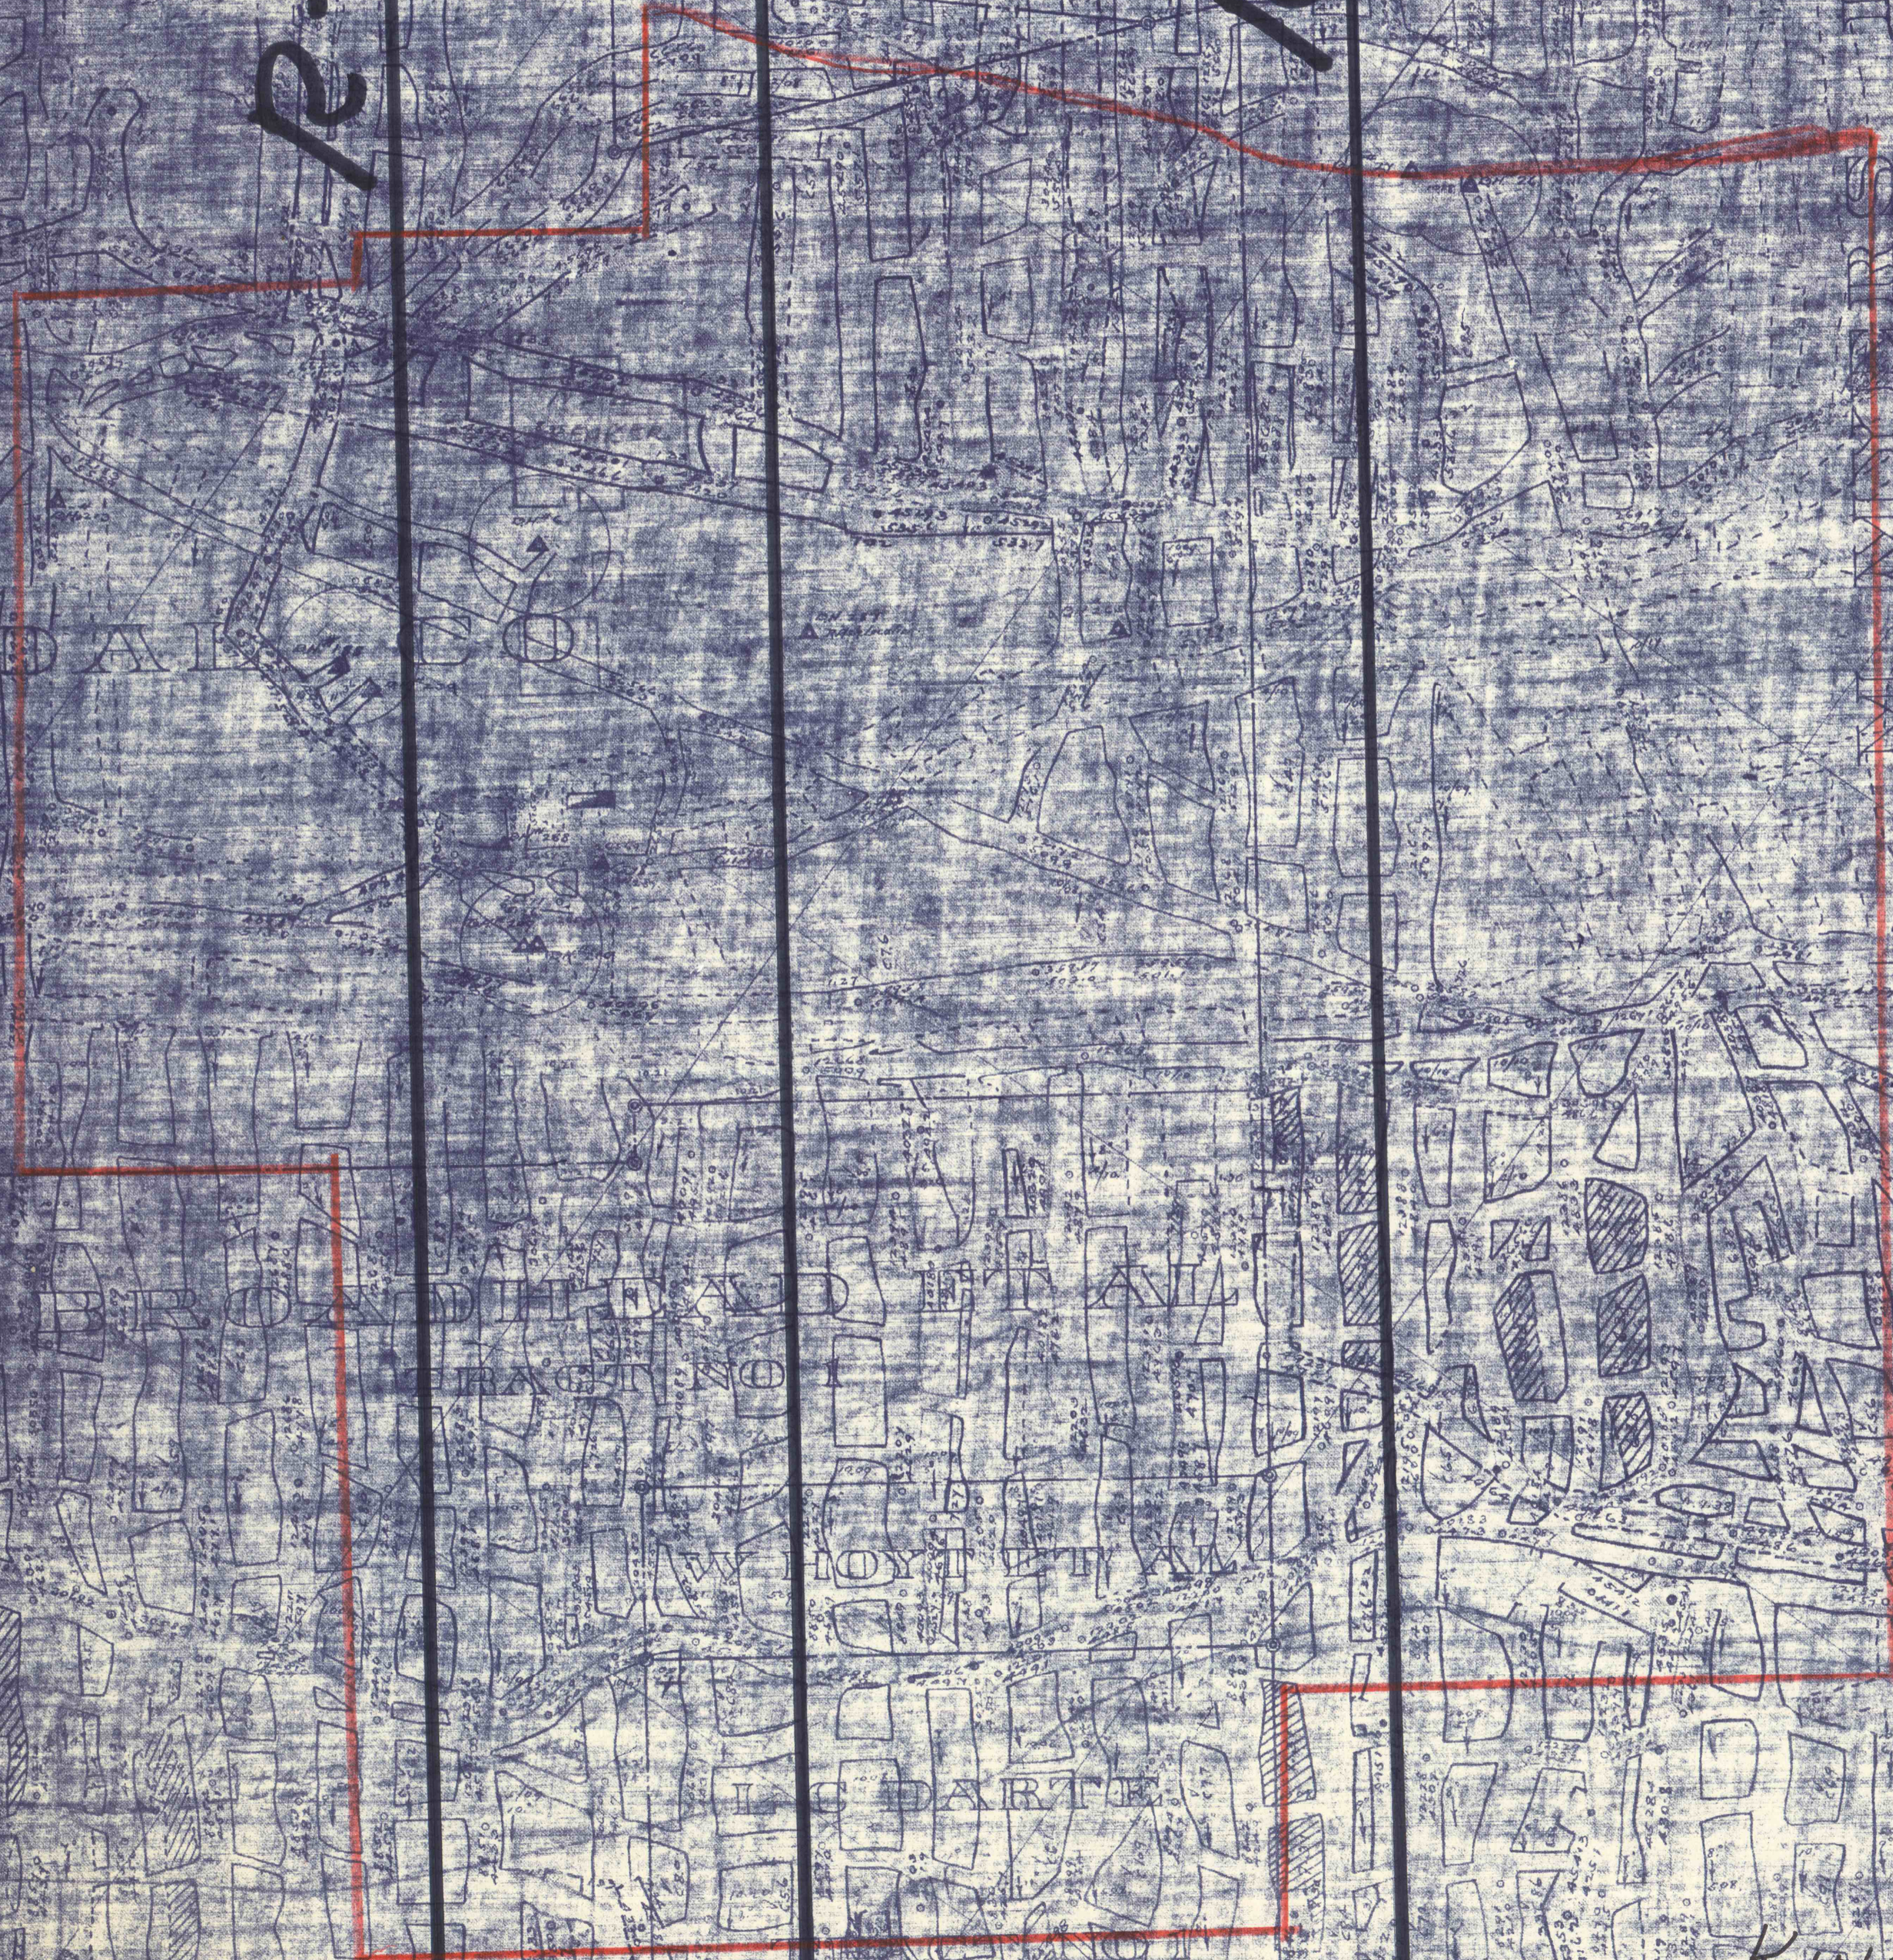


TRACT NO. 1

W. HOYT F. T. W.

L. C. DARTE

ROSS VEIN  
KINGSTON COAL CO  
SCALE 1" = 100'