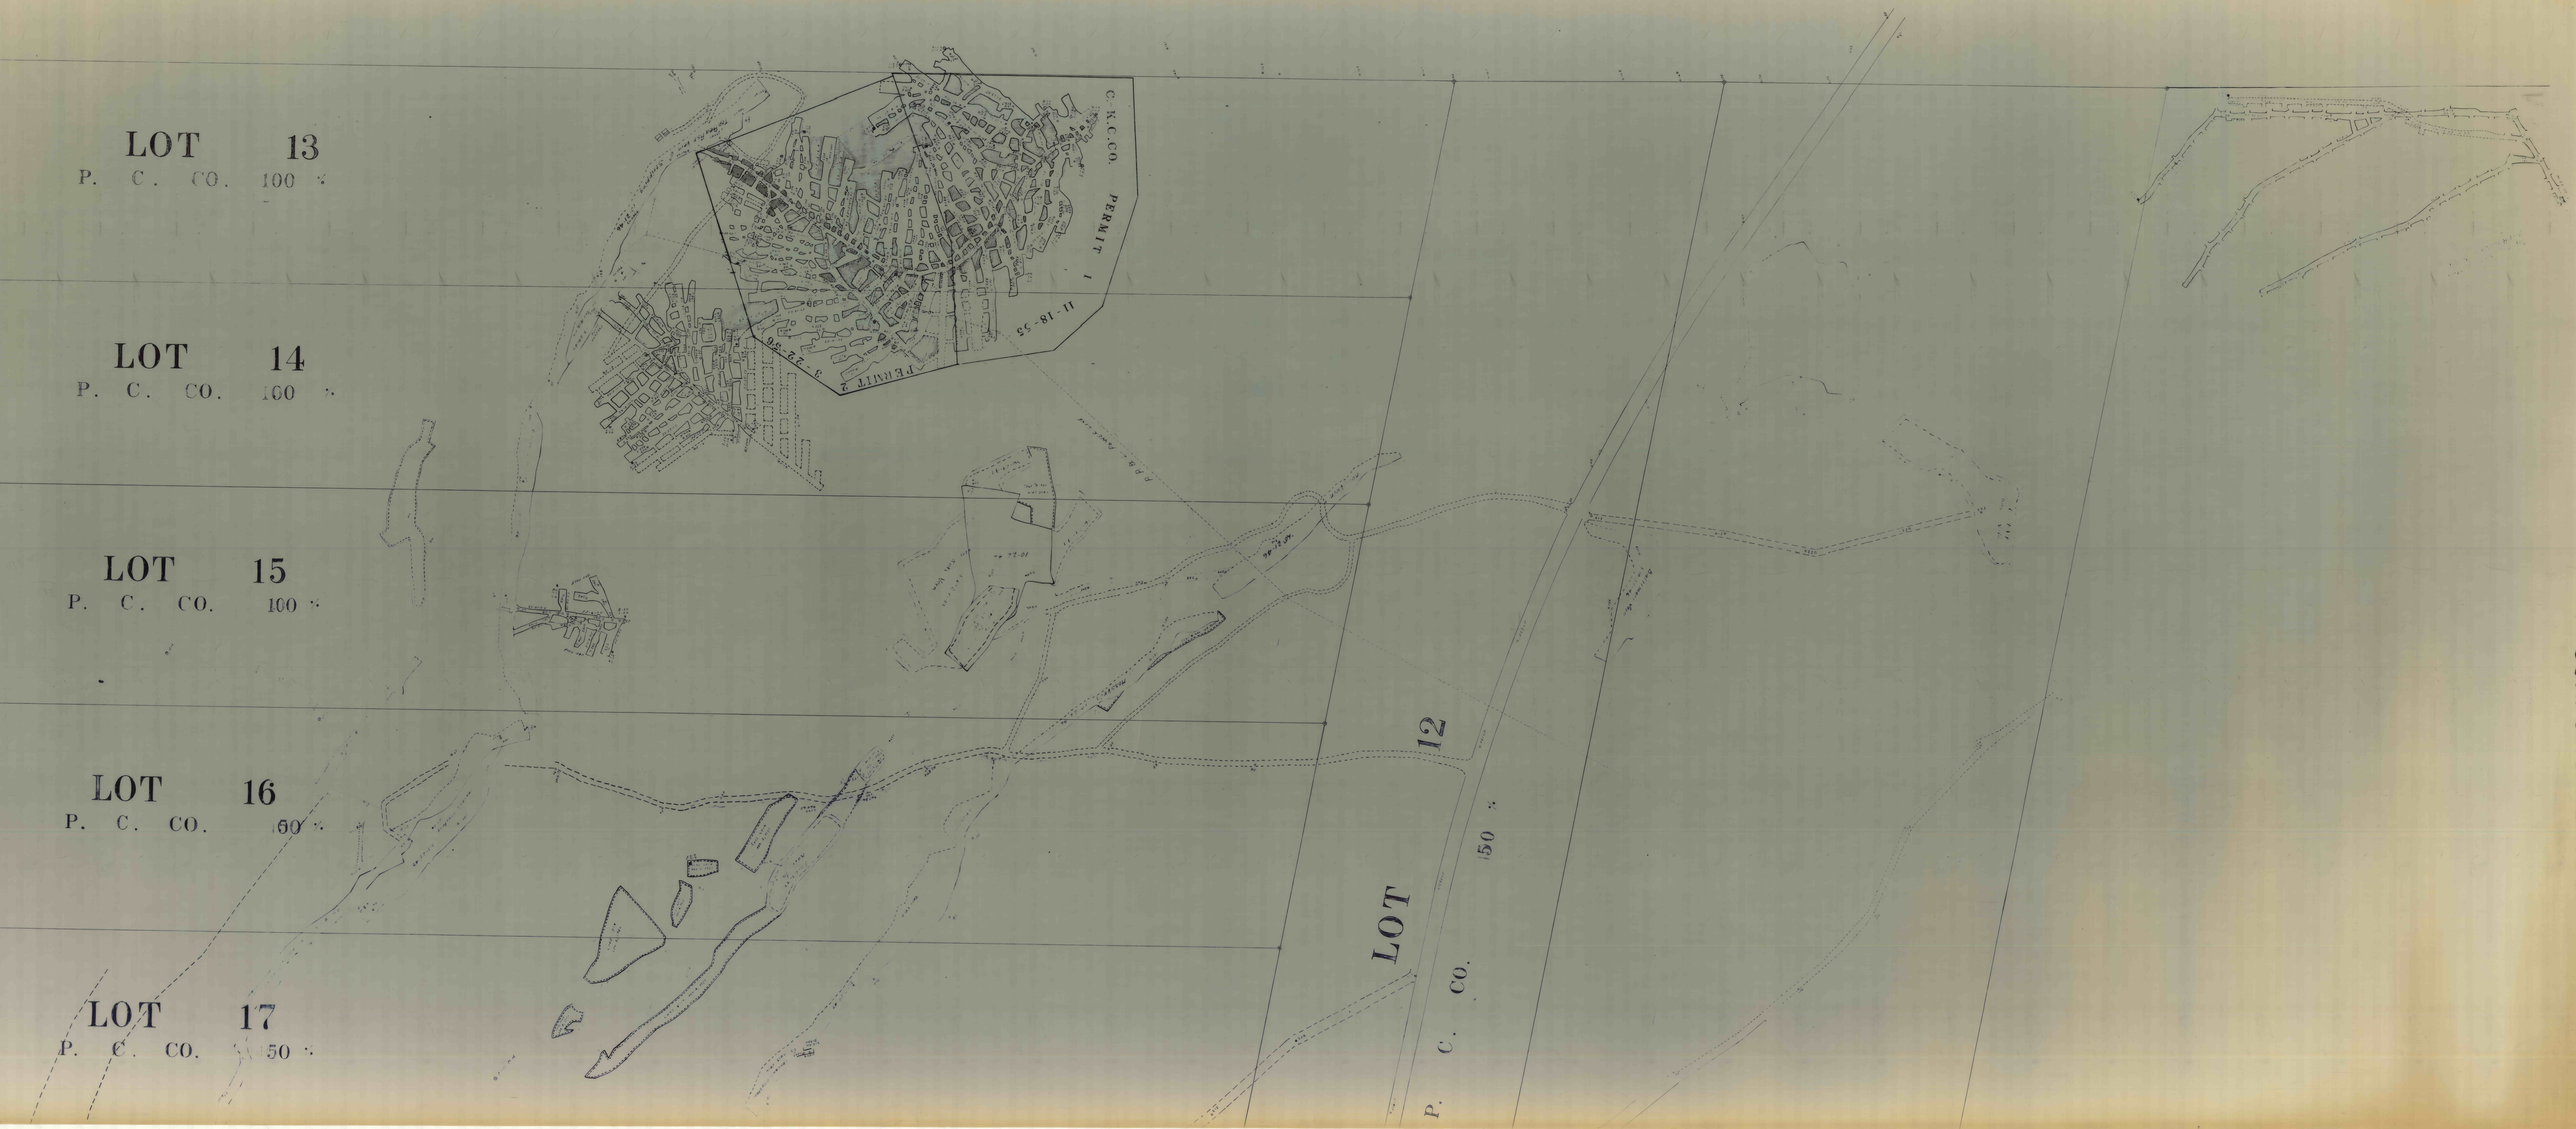
LOT 13
P. C. CO. 100 ×
LOT 14
P. C. CO. 100 ×
LOT 15
P. C. CO. 100 ×
LOT 16
LOT 17
P. C. CO. 50 ×
LOT 12
P. C. CO. 150 ×
C. R. C. CO.
PERMIT 1
11-18-55
PERMIT 2
3-22-50