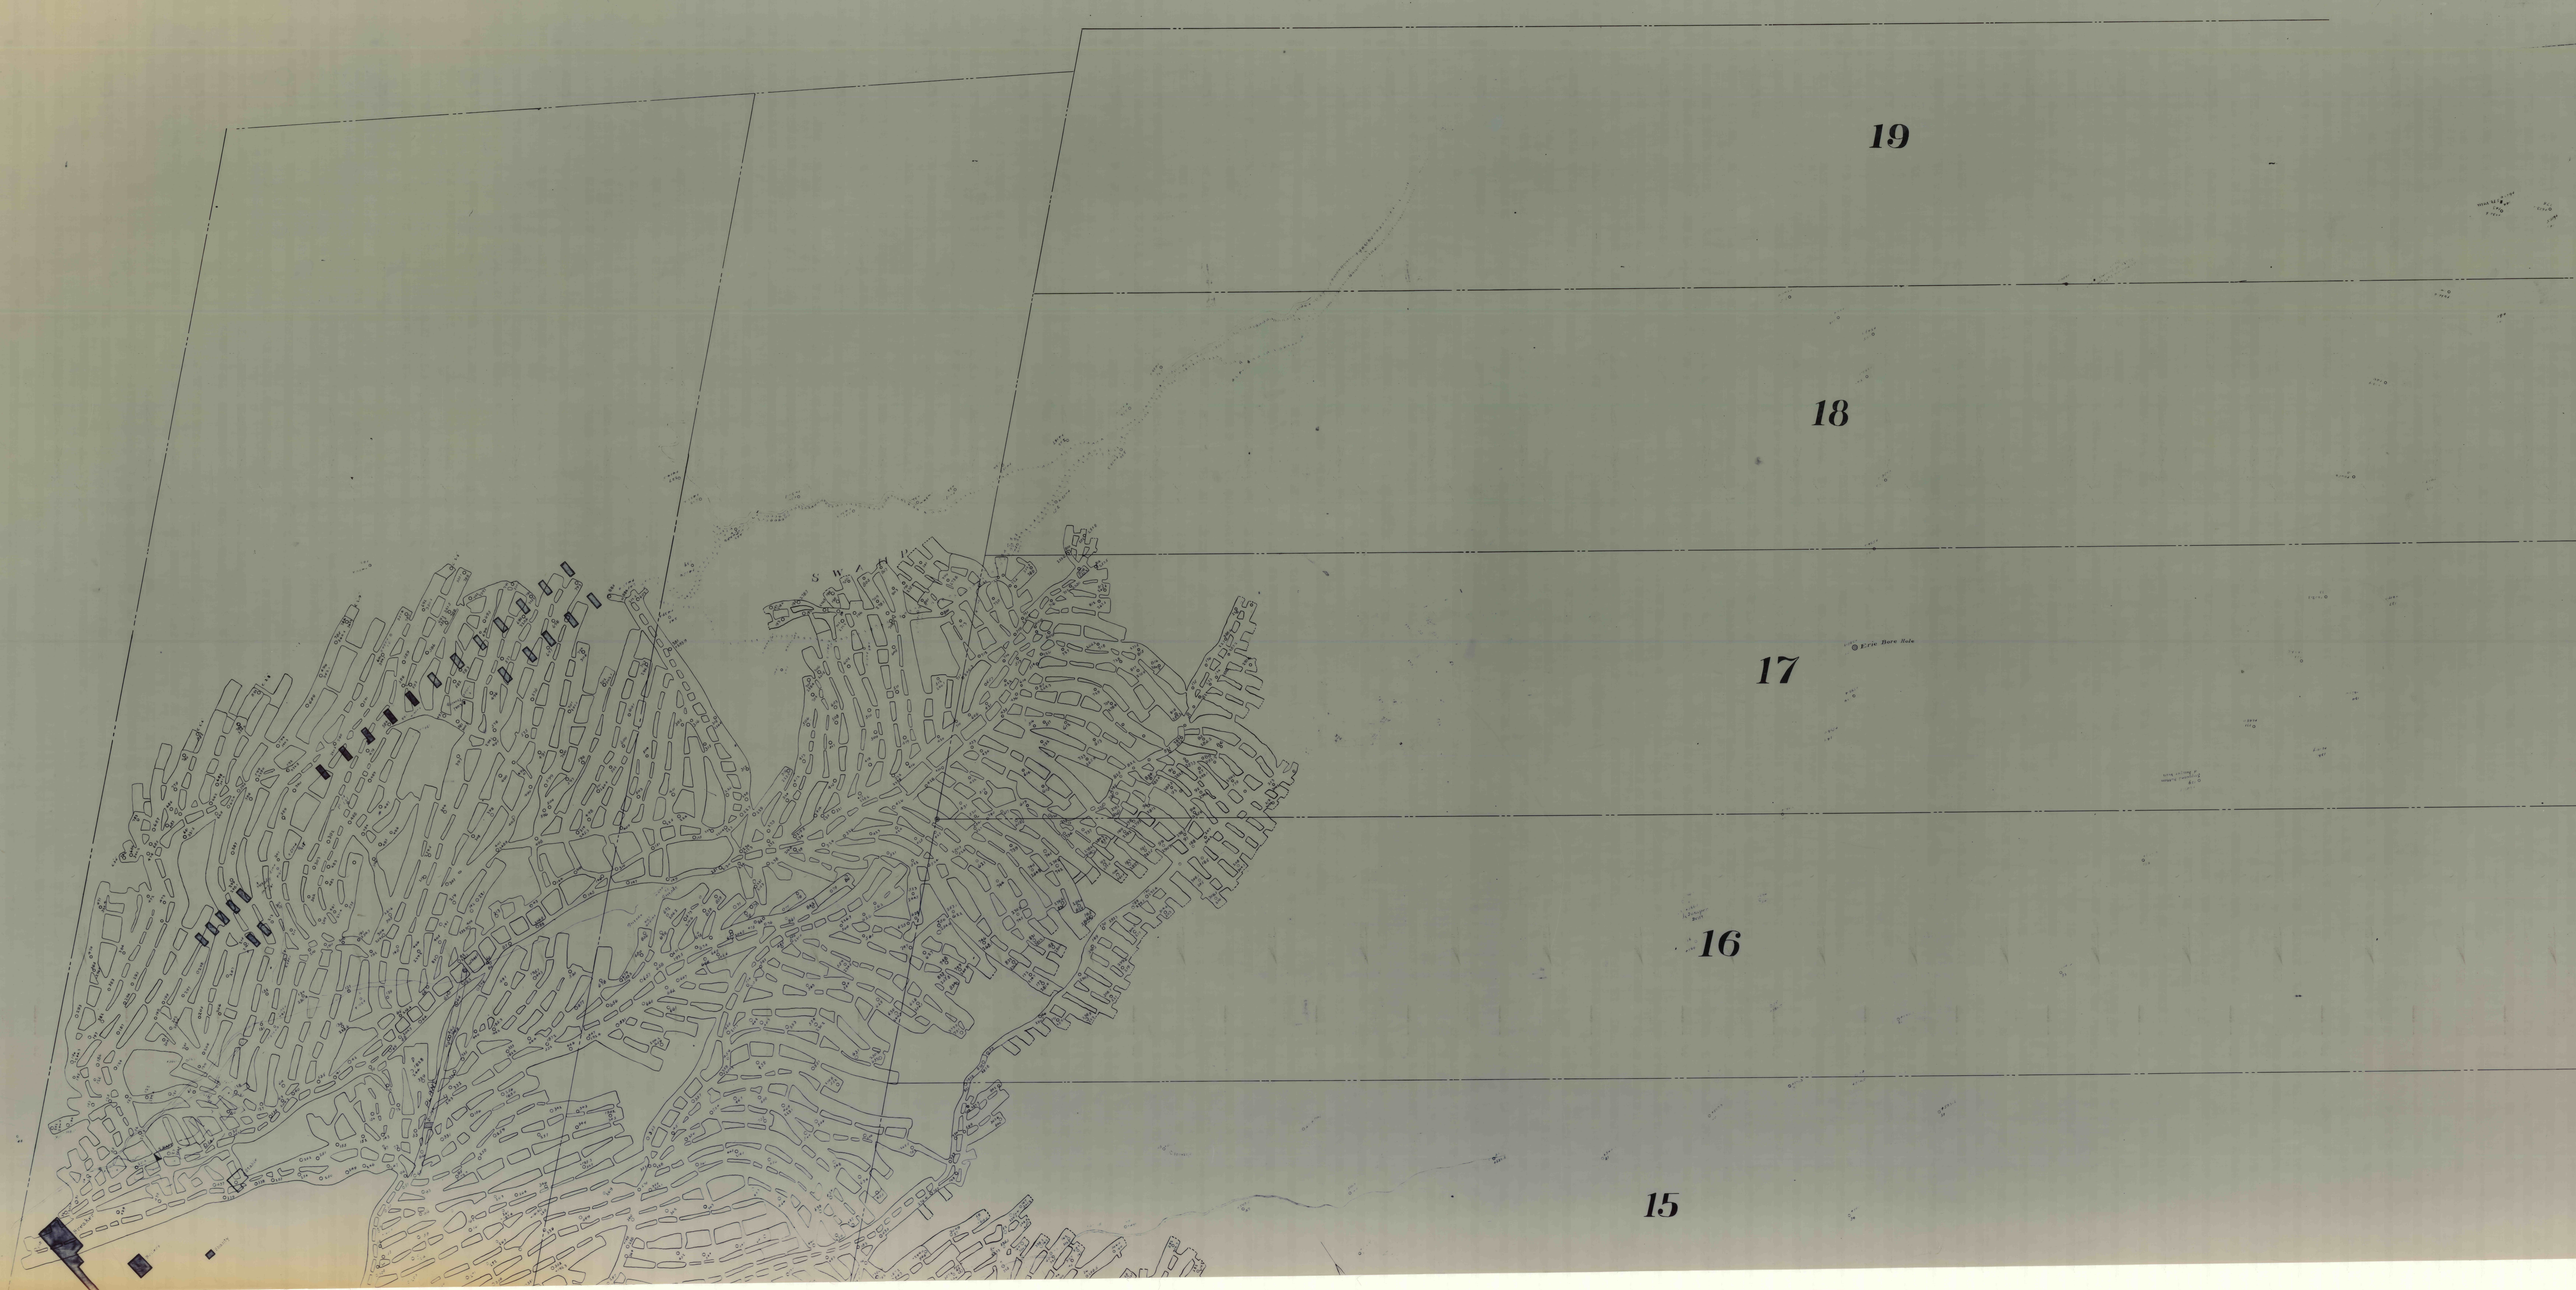
19
18
17
16
15
Erie Bore Hole