


THE HUDSON COAL CO.
OFFICE OF CONSULTING ENGINEERS
C. M. E. SURVEYOR IN
CHARGE
WILKES BARRE, PENNSYLVANIA
DATE: 3-9-17

PENNA. COAL CO.

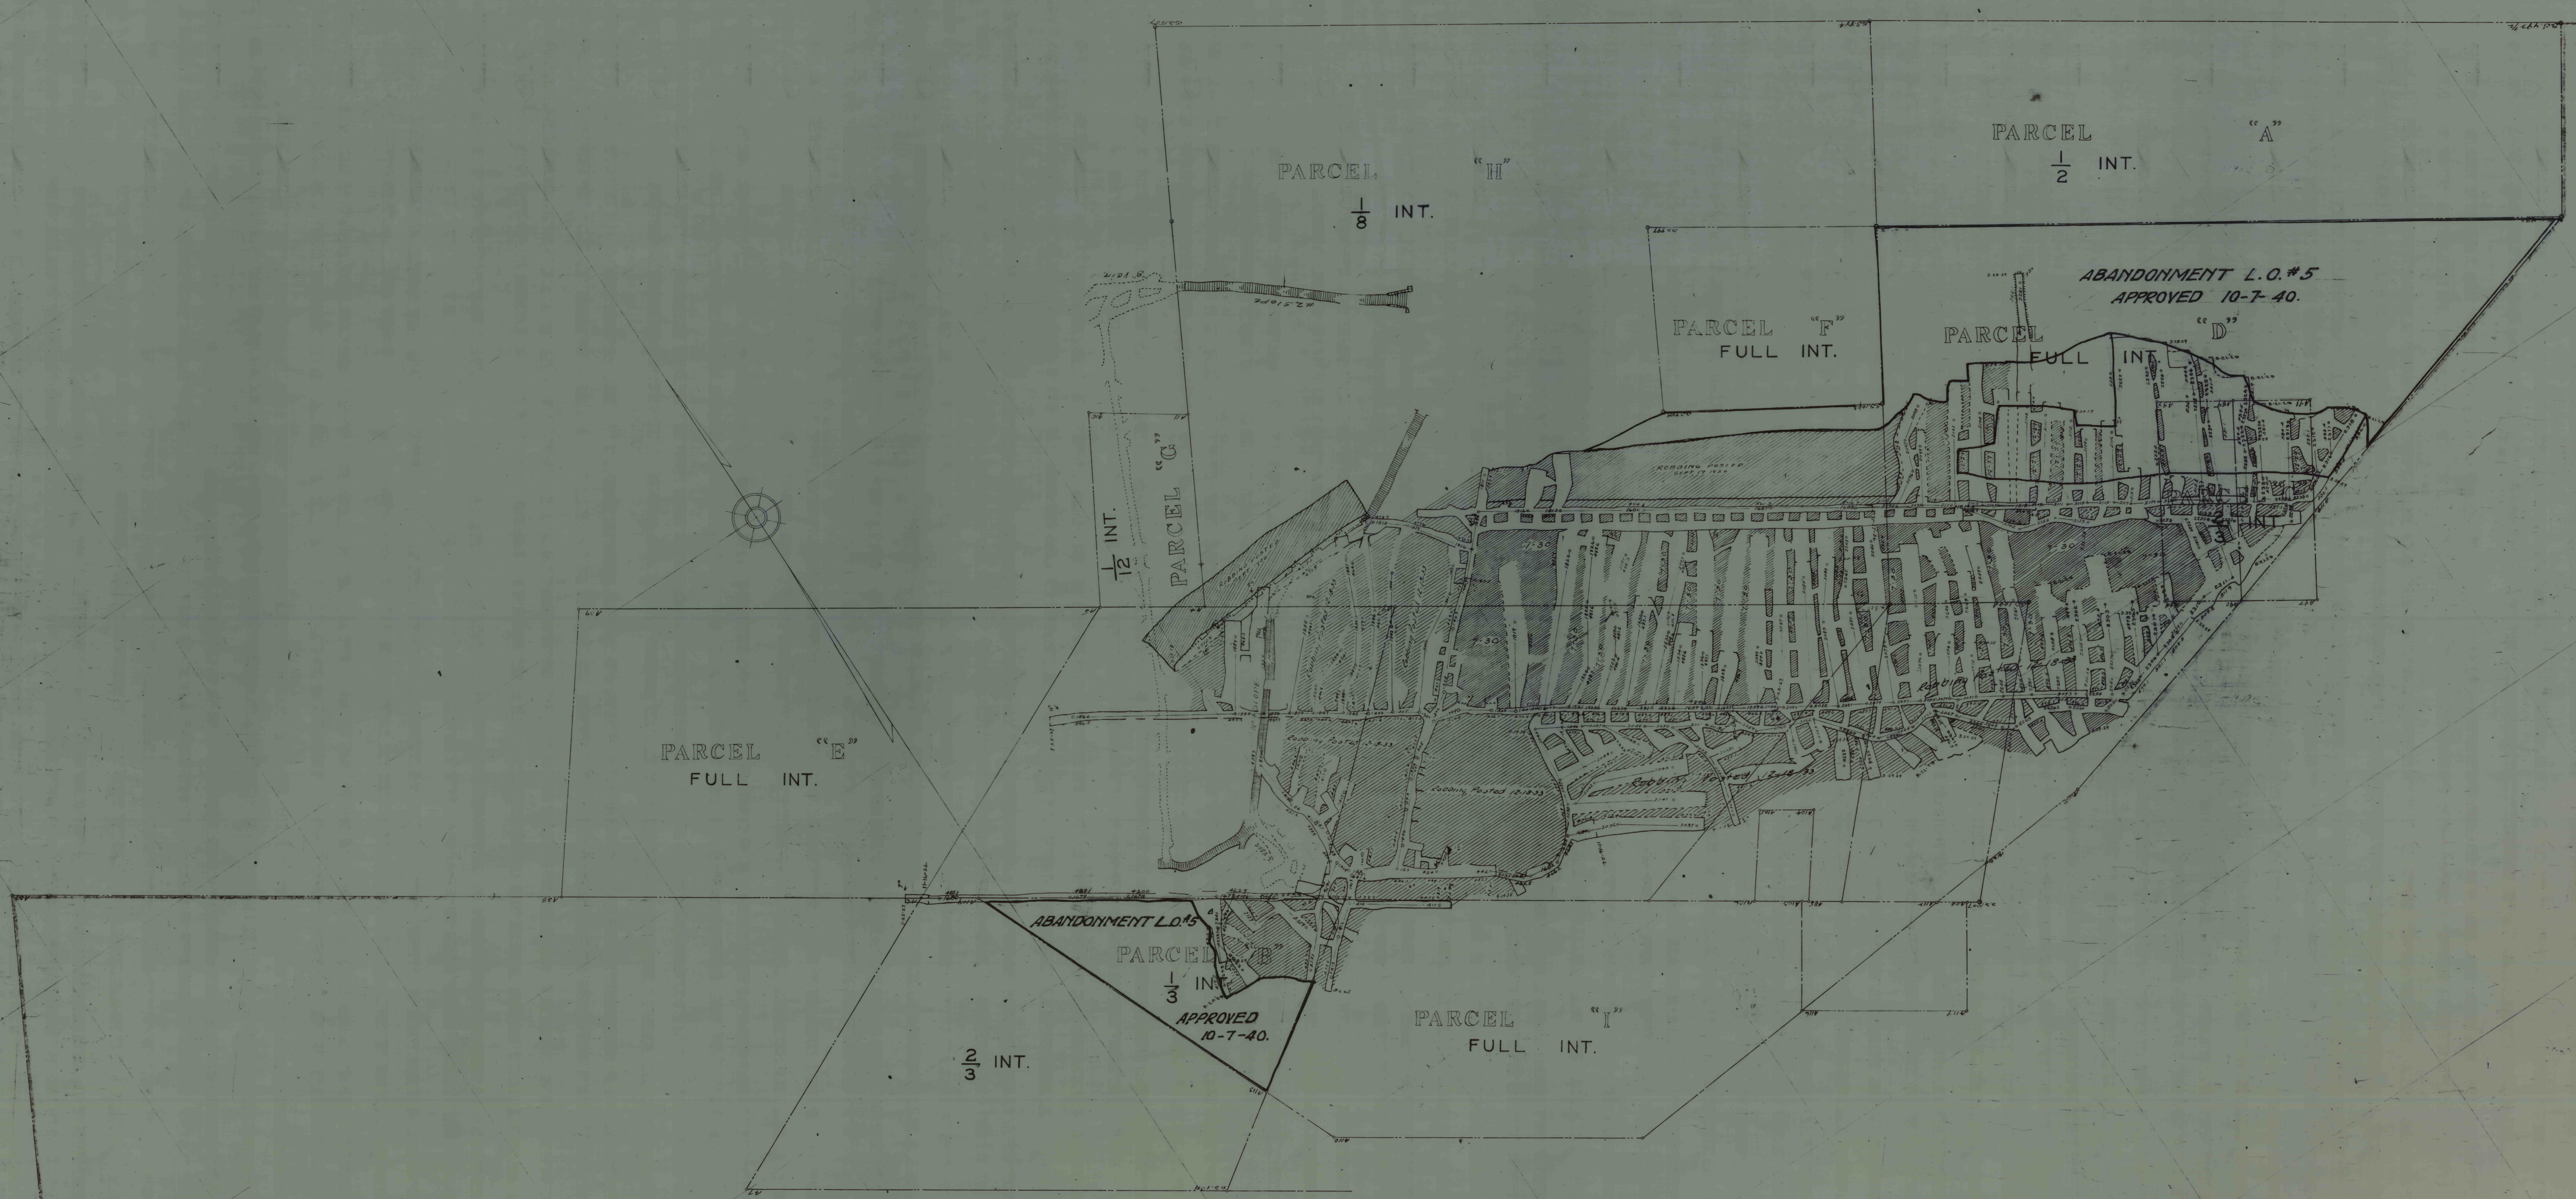

THE HUDSON COAL CO.
OFFICE OF CONSULTING ENGINEERS
C. M. E. SURVEYOR IN
CHARGE
WILKES BARRE, PENNSYLVANIA
DATE: 3-9-17
Scale 1/100' Date 3-9-17
Compiled by C. H. J. S.