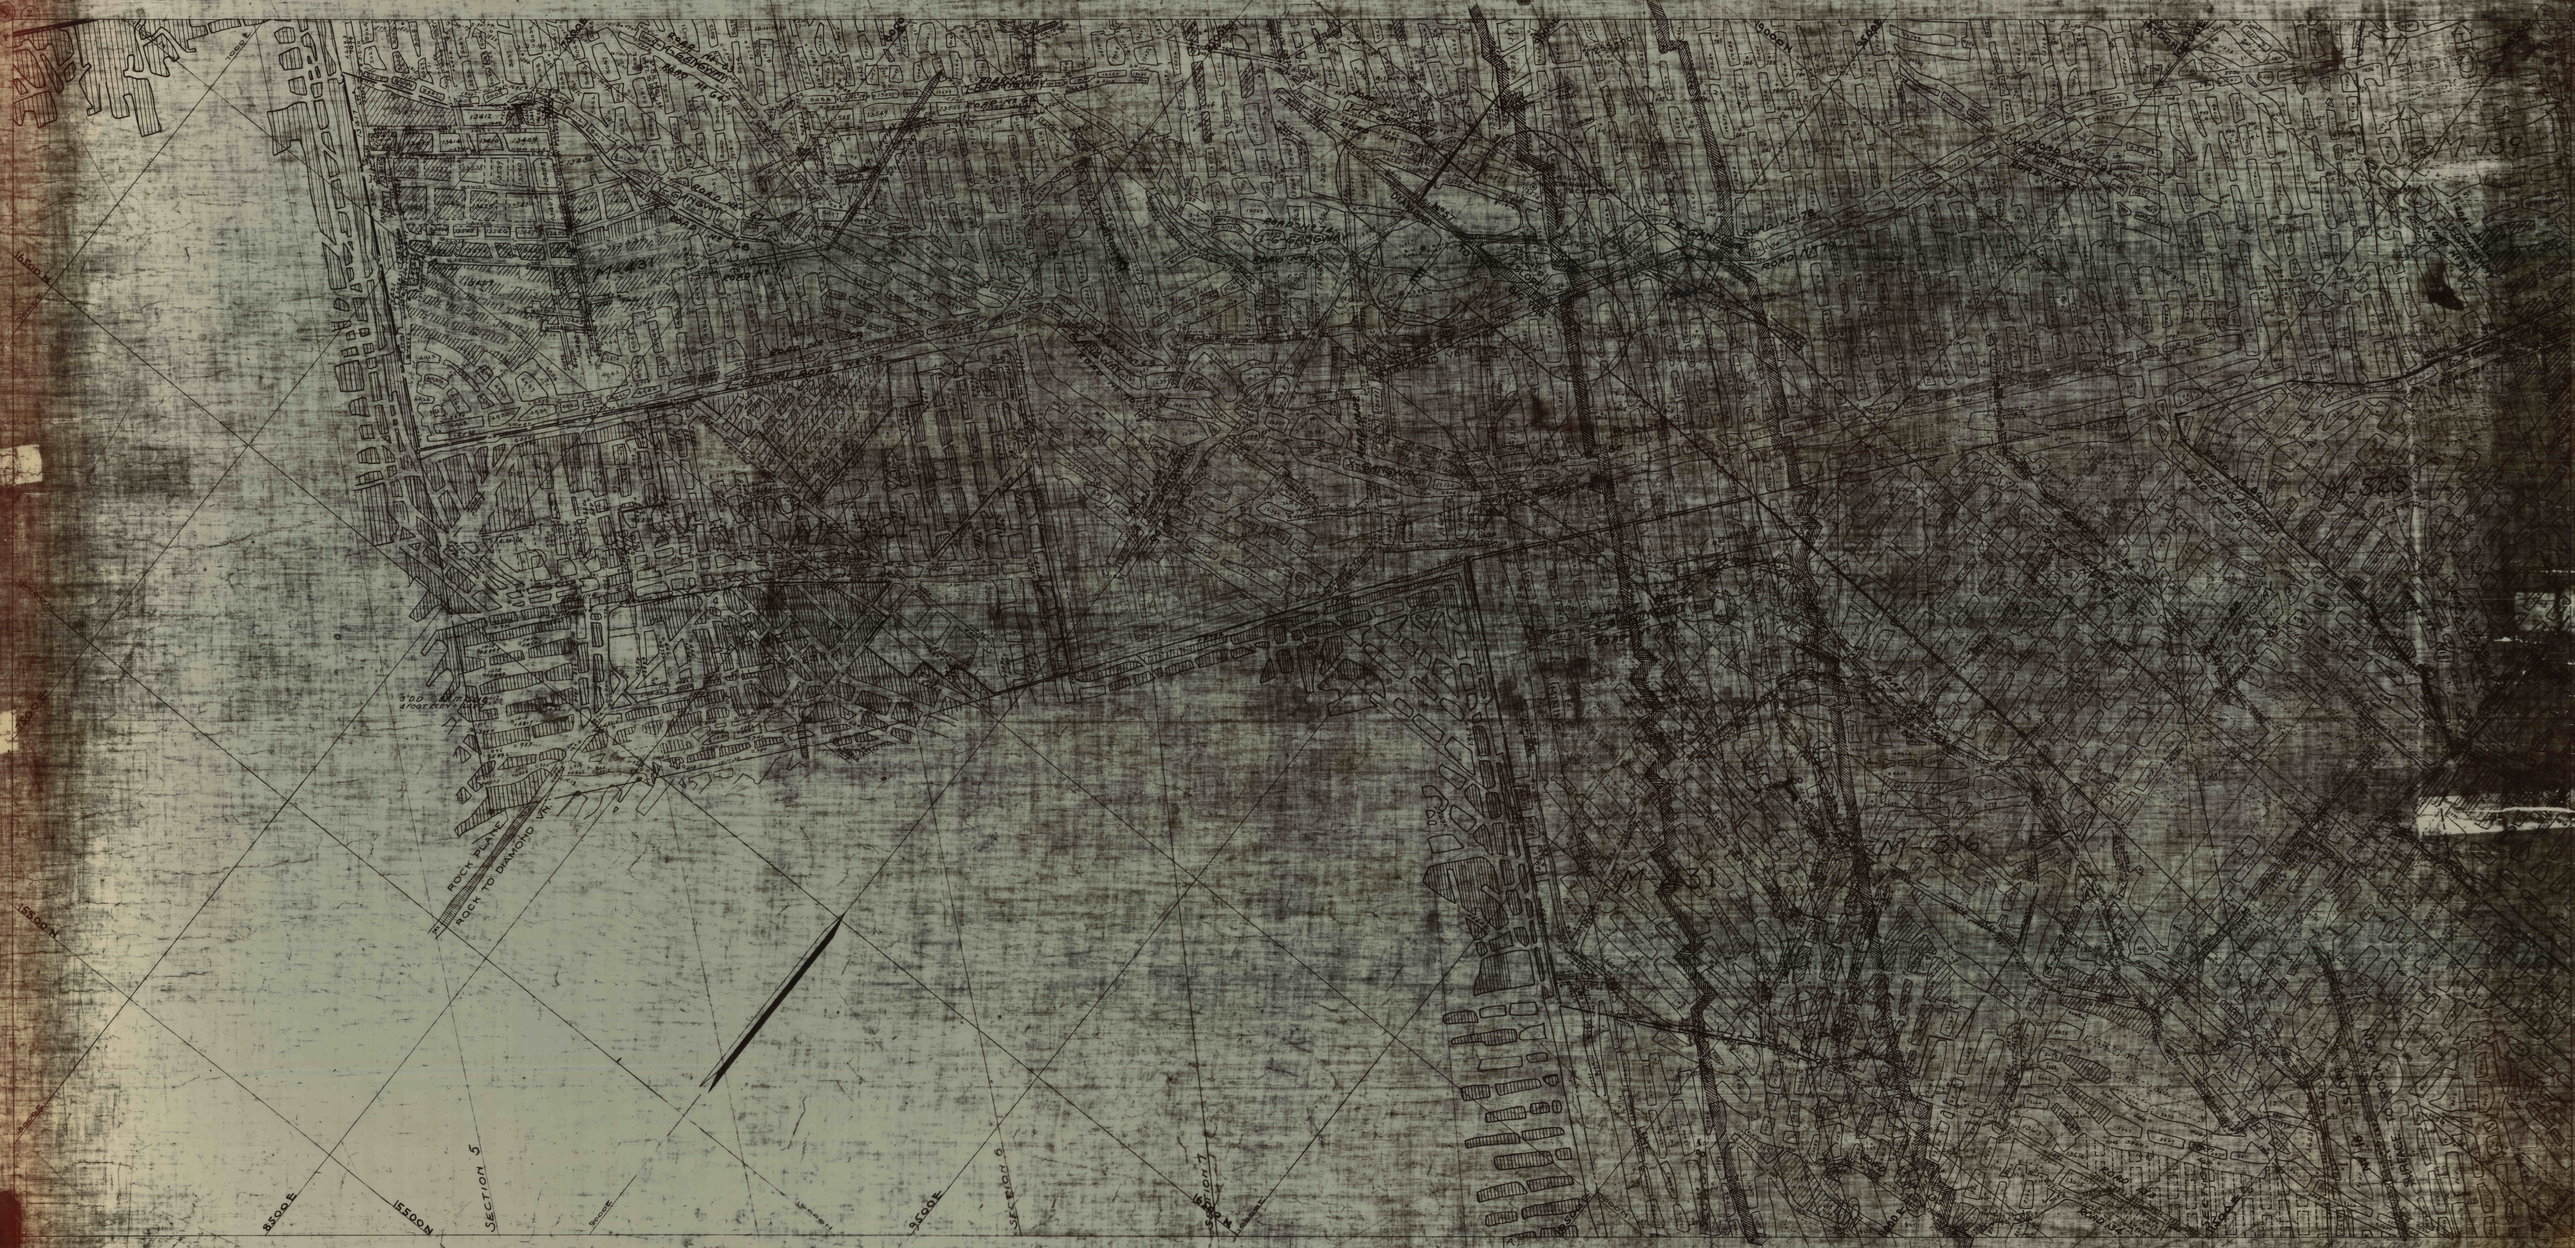
SECTION 5
SECTION 7
SECTION 9
ROCK TO DIAMOND VAL
ROCK PLANE
ROAD #179
ROAD #178
M-431
M-316
M-139
M-585
