


SEARLE & STARK.

C. S. MALTBY

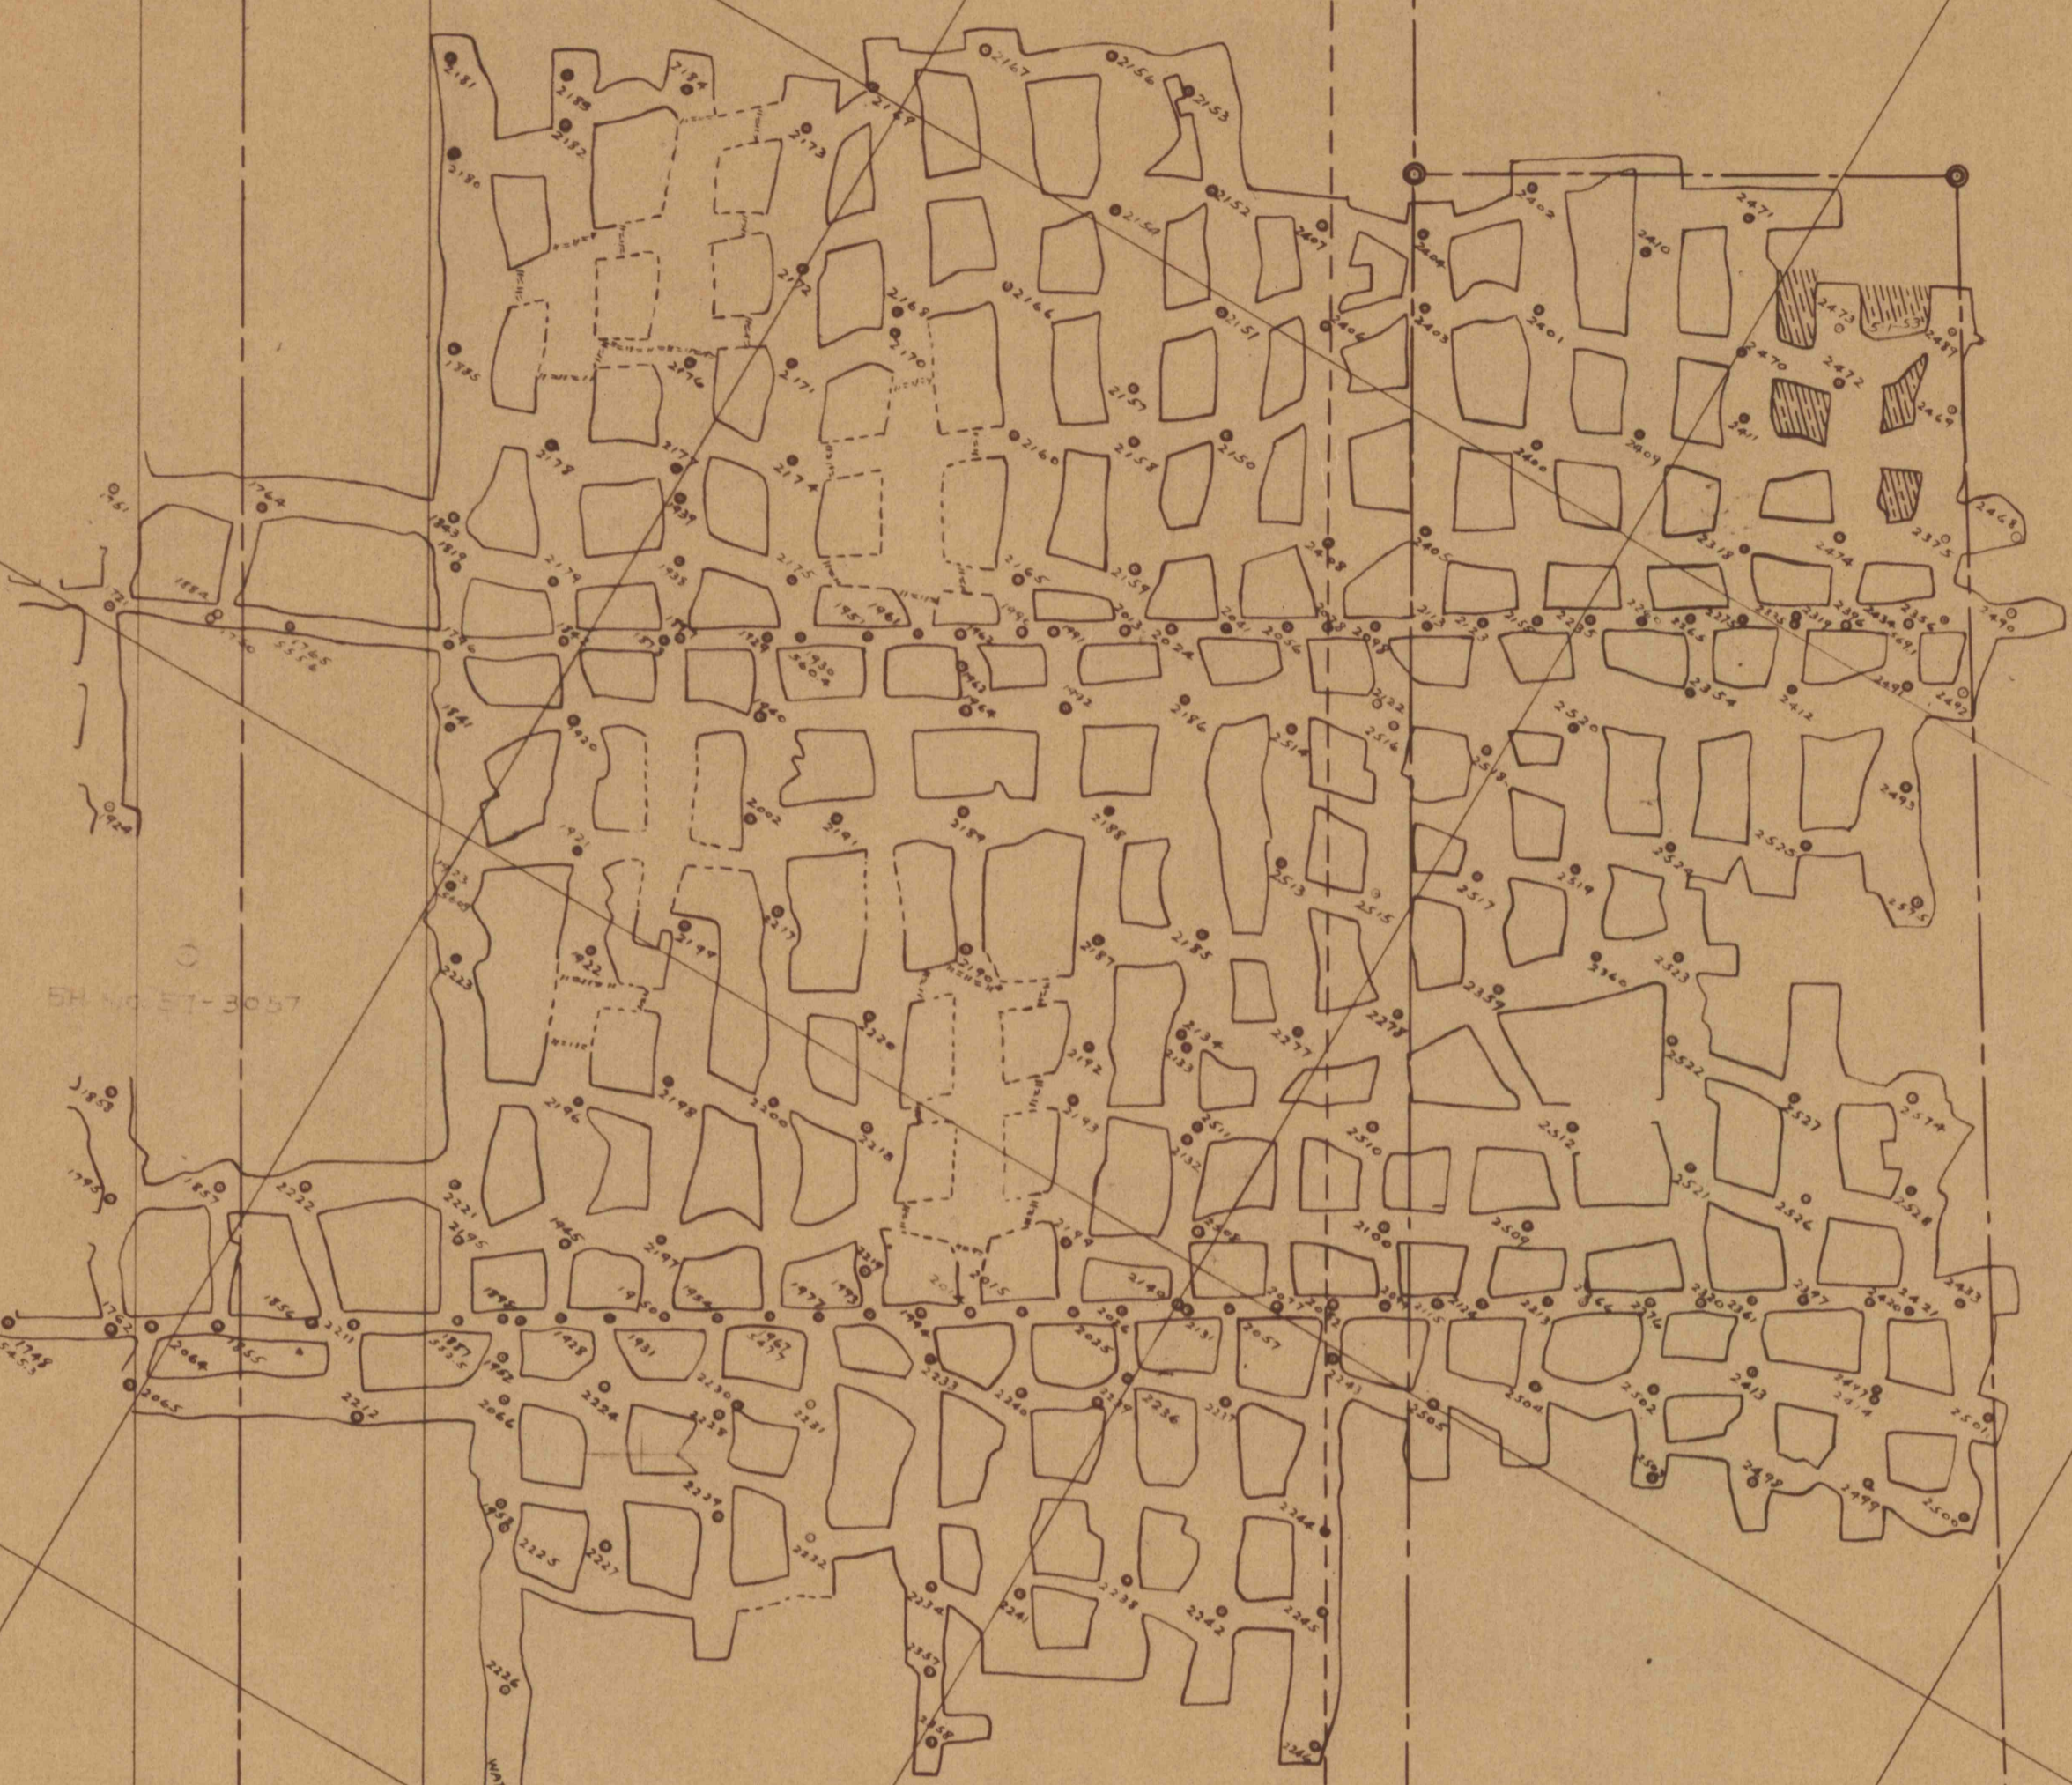

ALL MINING WORKS AND PROFILES SHOWN ON THIS
 PLAN ARE AS SHOWN IN THE ORIGINAL
 PLANS OF THE MINE.
 FLOYD G. MILCOX
 DRAWN IN 1912.

I. E. STEARNS.

C. S. MALTBY.

R. G. SHOEMAKER.

S & G. SHOEMAKER.

R. C.

SHOEMAKER.

JANE H. SHOEMAKER.

HARRY E. COAL CO.
TOP ROSS BED.
MALTBY SECTION
SHOYERVILLE, PA.
 SCALE 1"=100'
 DATUM 500 FEET BELOW MEAN TIDE.

INSPECTOR TRACING.
 EXTENDED.