

ON-14

FOOT

FIVE

TOP

MALTB

NO

14-140


MALTB

TOP

FIVE

FOOT

NO

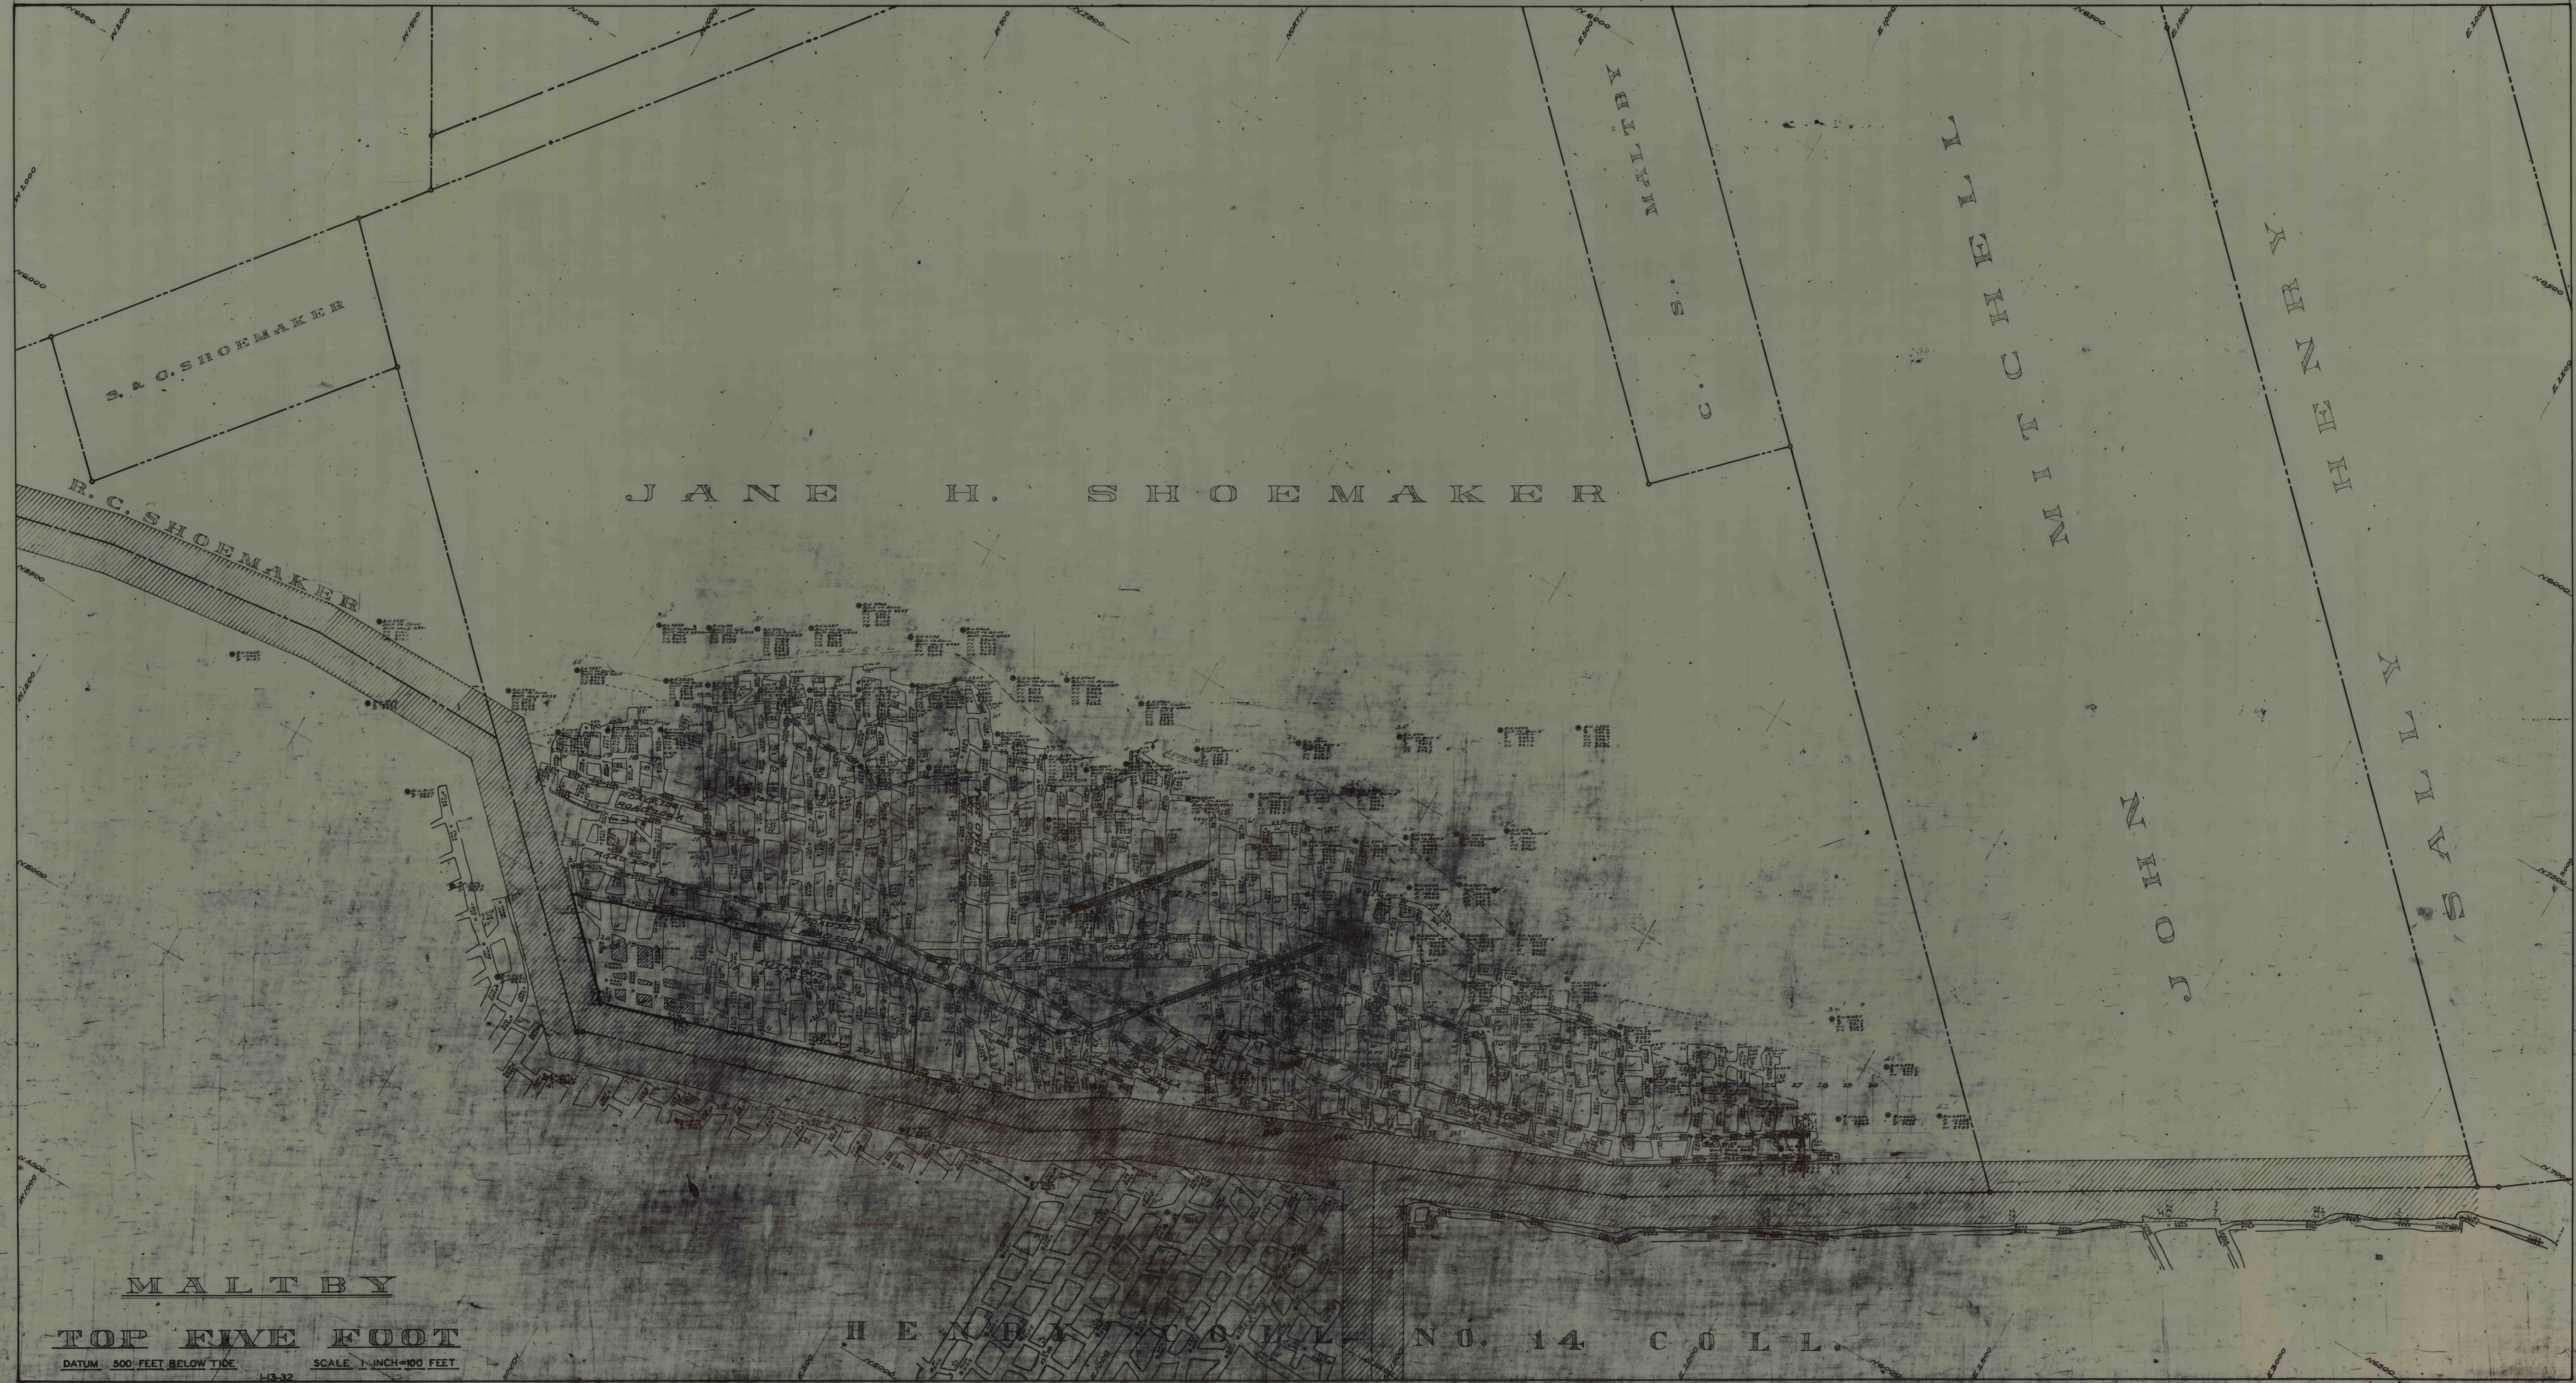

HENRY SALLAS

NO. 14 COLL.