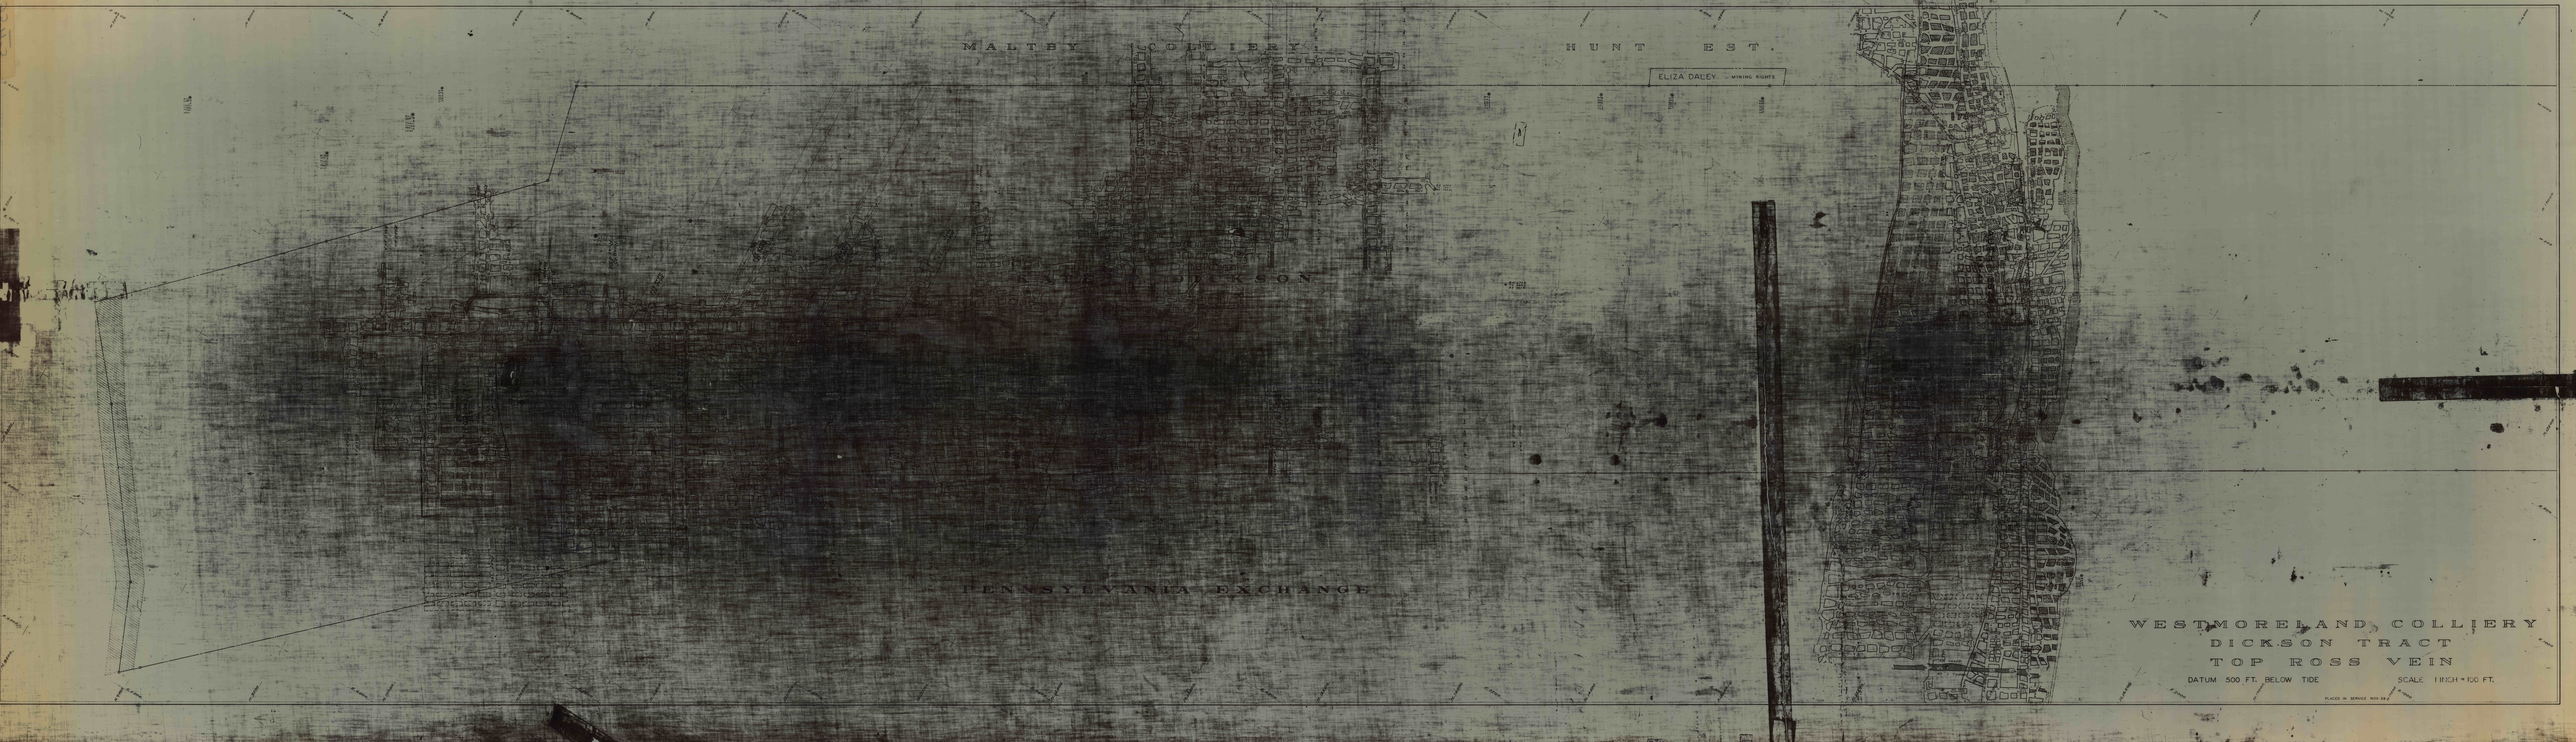
MALTBY COLLIERY
HUNT EST.
ELIZA DALEY MINING RIGHTS
PENNSYLVANIA EXCHANGE
WESTMORELAND COLLIERY
DICKSON TRACT
TOP ROSS VEIN
DATUM 500 FT. BELOW TIDE
SCALE 1 INCH = 100 FT.