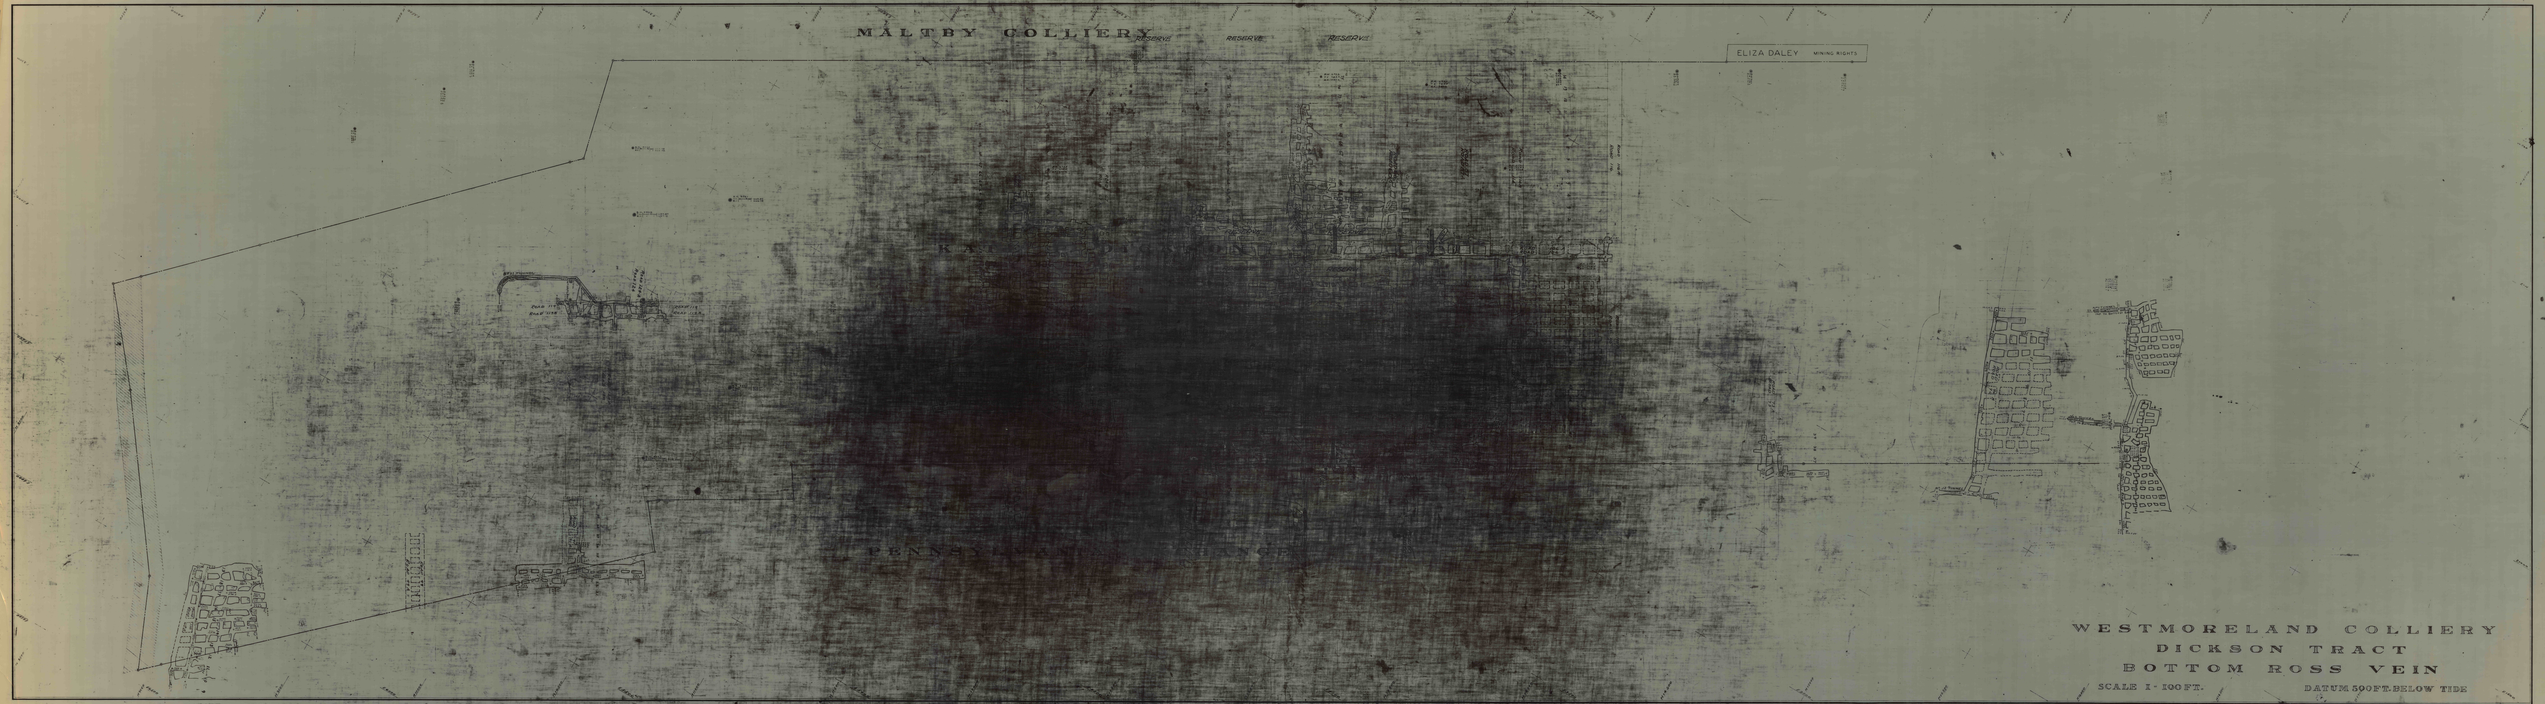

MALTBY COLLIERY
RESERVE
RESERVE
RESERVE
ELIZA DALEY MINING RIGHTS
WESTMORELAND COLLIERY
DICKSON TRACT
BOTTOM ROSS VEIN
SCALE 1" = 100 FT.
DATUM 500 FT. BELOW TIDE