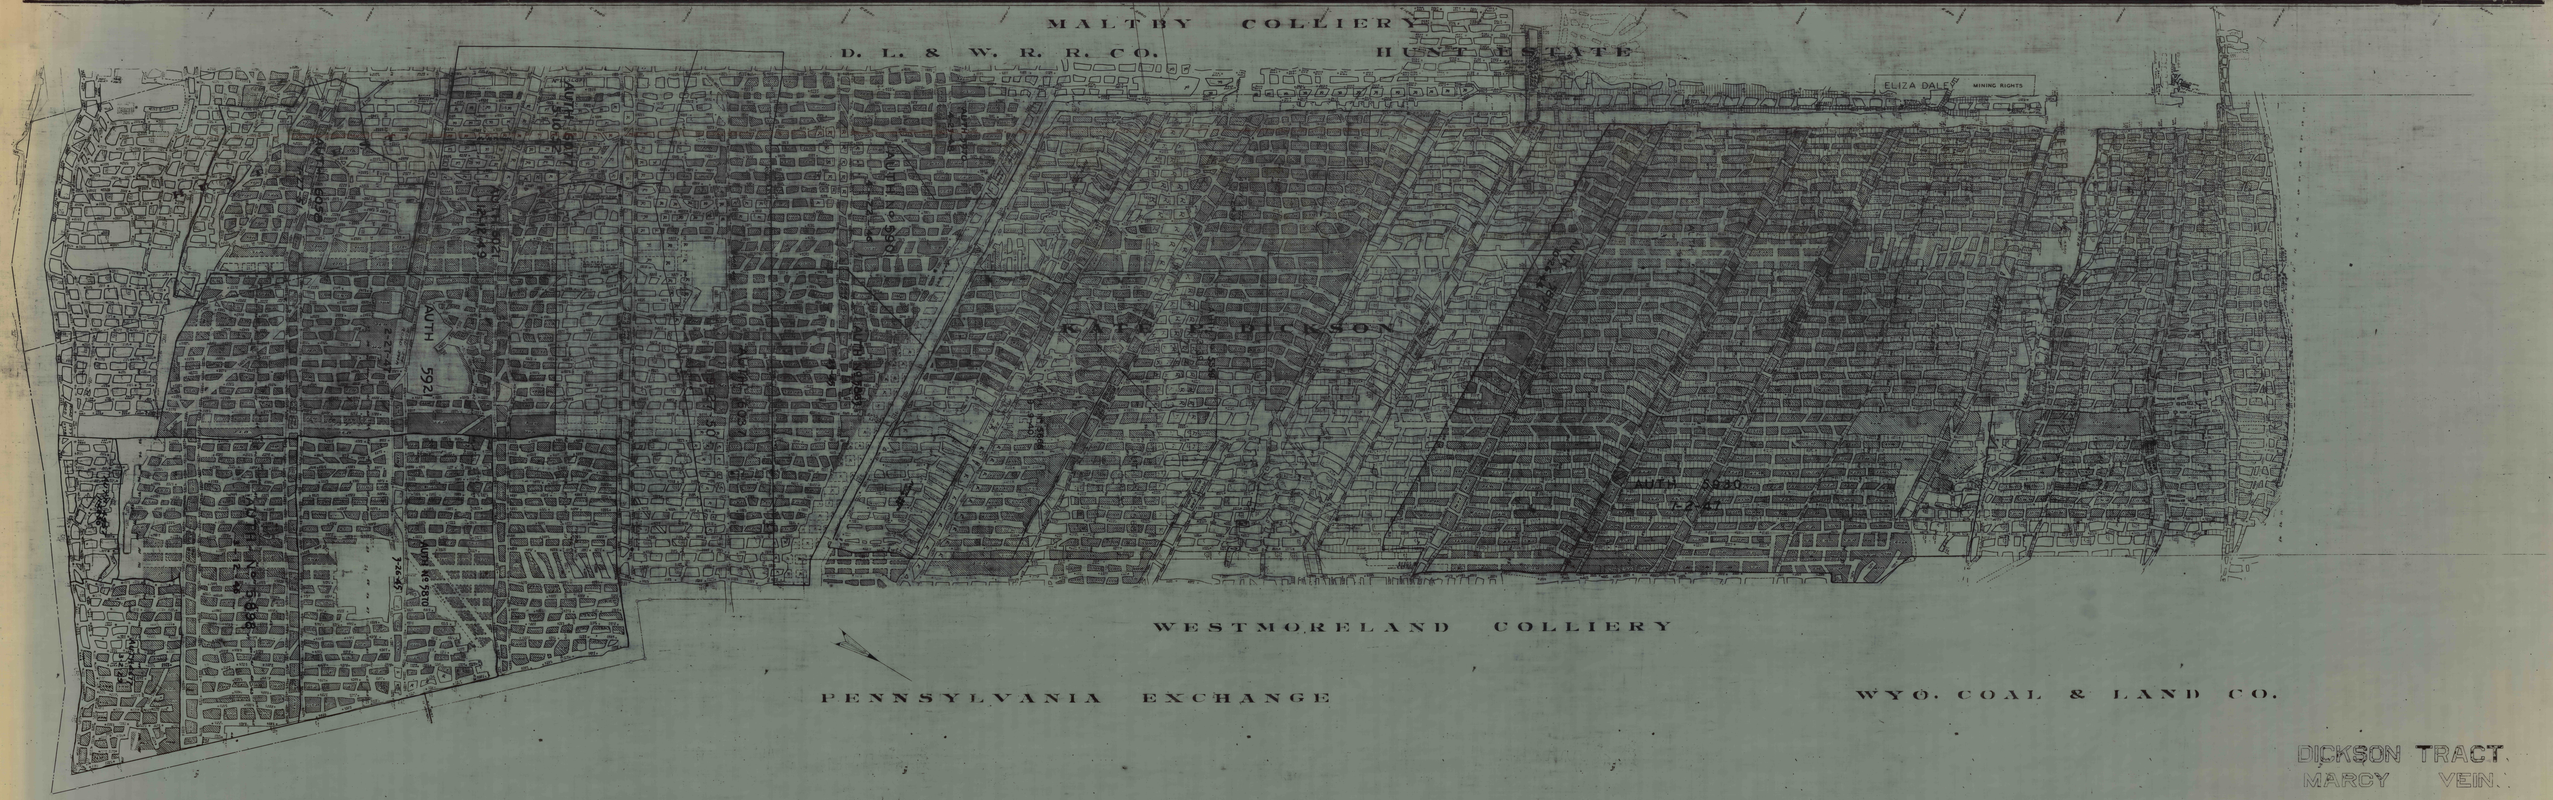
MALTBY COLLIERY
D. L. & W. R. R. CO.
HUNT ESTATE
ELIZA DALE
MINING RIGHTS
AUTH 5921
AUTH 5930
WESTMORELAND COLLIERY
PENNSYLVANIA EXCHANGE
WYO. COAL & LAND CO.
DICKSON TRACT.
MARCY VEIN.
