

R. AND F.

W. V. C. C. ET AL

L. W. PECK



HUBBARD

W HANCOCK

TRUSTEE

TEMPLE COAL CO
TO
RAUB COAL CO
PARCEL A
3.62 ACRES
ACCESSION FILE

ALONGYKE
TUNNEL
HUBBARD COAL CO
TEMPLE COAL CO
PARCEL B
3.62 ACRES
ACCESSION FILE

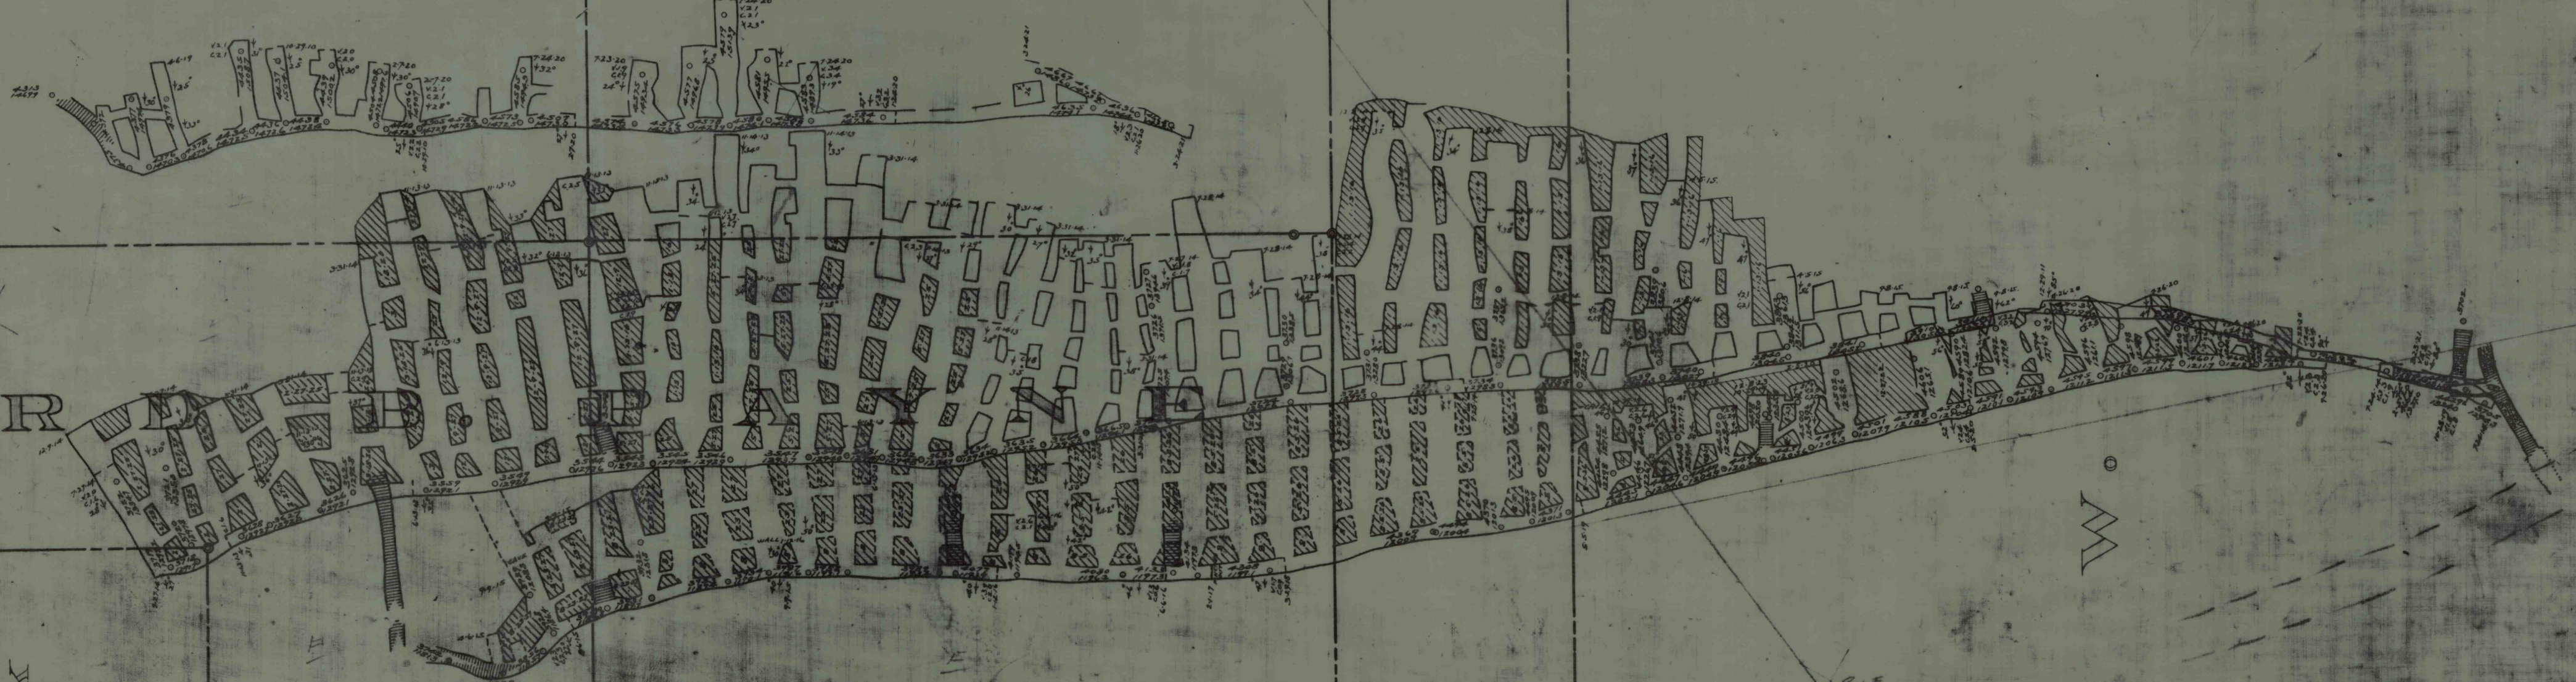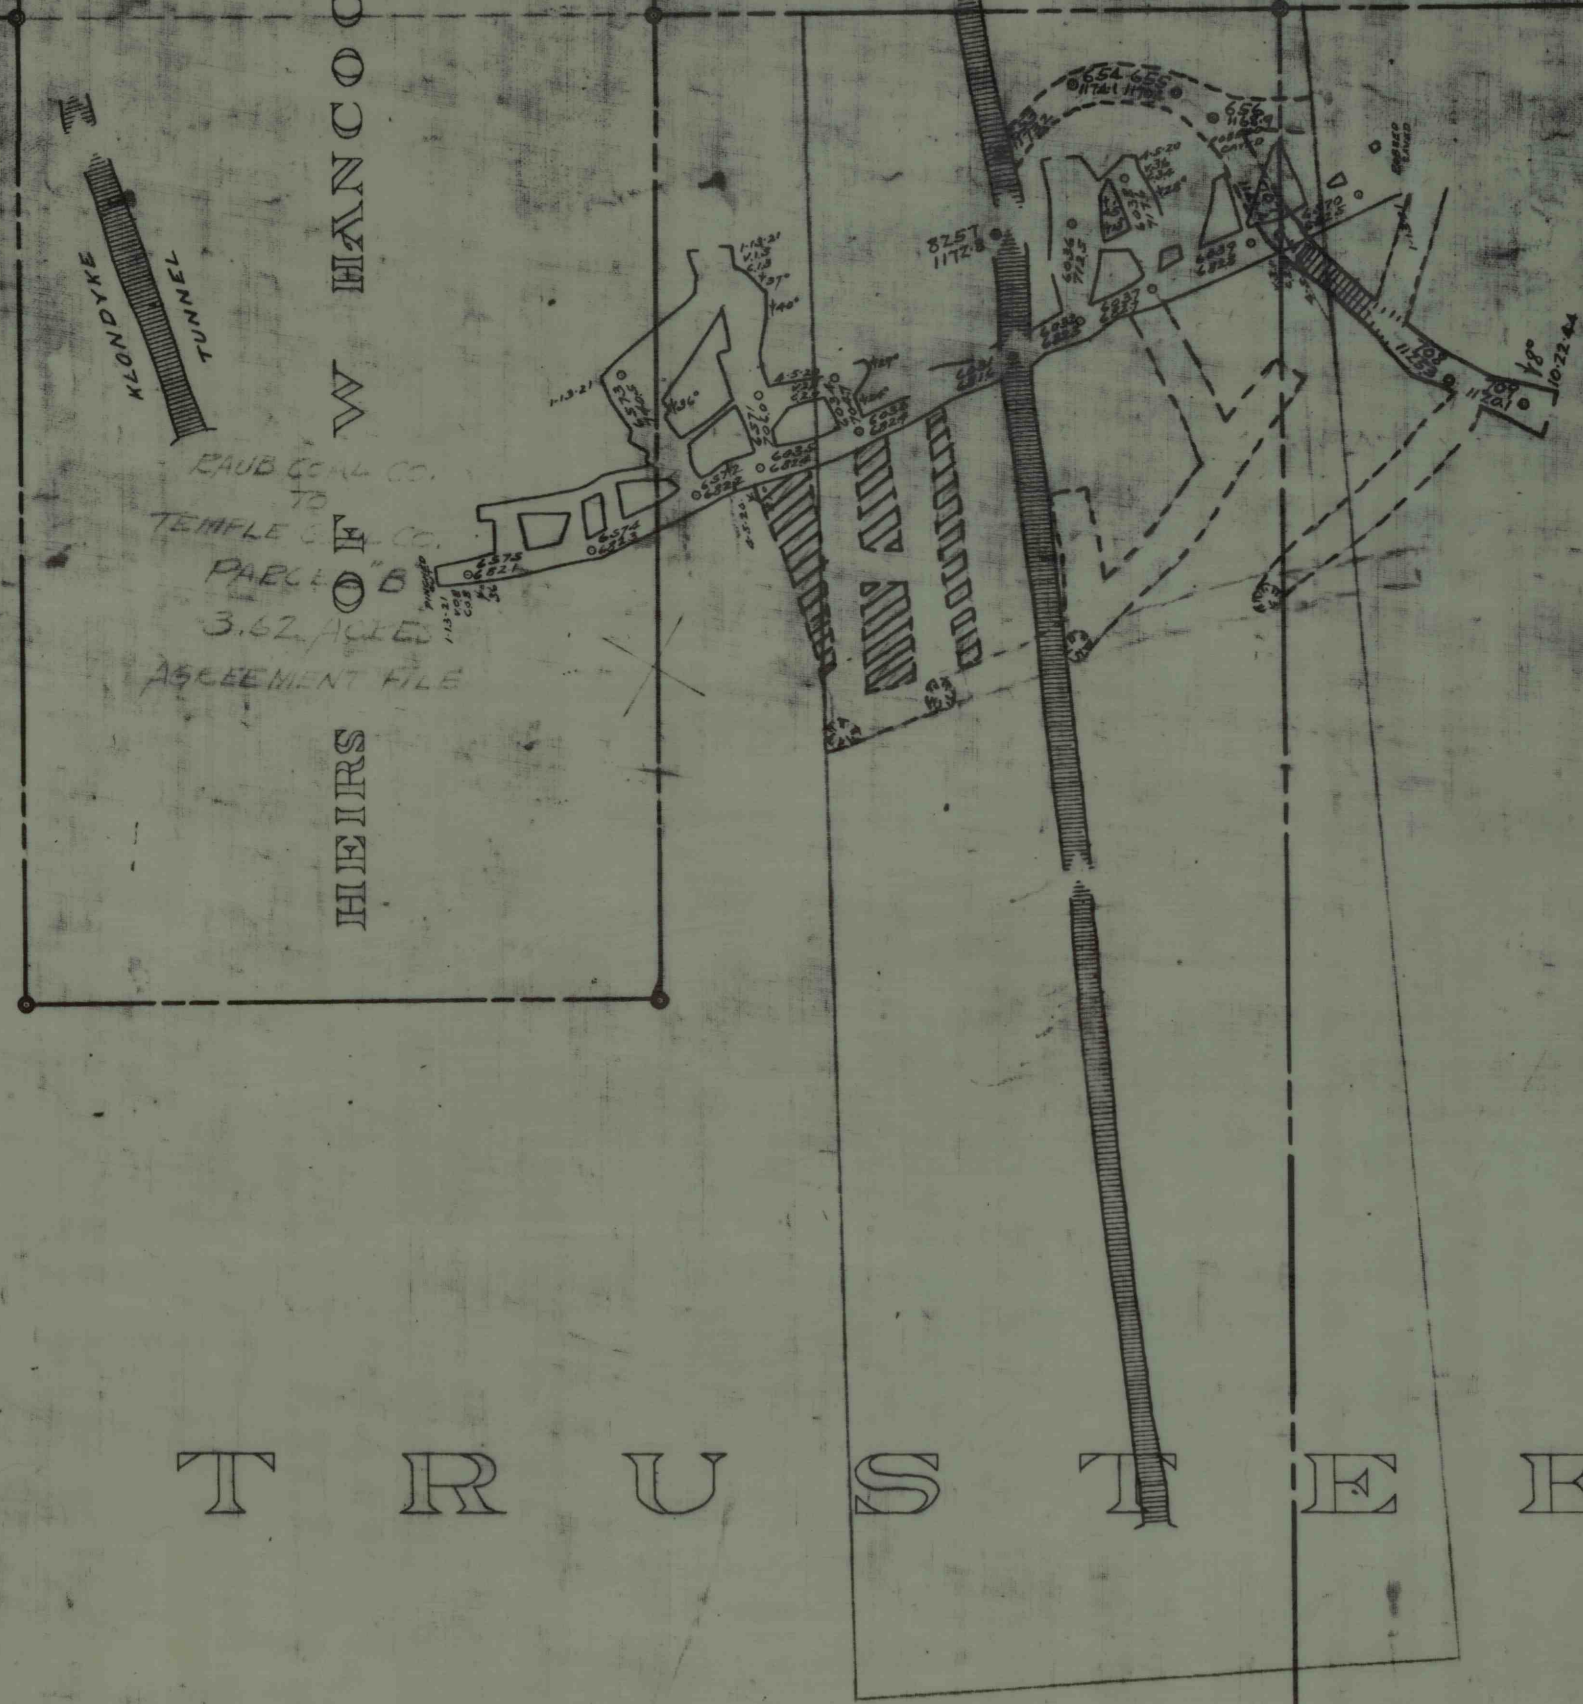

RAUBS
TOP SPLIT TOP ROSS
OR
MONKEY VEIN



